

GREENOCK DOCKYARD & LTD

MEMSHIP SECTION (AS BUILT)


L-48.

M.V. ALVA CAPE ★

Greenock Trust Entry Report No. 25003

W/S 1069

RECORDS DEPT.
LONDON


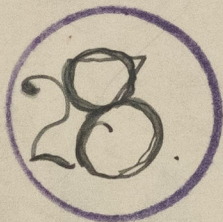


© 2020

Lloyd's Register
Foundation

005056-005060-0040

LLOYDS

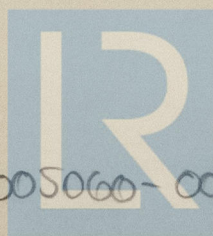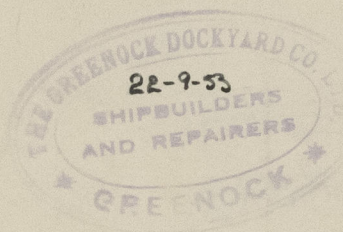

© 2020

Lloyd's Register
Foundation

005056-005060-0040