
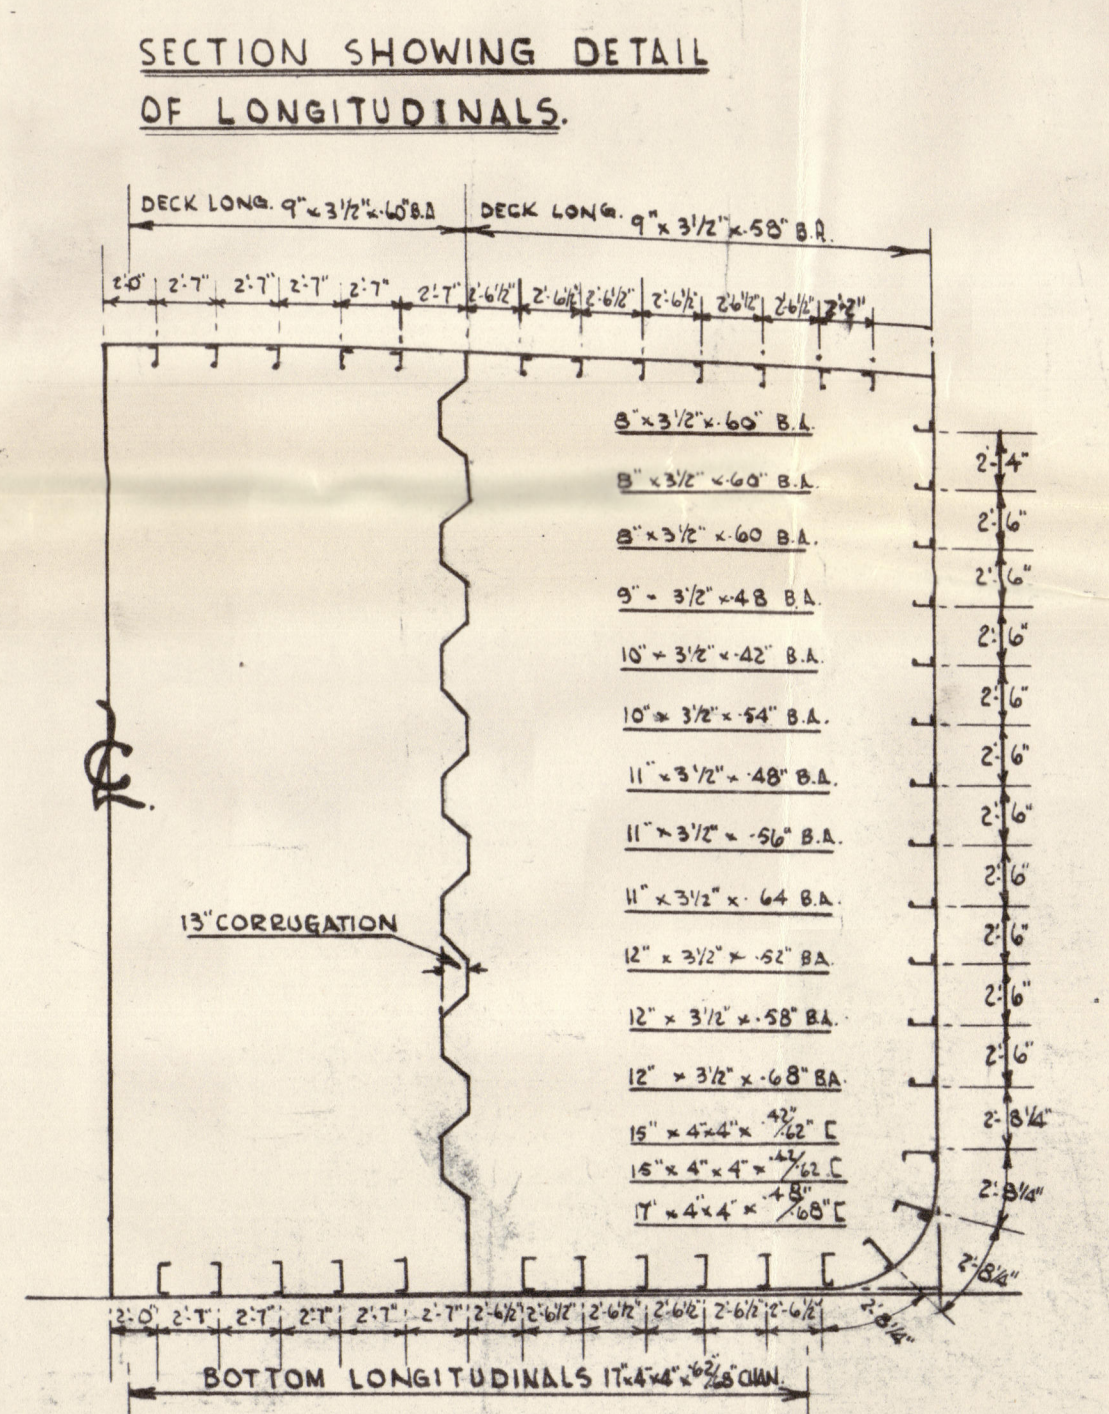


M.T. 'ALVA CAPE' PROFILE & DECKS. SCALE $\frac{1}{8}" = 1 \text{ FT.}$ DIMENSIONS - 512'-0" BP x 49'-0" BM x 38'-6" DM

 

YARD NO. 480.
 BUILT BY
 THE GREENOCK DOCKYARD CO. LTD.
 CARTS DYKE SHIPYARD, GREENOCK
 FOR
 THE ALVA STEAMSHIP CO. LTD.

GREENOCH DOCKYARD & LTO

N/A


Profile & Decks. (As Built.)

M.V. "ALVA CAVE" ★


w/s 1069

Greenock First Entry Report No. 25002

RECORDS DEPT.,
LONDON

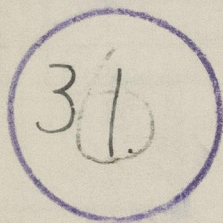



005056-005060-0041

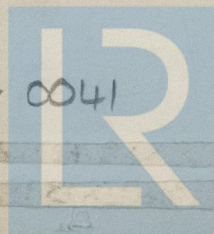

© 2020

Lloyd's Register
Foundation

LLOYDS

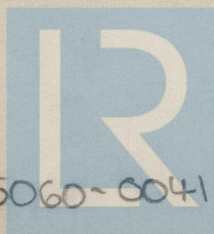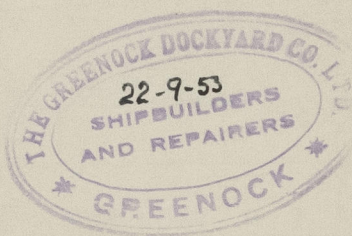

© 2020

Lloyd's Register
Foundation

005056 - 005060 - 0041