

Verifications

Report. No. 149

Index No. 27909  
(For London Office only).

# Lloyd's Register of Shipping.

## SURVEYS FOR FREEBOARD.—STEAM SHIPS.

PARTICULARS RELATING TO ALL STEAM SHIPS WITH  
TOP GALLANT FORECASTLES, SHORT POOPS AND BRIDGE HOUSES DISCONNECTED,  
THE TOP GALLANT FORECASTLES HAVING LONG POOPS OR  
CONNECTED WITH THE DECK HOUSES.

J. Coughlan & Sons now "Attivita" of Savona  
Pursel No. 9 Ship's Name VALDARNO  
"War Columns"

Master Book

LENGTH.	BREADTH.	DEPTH.	UNDER DECK TONNAGE.
410.6	54.0	24.5	5148.28
	54.18		
			including peaks
			Moulded Depth as measured..... 29.9"
			Frame Depth 10 Ceiling +.20 Peak F
			Rule .6 Sheer +1.38 Tanks AP
410.0			4.2 = -1.66 Drop in tank
			4.2 - 1.66 = +.16
			Drop in tank 27.16
410.0	53.44	29.28	28.90
			including peaks
			Thickness..... 50.81
			on necessary .02
			to (e)* .02
			Corrected 46.79

the length from Stem	70	{	111 ÷ 2 = 55.5 Mean
Sternpost	71	{	55.5 + 55.5 = 100.9
Sheer allowed	100.9		
In Sheer [Table, Para. 18]	51.0		Correction
Difference.....	49.9	÷ 4 = 12.44	
as Para. 18 (f) .....		-12.44	

At front of bridge house.....	v
At after end of forecastle .....	v
Sheer {	
(d) { v ÷ 2 =	v
Covered .....	v
	Correction

ALLOWANCE FOR DECK ERECTIONS :-		
Table C.....	4.4	4.34
for Length, if required (Para. 12, 13 and 14)		+ 1.34
by Table A, corrected for sheer, and for length, if required (Para. 12, 13 and 14)	4.4 - 2.699	2.34
below.....	29.75 + 32.08 = 9.54	32.08%
	100	9.62

for R. Q. Dk. if engine and boiler openings not covered by bridge house (Para. 11)	v
for Deck Erections .....	- 9.54

Length.	Length allowed.	Height.
47.0	47.0	8.0
use 114.75	114.75	8.0
Q. Dk.		v
43.75	43.75	8.0
Total	205.50	= 501
of Ship	410.00	
onding percentage 12, 13, 14)	32.08%	

BOARD recommended amidships from centre of Disc to top of Statutory Deck Line, V (Iron) Deck :-

Fresh Water Line	above centre of Disc
Indian Summer Line	" " "
Winter Line	below "
Winter North Atlantic Line	" "

If the frames, skin planking, or ceiling are of unusual thickness the breadth of vessel to inside of ceiling should be reported if possible.  
In vessels obtaining an allowance for deck erections under Para. 11 where the sheer drops abaft amidships the height of the R.Q.D. is to be taken from the level of the top of the amidships beam.  
In flush-decked vessels the total standard mean sheer means the sheer measured at the stem and stern-post. In vessels having poops and forecastles, it means the sheer measured at points distant one eighth of the vessel's length from stem and stern-post.

Port of Survey Vancouver, B.C.

Date of Survey 17th June 1919

Name of Surveyor John. Whitehead

NOTE.—If the depth is measured when vessel is afloat, the details of measurement should be reported.

Particulars of Classification. 10001 Class Contemplated

Moulded Depth as measured..... 29.9"  
including peaks

Addition for Keel below base line for draught record 2.70 inches.

## CORRECTION FOR LENGTH.

Length of Ship on Loadline..... 410.0'  
Length in Table ..... 354.0'  
Difference ..... 56.0'  
Correction for 10ft., Table A. .... 1.5' Table C. .... 8'  
x Difference divided by 10 ..... 7.95' (if required.) 4.24'  
If  $\frac{1}{10}$ ths length covered divide by 2 + 8' + 4.4' ✓

## CORRECTION FOR IRON DECK.

Proportion covered, if less than  $\frac{1}{10}$ ths length covered ..... 50.1'  
Thickness of usual wood deck, less stringer ..... 3.5 x 50.1 = 1.75 - 1.34 ✓

## CORRECTION FOR ROUND OF BEAM.

Breadth at Gunwale amidships..... 54.0'  
Round of Beam ..... 13.2'  
Normal round ..... 13.2'  
Difference ..... ✓ ÷ 2 = ✓  
Proportion of Deck uncovered (Para. 19) ..... 49.9

NOTE.—The round of beam should be reported on the full breadth of vessel at the gunwale.

Freeboard, Table A ..... 7-6.45 7-6.34  
Correction for Sheer ..... 12.47 - 1.03  
6-6.28 6.53 6.64  
9.95 + 8  
9-2.23 7-7.23 7-7.23  
9.62 - 9.23  
6-4.61 6-4.61 6-4.61  
Correction for Round of Beam ..... ✓

Correction for fall in Sheer (if any) ..... ✓  
Correction for Iron Deck (if required) ..... - 1.3 6.23  
Additions for non-compliance with provisions of Para. 11 (d) and (e) } } ✓  
Other Corrections (if any) ..... ✓

Winter Freeboard ..... 6.23 6.23  
Summer Freeboard ..... 5.93 5.93  
Indian Summer Freeboard ..... 5.43 5.43  
N. A. Winter Freeboard ..... ✓

Correction necessary because clearside amidships, measured in accordance with the Statute is not taken at the intersection of the iron deck with side. + 1.3 ✓

Winter Freeboard from deck line ..... 6.43 6.43  
Summer " " " ..... 5.11 5.11  
Indian Summer " " " ..... 5.67 5.67  
N. A. Winter " " " ..... 5.11 5.11

State dimensions of freeing port area on back of this form.  
The Surveyor should state whether the fall in sheer as reported is measured relatively to the straight line of keel or to the water line. If measured relatively to water line the vessel's draft at time of survey, and also the usual load draft forward and aft should be reported.

Do all the Frames extend to the top height in the Poop? Yes  
 Raised Quarter Deck? ✓  
 Bridge House? Yes  
 Forecastle? Yes  
 To what height do the Reverse Frames extend? ~~to upper deck~~ alternately to Forecastle Bridge & Poop decks except after peak  
 Has the Poop or Raised Quarter Deck an efficient Iron Bulkhead at the fore end? Yes where they extend to upper deck  
 Give particulars of the means for closing the openings in Bulkhead Steel Hinged doors  
 Is the Poop or Raised Quarter Deck connected with the Bridge House? No  
 Has the Bridge House an efficient Bulkhead at the fore end? Yes  
 Give particulars of the means for closing the openings in Bulkhead W. S. Steel Hinged doors  
 What is the thickness of the Bridge Front plating? .40 and Coaming plate? .40  
 Give scantlings and spacing of the Stiffeners 8" x 3½ x 3½ x 24.1" lbs spaced 30"  
 Are bracket plates fitted at each end of the Stiffeners? Large Angle Lugs Are hor'l. brackets fitted connecting Bridge Bulk'd. with Bulwarks? Yes  
 Has the Bridge House an efficient Iron Bulkhead at the after end? Yes  
 How are the openings closed? Steel doors bolted & stormboards in riveted channels full height of openings  
 Is the Forecastle at least as high as the main or top-gallant rail? Yes  
 Has the Forecastle an efficient Iron Bulk'd. at after end? Yes  
 Are the Engine and Boiler openings covered by a Bridge, Poop, Raised Quarter Deck, or enclosed by a Strong Iron or Steel Deckhouse? by Bridge House  
 If the openings are not so protected are the exposed parts of the Casings efficiently constructed? ✓  
 Give thickness of plating; scantlings and spacing of Stiffeners ✓  
 What is the height of the exposed Casings? ✓ Are suitable means provided for closing all openings in them in bad weather? ✓  
 Are the Weather Deck Hatchways efficiently constructed and at least equal to the requirements of Section 28 of the Rules for 1904-5? Give particulars below: ✓

Position and Size.		90-1-31-6 x 21-0	90-2-31-6 x 21-0	90-3-15-9 x 14-0	90-4-31-6 x 21-0	90-5-31-6 x 21-0		
Item.	Ship.	Rule.	Ship.	Rule.	Ship.	Rule.	Ship.	Rule.
COAMING. Height above top of DECK	36"	36"	36"	36"	30"	30"	36"	36"
Thickness { Sides.....	.50	.50	.50	.50	.50	.50	.50	.50
Thickness { Ends.....	.50	.50	.50	.50	.50	.50	.50	.50
SHIFTING BEAMS OR WEB PLATES.	Number .....	5	5	5	3	5	5	5
	Section and Scantlings .....	17½" x .36 plate 4" x 3" x 9.8" D.E.R. 2	Do	Do	17½" x .36 plate 4" x 3" x 9.8" D.E.R. 2	Do	Do	17½" x .36 plate 4" x 3" x 9.8" D.E.R. 2
	Material .....	Steel			Steel			Steel
* FORE AND AFTERS.	Number .....	nil	nil	nil	nil	nil	nil	nil
	Section and Scantlings .....							
	Material .....							
HATCHES Thickness .....	3	3	3	3	3	3	3	3
Remarks.....	good	good	good	good	good	good	good	good

\* The depth of Fore and Afters should be stated from the underside of the hatches in all cases.

(If the sill of the lowest side scuttle will be less than 6 inches above the Indian Summer Load Line if assigned under the tables, state vertical distance from top of deck at side amidships to lower edge of lowest side scuttle.)

The following information is to be given in all Cases of vessels dealt with under Paras. 11, 12 (under 15 feet Moulded depth) and under Shelter Deck Rules.

What is the thickness of the Bridge Sheerstrake?

Strake between Main and Bridge Sheerstrakes?

Delete the words { The Crew are, are not, berthed in the bridge house.

that do not apply { The arrangements to enable them to get backwards and forwards from their quarters are, are not satisfactory.

Length of Bulwarks in well

Area of Freeing Ports required by Para. 11 (e) each side of vessel

Ft. Tenth. Ft. Tenth. No.

x      x  
x      x


Freeing Ports (each side of vessel) =

Sq. ft.

x      x  
x      x

Total deficiency or excess =

Sq. ft.

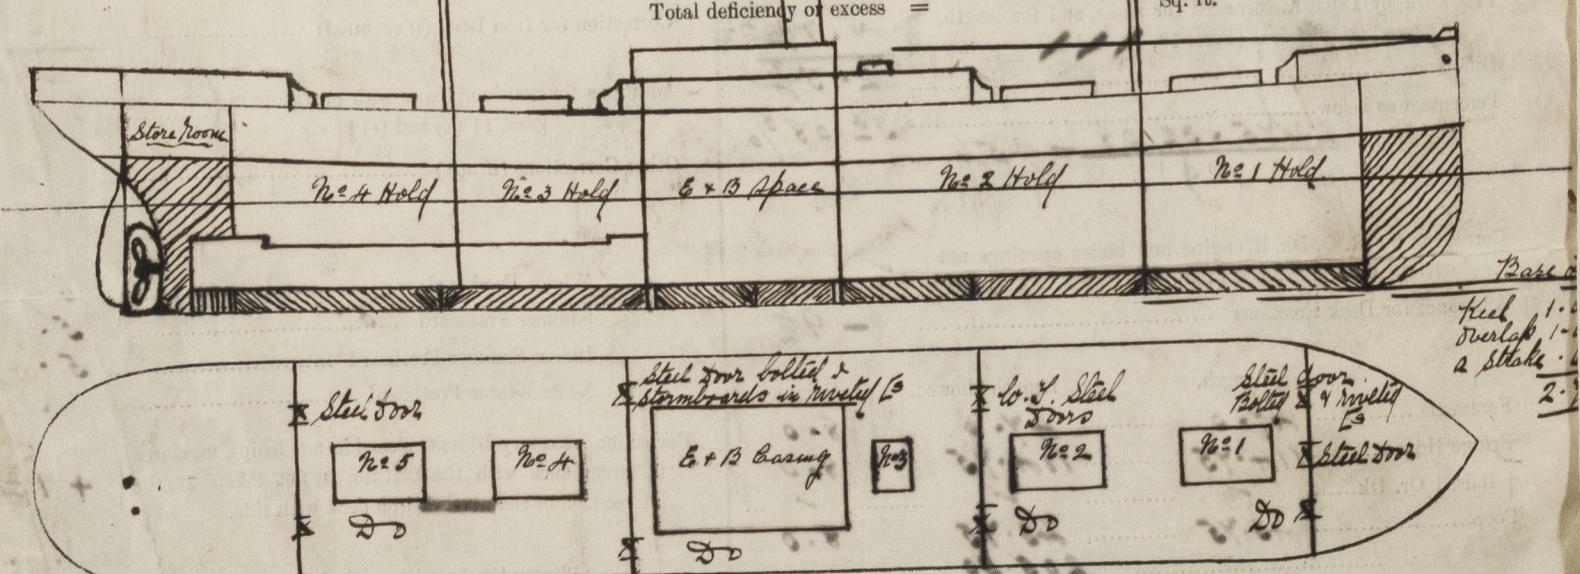

Show hereon line of Floors or Tank Top with position of any Breaks in same; also height of Peak Tank tops, &c., &c.

State any special features in the construction of the Vessel

This vessel is constructed with prop. bridge & forecastle decks. Transverse framing 10" depth of girder. A request form is herewith attached. See Vancouver Grubboard report 90-432 of sister vessel 2202 War Cavalry Owners Imperial Munition Board (Many Owners) Messrs. Raeburn & Geral 2202  
Address Glasgow & Liverpool

Fee \$ 50 00

Received by me