

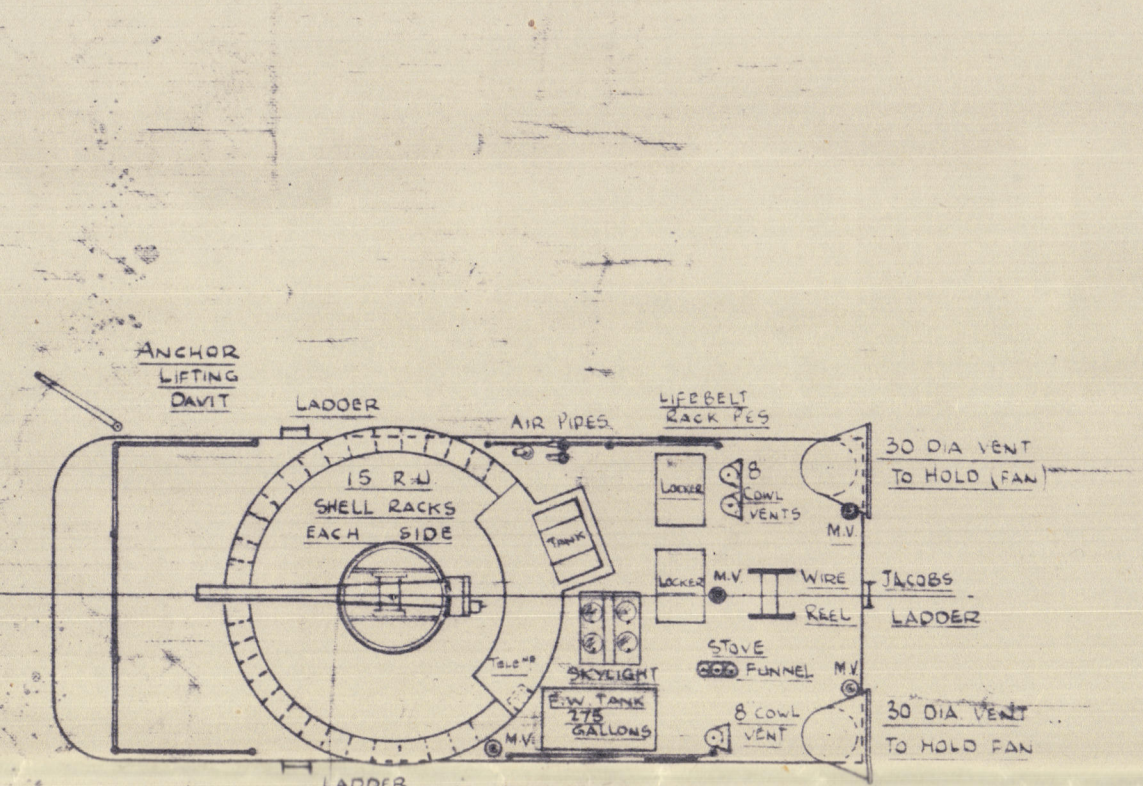


AS FITTED 1941.


SCALE 1/8" = 1 FOOT.

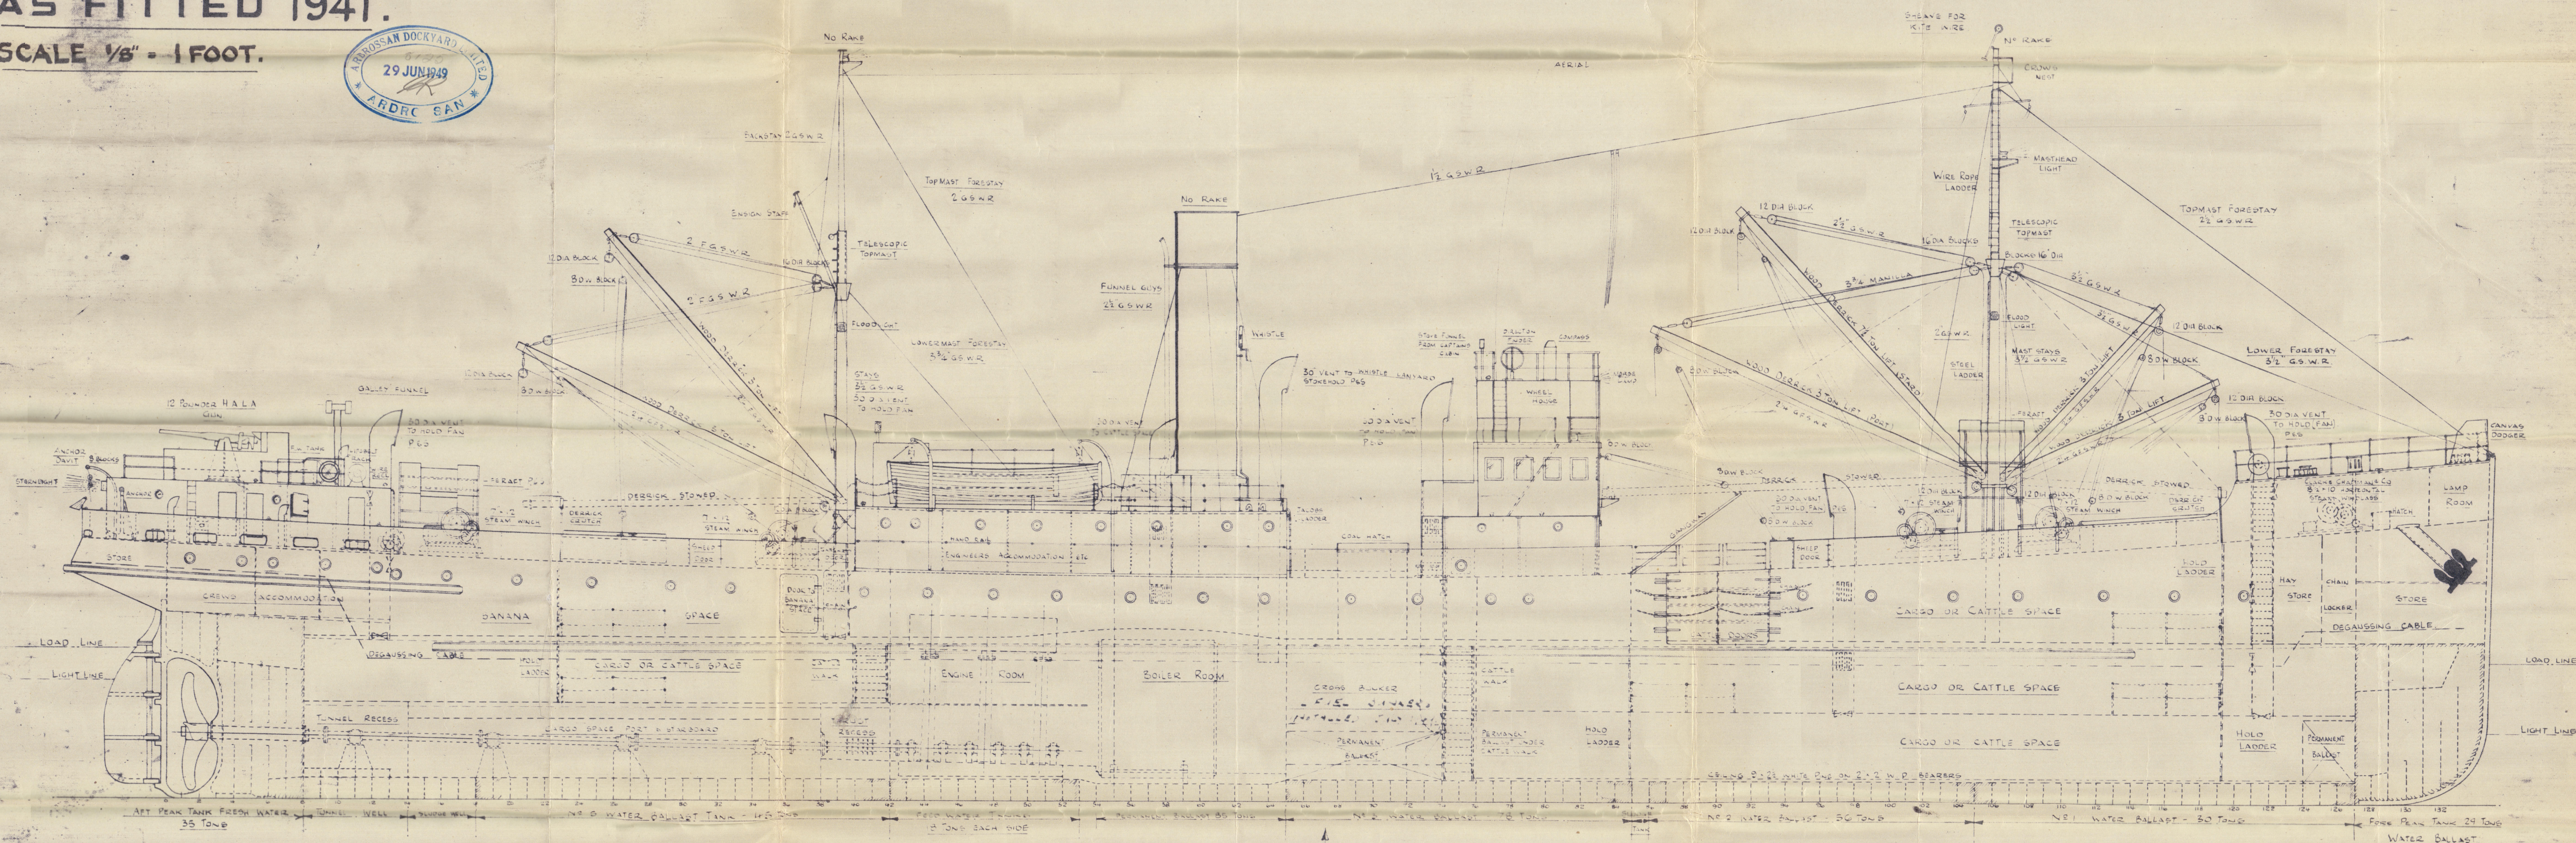


AFT DECKHOUSE TOP

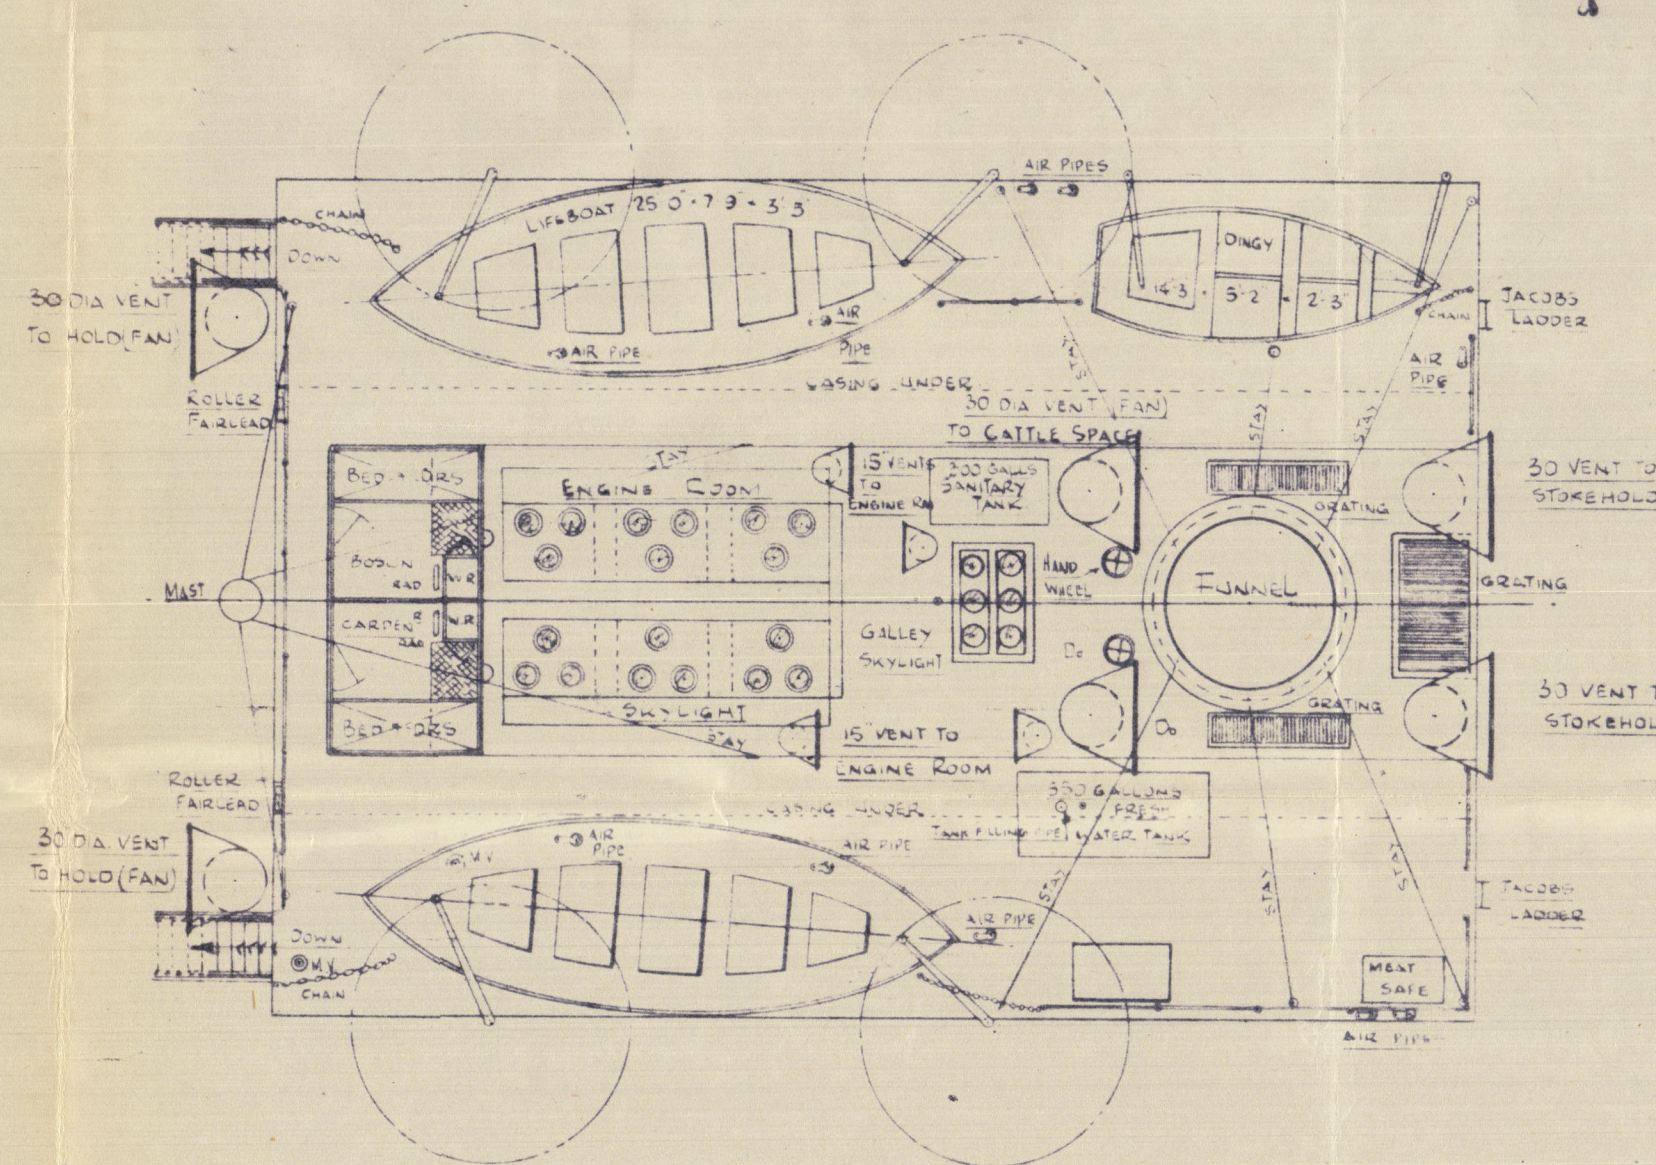


BOAT DECK

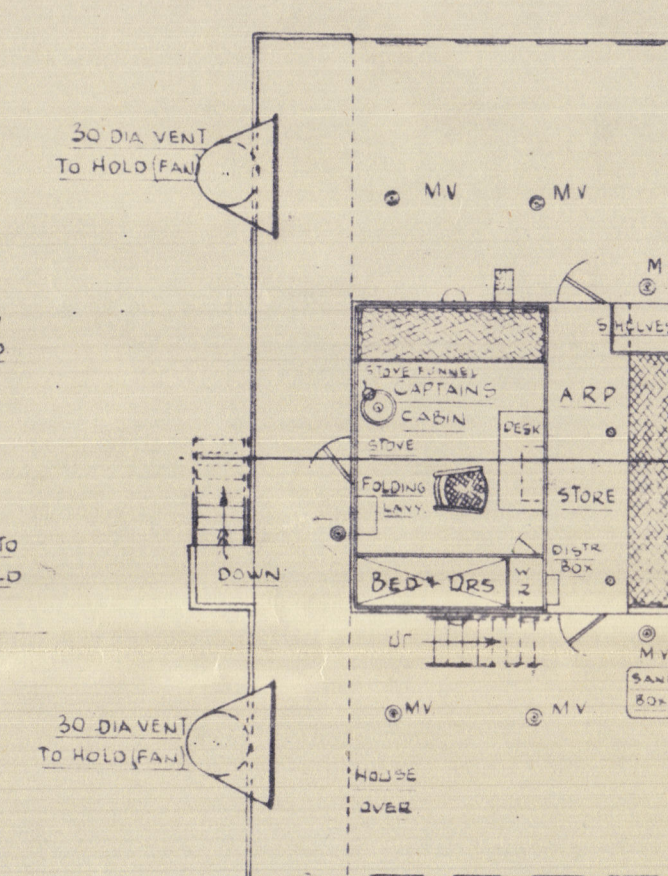


BRIDGE DECK

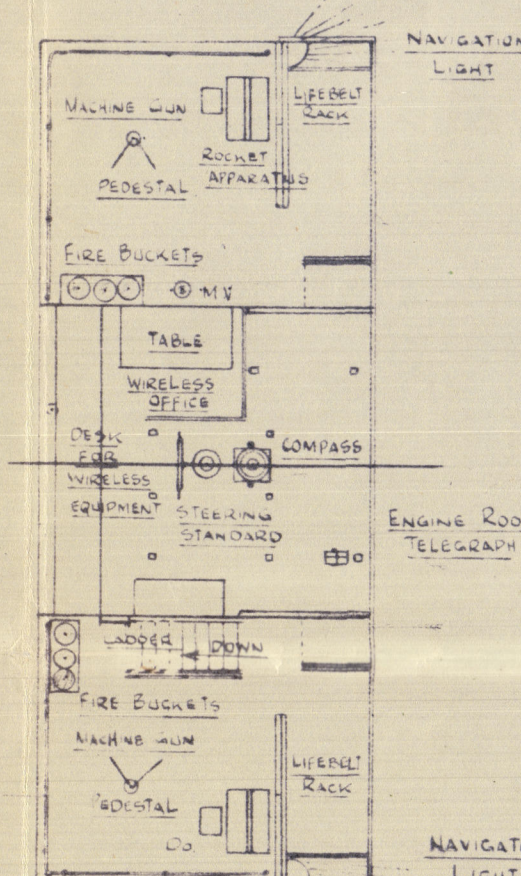

FLYING BRIDGE

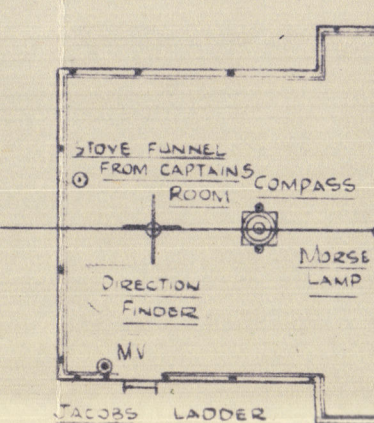

WHEEL HOUSE Top

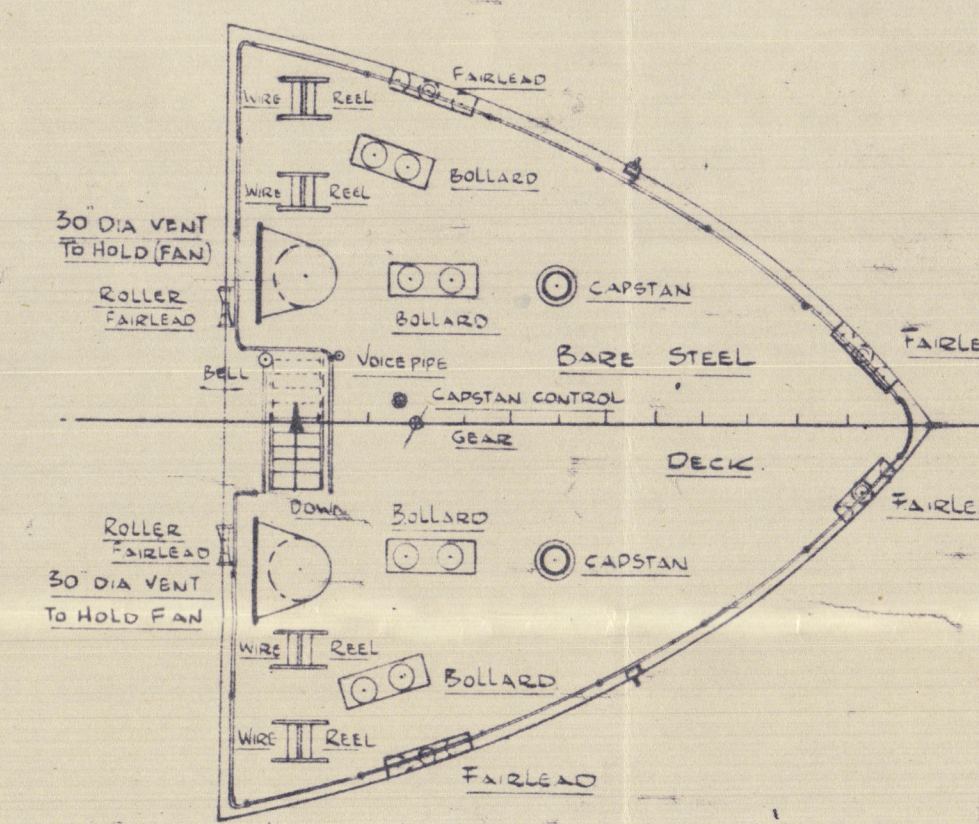

FORECASTLE DECK

47

General Argt. Profile.

Ardrassan Bhd. Ltd.

5/8 MEATH EX WESTERN COAST.

1.7.49.

Keays


PLANS TRANSFERRED
TO SISTER VESSEL

1 JUL 1949

Ardrassan Bhd. Co.

5/8 Meath (1941)

General Argt. - Profile

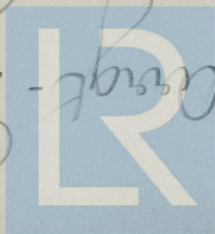

© 2020

Lloyd's Register
Foundation

005167-005173-0014