


Aalborg Værft 9/s.

Yard No. 58.

Profile & Decks.

(2)

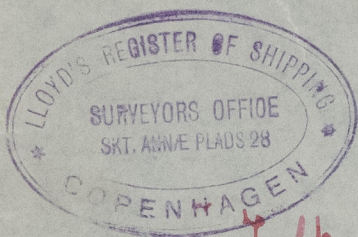

Tolken

s.s. "Latta" of Esbjerg

Exp. Report No. 10617.

PLANS TRANSFERRED
TO SISTER VESSEL

KATTEGAT



© 2020

Lloyd's Register
Foundation

005187-005193-0345