

COPY



Approved  
J. Montgomery  
Surveyor  
of Shipping

10-2-18

Approved  
Ben on Insp.  
British Corporation  
Registered  
15/2/18

# PROFILE & DECK PLANS. STANDARD VESSEL TYPE "H."

SCALE 1/8" = 1 FOOT

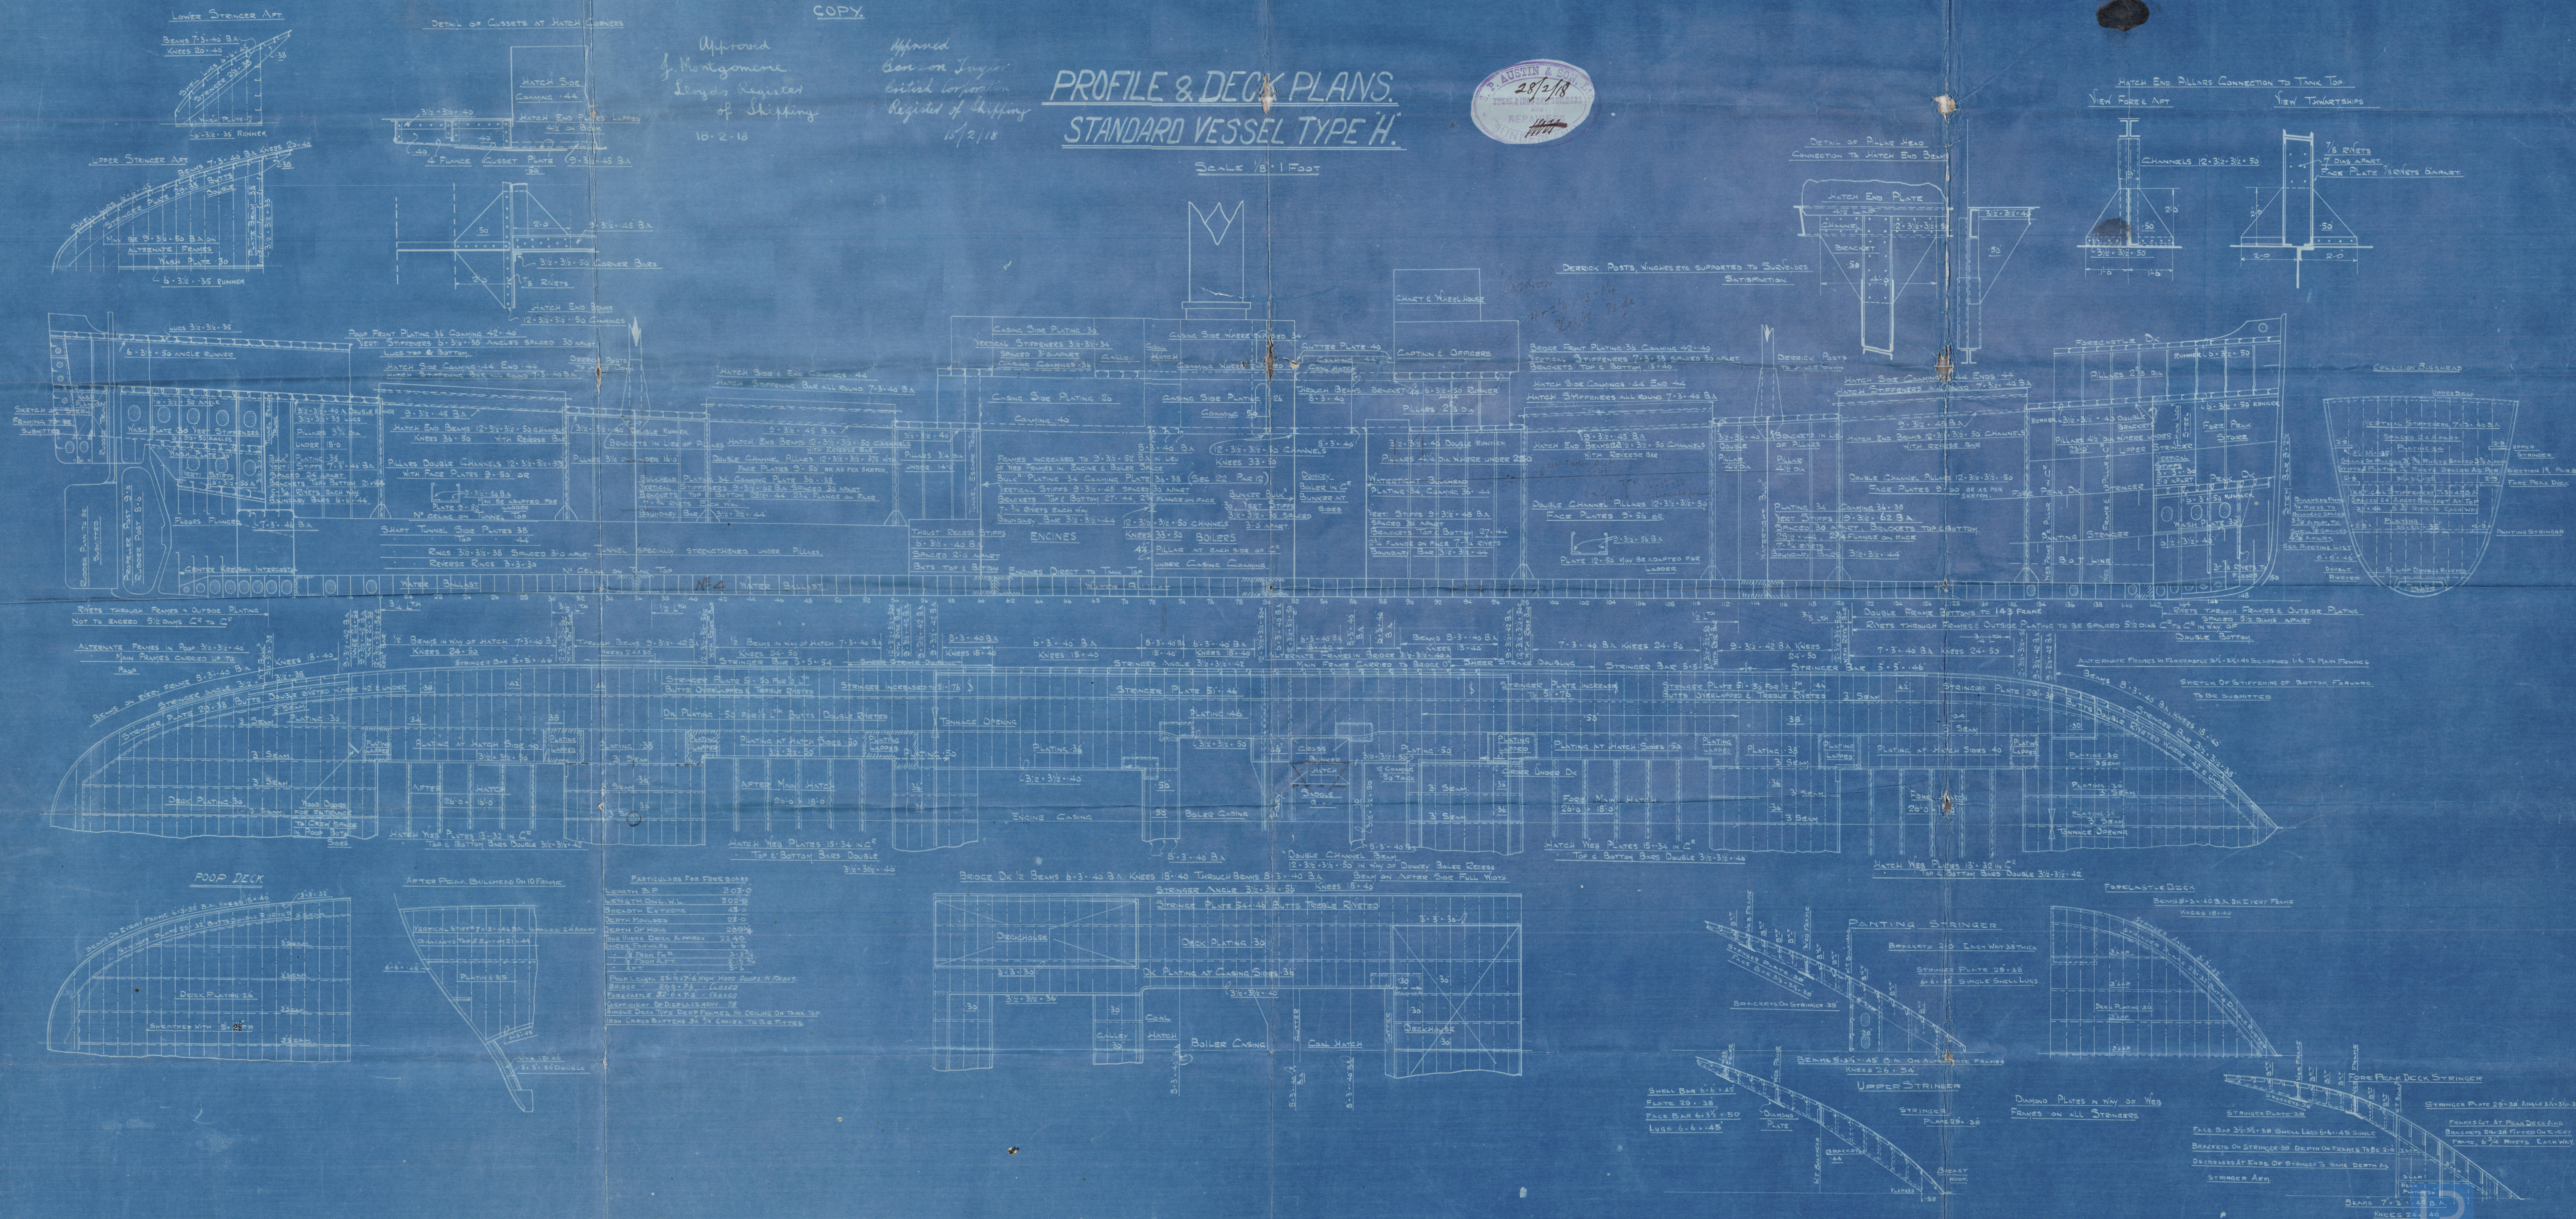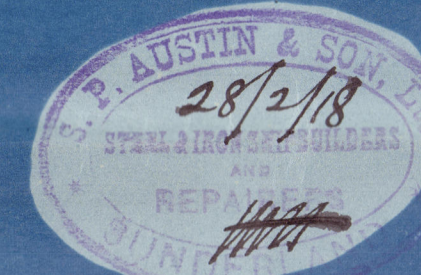



" H " Class, *Link*  
For the information of the Surveyors at

(100) 2/3/18

Dunlop Bremner & Co  
Standard Vessel

H. Type

No 335-6-7-8

Profile & Decks.


"In Bokkeweld" ★ *Grk Sep L.*

No 335 S.S. Backworth 17448  
*known as Quon Castle*

No 336 S.S. Coatsworth 17510

No 337 S.S. Rodeworth 17575

No 338 S.S. Knebworth 17585.

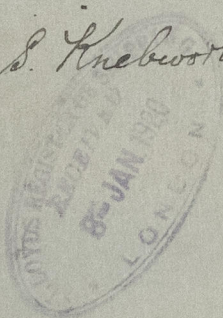

RETAIN

© 2020



Lloyd's Register  
Foundation

005187-005193-0481