
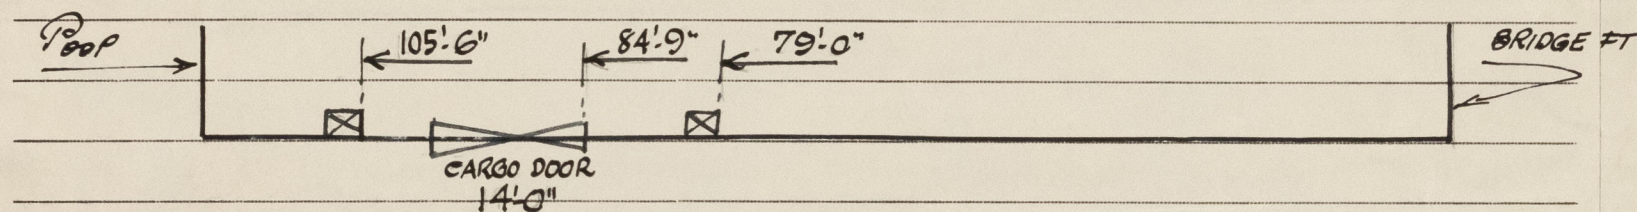
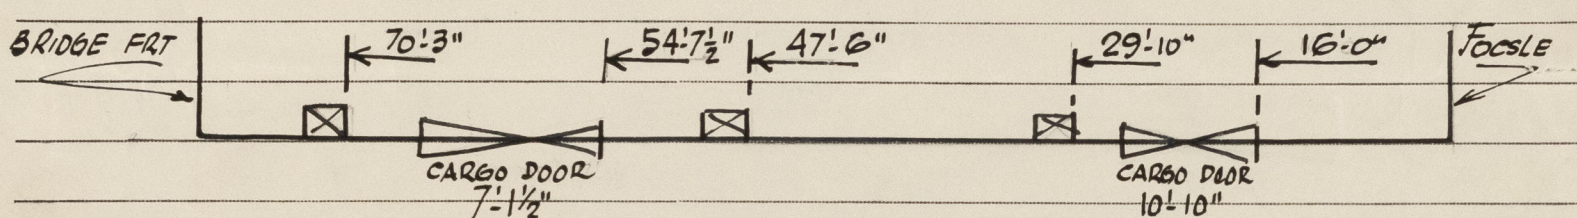


Lloyd's Register of Shipping.

Ship's Name "AIRE"Official No. 161049

~~Memorandum of alterations reported since ship was surveyed for assignment of Load Lines~~
in _____

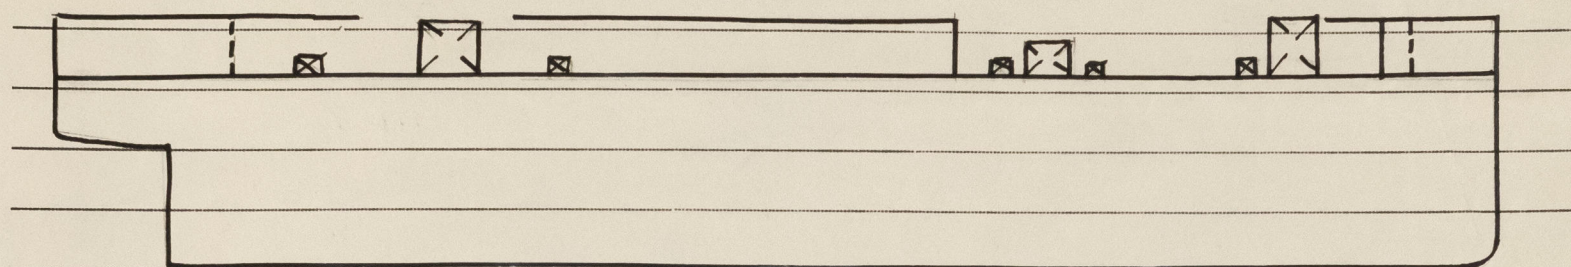

Size of Freeing Ports 2'-6" x 1'-9" x 12" Coaming fwd. well - 3 off prs
 " " " " 2'-6" x 1'-9" x 10" " aft - - 2 off prs

and all fitted with hinged steel shutters & rails

Coamings of Cargo Doors - 12" fwd. and 10" aft.

Cargo Doors found in good order.

Masood

18 JUL 1966

GRIMSBY