

PLAN No 12



No 982 G

PROFILE.

SCALE 1/8" = 1 FOOT.

DIMENSIONS: 425'0" B.P. x 57'0" x 38'9" M.L.O. TO UPPER DECK.

CLASS LLOYDS + 100 A.I. WITH FREEBOARD CORRESPONDING TO THAT OF A COMPLETE SUPERSTRUCTURE VESSEL WITH TONNAGE OPENING.
ALL BULB ANGLES ARE N.B.S.

 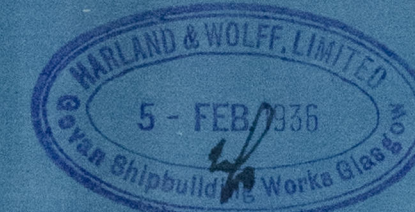

Note: For Frame Spacing & Spacing of Frames at Fore End see Plan No. 58.

APPROVED
LLOYD'S REGISTER OF SHIPPING
H. Williams
DATE 13-2-36

2
Messrs Harland Wolff & Co

Yard No 9829

Profile

005293-005300-0214

Ibid

GLASGOW REPORT No. 58303

M.S. "SALACIA"

GLASGOW REPORT No. 58710.



© 2020

Lloyd's Register
Foundation