

19 FEB 1958

Rpt. C. 11 (Contd.)

Index No. 34009  
(For London Office use)

# LLOYD'S REGISTER OF SHIPPING

UNITED WITH THE BRITISH CORPORATION REGISTER

## ALTERATIONS TO CONDITIONS OF ASSIGNMENT OF LOADLINES

Ship's Name S.S. "HILARY"

Official No. 162350

Port of Registry Liverpool.


This ship has been under survey at Liverpool.

on 6th to 20th January 1958 and the following alterations to the conditions of assignment of loadlines have now been effected/~~found~~—

No.2 and No.3 hatchways on upper deck joined to form one hatch.

Hatch side stays, batten cleats, hatch beams & beam shoes, wood covers and hatch tarpaulins now fitted in accordance with Rule requirements to suit new dimensions of hatches.

Two new hatch beams fitted, scantlings and spacing as follows:—

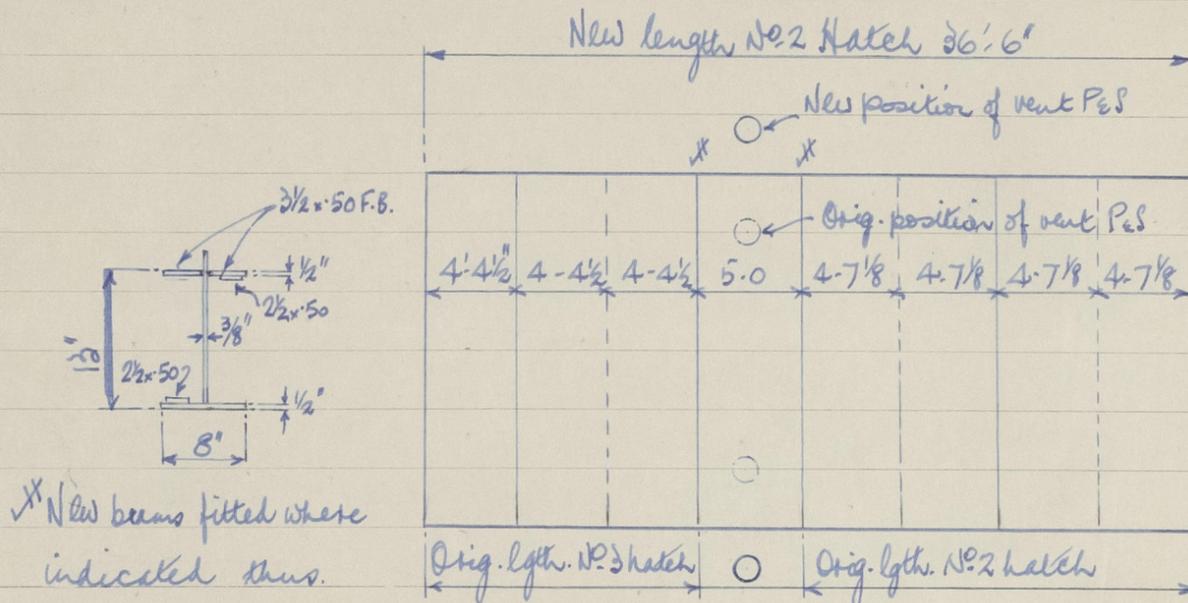

The 18" dia. No.2 Hold ventilator originally fitted in the well between No.2 & No.3 upper deck hatches (p&s), now removed & refitted abreast No.2 hatchway opening p&s. Vent coaming 36" above wood deck sheathing x 3/8" thick supplied with wood plug & canvas cover and upper deck opening suitably reinforced in way

of opening



Not  
AR  
2-3-58

A copy of this Report has been placed on board.



© 2021

Lloyd's Register  
Foundation

005307-005310-0099