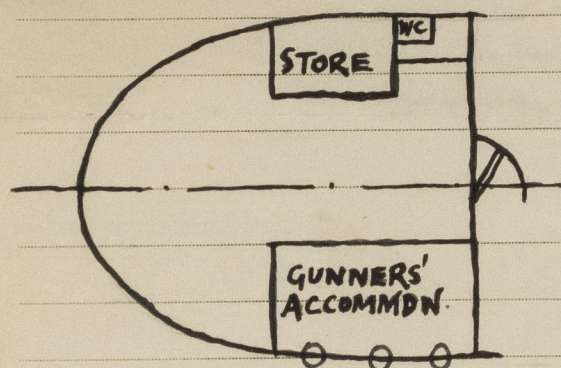


23291. 19 AUG 1943
31307

Lloyd's Register of Shipping.

Ship's Name **ENGLISH MONARCH.**Official No. **147905.**Memorandum of alterations reported since ship was surveyed for assignment of Load Lines
inAccommodation for gunners, fitted in poop.

One - 6" diam. cool vent. on poop deck, provided with wood plug and canvas cover.

Three - 10" diam. Sidescuttles fitted in ship's sides, provided with hinged deadlights. Overboard discharge from W.C. on port side, fitted with automatic non-return valve.

Stormboards in opening in poop front bulkhead replaced by hinged wood door, strongly constructed, and capable of being closed and secured from both sides.

A. Reid.

Swansea.

2nd July 1943.

Copy of this report has been attached to the Rpt. C. 11 on board the ship.

The Load Line certificate and copy have been amended in respect of the closing appliances on the poop bulkhead.

Noted.

Barb

20 AUG 1943

Structure Decks ...
Machinery Casings within Superstructures not fitted with Class I Closing Appliances ...
Casings on Deck

Steel hinges



© 2020

Lloyd's Register
Foundation

005318-005320-0043