


NOS. 509 - 10.

TWIN SCREW TURBINE STEAMERS.

DECK PLANS SHEWING SCANTLINGS.

SCALE 1/8" = 1 FOOT.

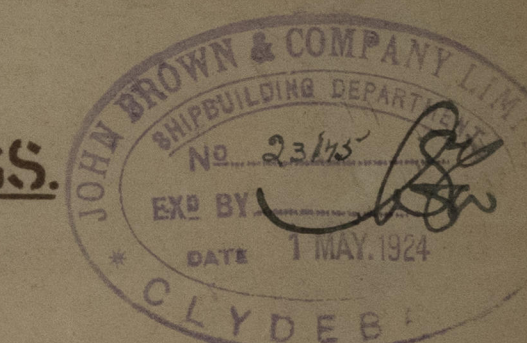

BEAMS 4 1/2" x 3" x 30" ANGLES ON ALT. FRAMES.

BOAT DECK BEAMS 4 1/2" x 3" x 30" ANGLES ON ALT. FRAMES.

Revised @ B. Davis
Revised in way of Boat
to Surveyor's satisfaction
Plate fitted to take BOATS DAVITS
ALSO ADDITIONAL STIFFENING

FORECASTLE DECK BEAMS 6 1/2" x 3 1/2" x 34" B.A. ON ALT. FRAMES.

BOAT & FORECASTLE DECKS.

PROMENADE DECK.

NOTE: WHERE DECK PLATES AT END ARE LESS THAN THE
RULE WIDTH AND THICKNESS FOR STRINGER THE
ADJACENT STRAKE TO BE INCREASED IN PROPORTION.

MAIN DECK.

MAIN DECK.

LOWER DECK.

LOWER DECK.

J. Brown & Co. Ltd.

No 509-10


Decks.

% St Julien C

GLASGOW REPORT No 44631

% St Helier

GLASGOW REPORT No 44737

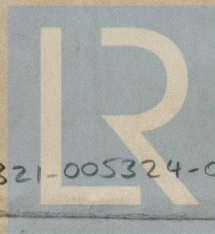

© 2020

Lloyd's Register
Foundation

005321-005324-0120