
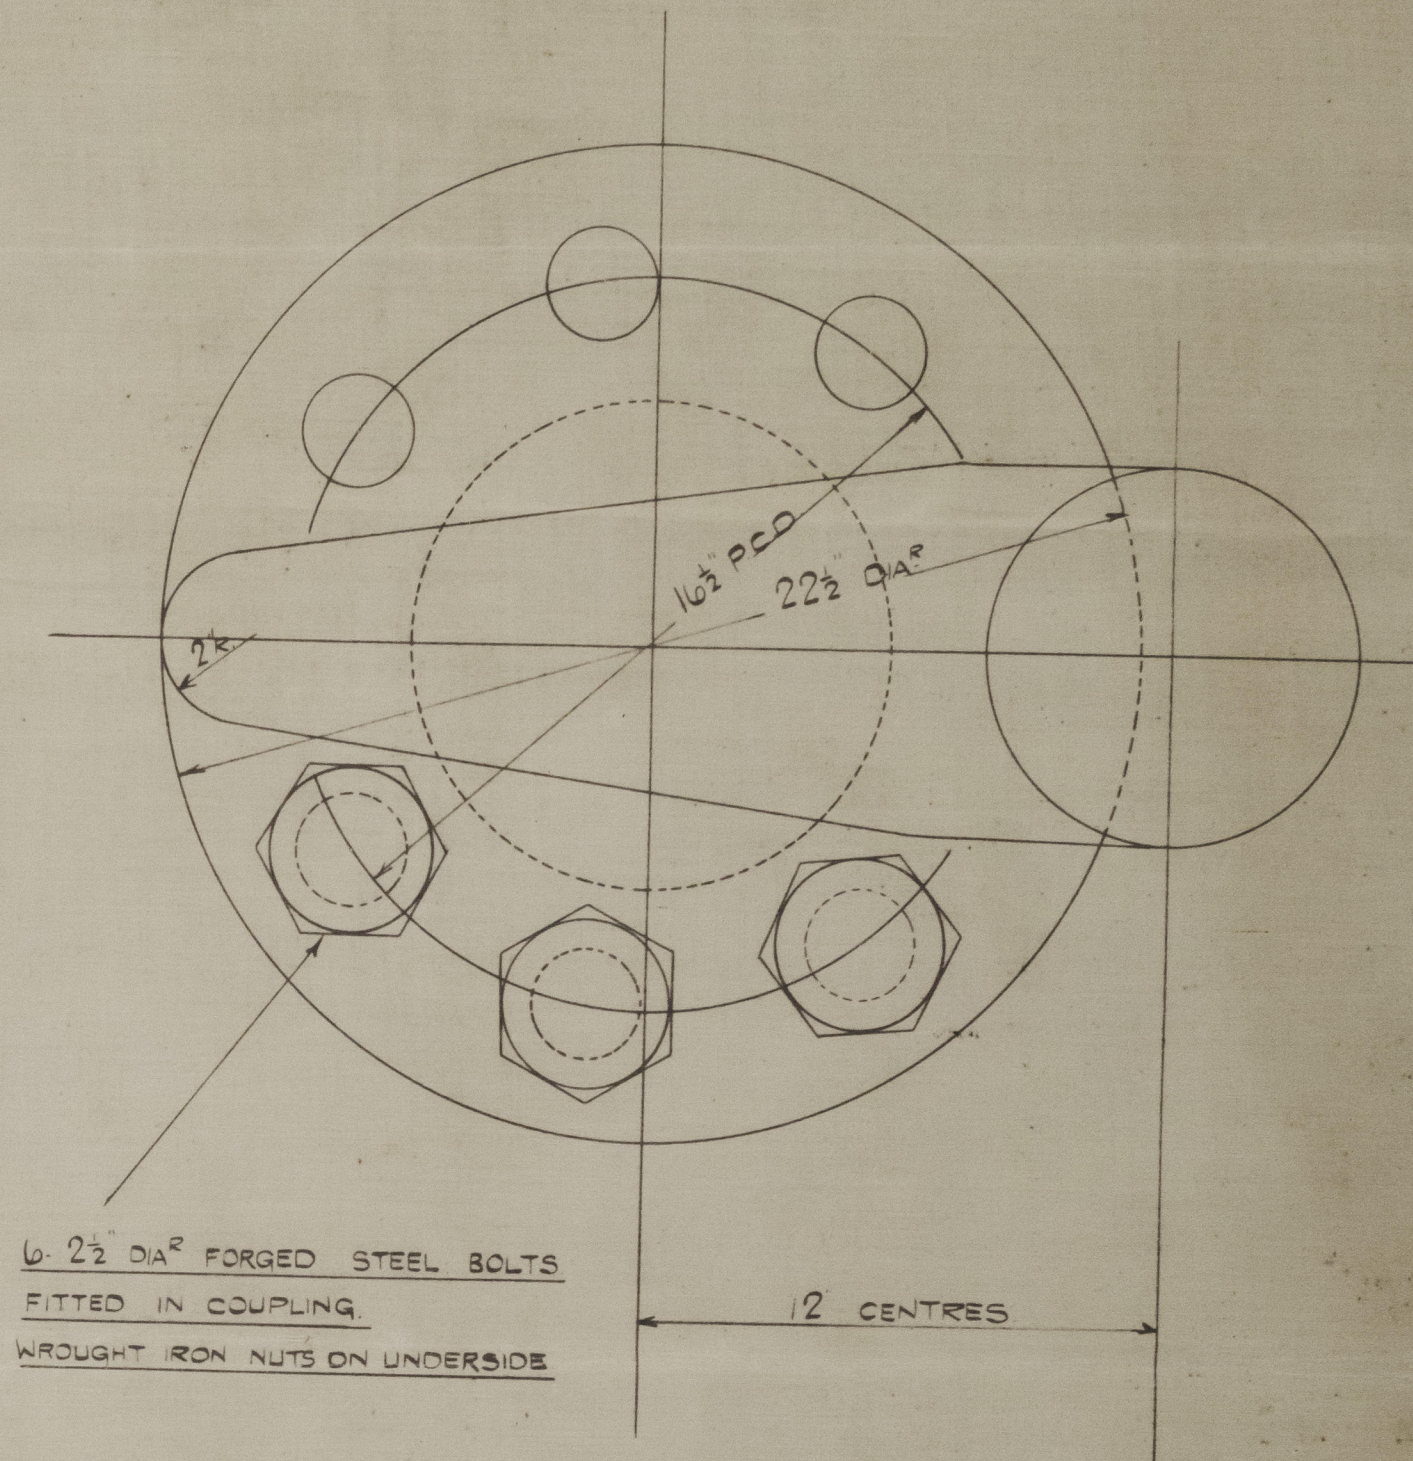


Lloyds

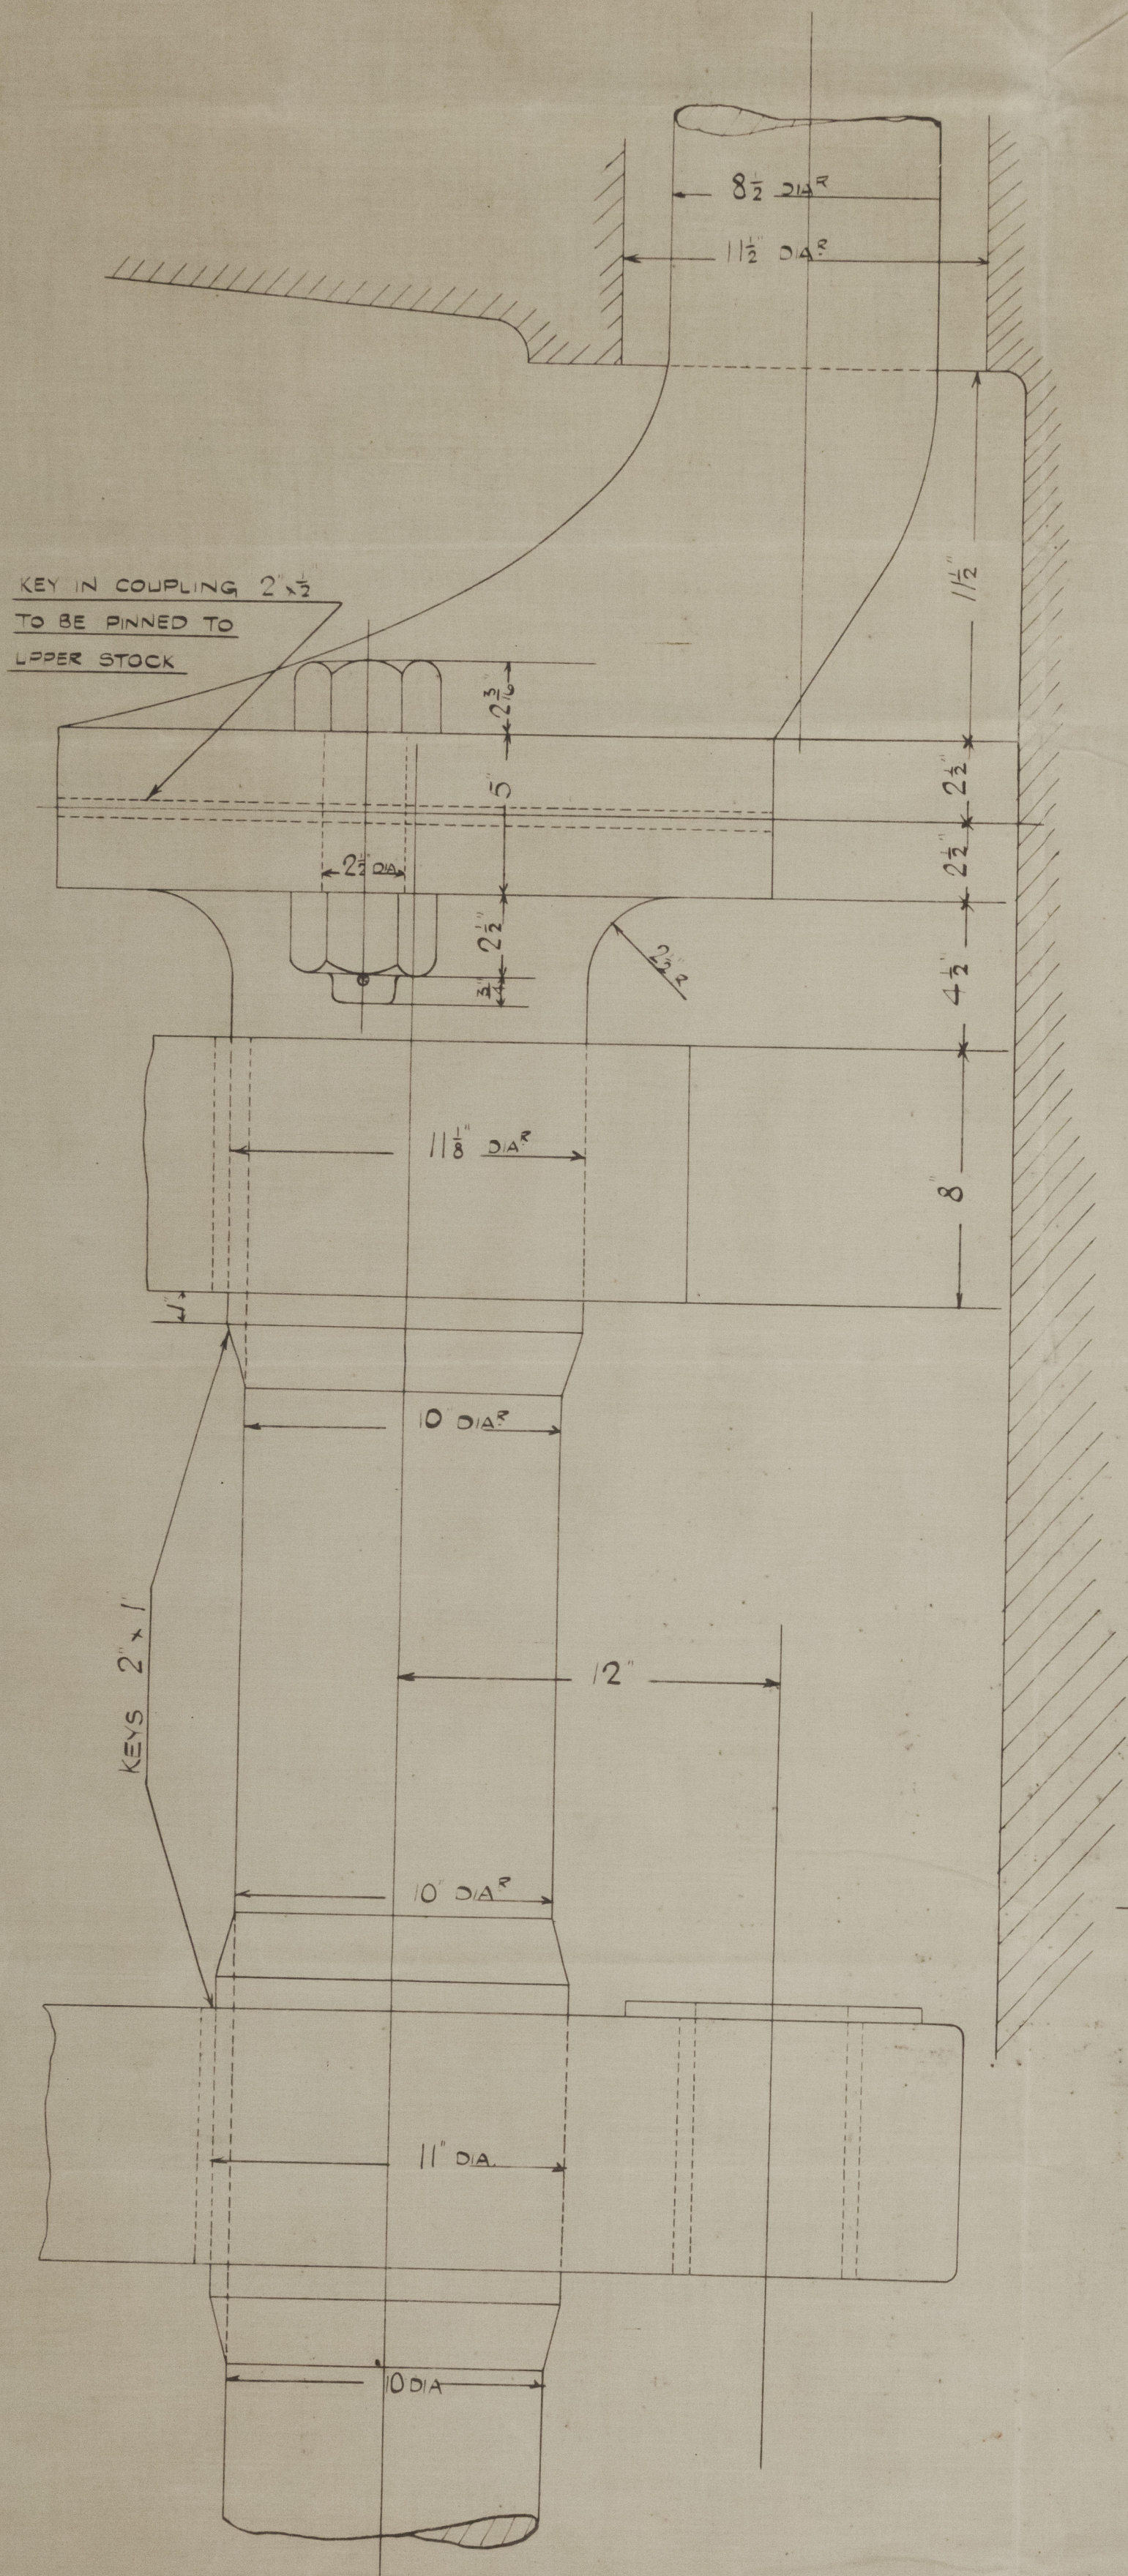

6. 2 1/2" DIA FORGED STEEL BOLTS
FITTED IN COUPLING.
WROUGHT IRON NUTS ON UNDERSIDE


Approved for Coupling only

APPROVED
LLOYDS REGISTER OF SHIPPING
Management for Hatter
DATE 6.6.20

S 89/10

— MESSRS JOHN BROWN & CO LTD'S T.S.S. N^{OS} 509-510 —

— PROPOSED RUDDER COUPLING. —
— TO LLOYDS & B.O.F.T. REQ^{TS}. —
— SCALE 3" = 1 FOOT. —

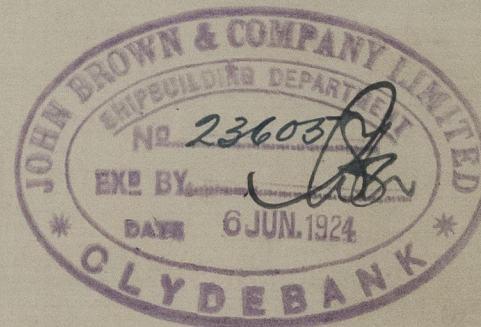

208.7



© 2020
Lloyd's Register
Foundation

AMENDED RUDDER

COUPLING

509/10

John Brown & Co

005321-005324-0122



© 2020

Lloyd's Register
Foundation