

N<sup>o</sup>. 1431-2

"RHODESIA CASTLE"

MIDSHIP SECTION. (AS FITTED)

SCALE 3/8 IN = 1 FOOT.

DIMENSIONS: 540'-0" B.P. x 74'-0" x 35'-6" MLD. TO 'A' DECK.

DRAFT (ALL SEASONS) MOULDED 28'-1" CLASS 100A1.


ALL SECTIONS N.B.S.

LLOYD'S NUMERALS:			
L	540'	D TO 'B' DECK	44'
B	74'	D - 'C'	52'5"
d	28'-08"	D - 'D'	61'
h	15'-16"		
		FRAME SPACING AMIDSHIPS	33'
		CAMBER ALL DECKS	6" IN 74'-0"

WELDING  
SHELL BUTTS.  
DECK PLATING (SEAMS & BUTTS) EXCEPT LOWER & MAIN DECKS.  
TANK TOP PLATING (---) ---  
TANK MARGIN BUTTS & CONNECTIONS.

EQUIPMENT NUMERALS	
L (B+D) 540' (74' x 44')	63720
'B' DECKS 382' x 8' 50' x 75'	2435
'B' DECKHOUSES 130' x 8' 5' x 5'	553
'C' " " 278' x 8' 5' x 5'	1180
'D' " " 185' x 9' 5' x 5'	880
'E' " " 120' x 9' 35' x 5'	861
NAVIG. BRIDGE 43' x 7' 5' x 5'	162
	69491

EQUIPMENT LETTER RT.	
3 BOWER ANCHORS 322 CWTs. STOCKLESS	✓
1 STREAM " 34 " EX STOCK	✓
330 FMS. STUB CHAIN CABLE 2 1/8" (TAYCO 2 1/8")	✓
150 " 6" STEEL WIRE STREAM.	✓
140 " 7" " TOWLINE.	✓
3 ORF 120 FMS. 2 3/4" STEEL WIRE HAWSEERS.	✓
2 ORF 120 " 2 3/4" " " WARPS.	✓
OWNERS REQUIREMENTS	
3 BOWER ANCHORS 112 CWTs. EACH. STOCKLESS	
330 FMS. TAYCO CABLE 2 1/8"	
6 ORF 100 FMS. 3 1/2" G.F.S. WIRE.	

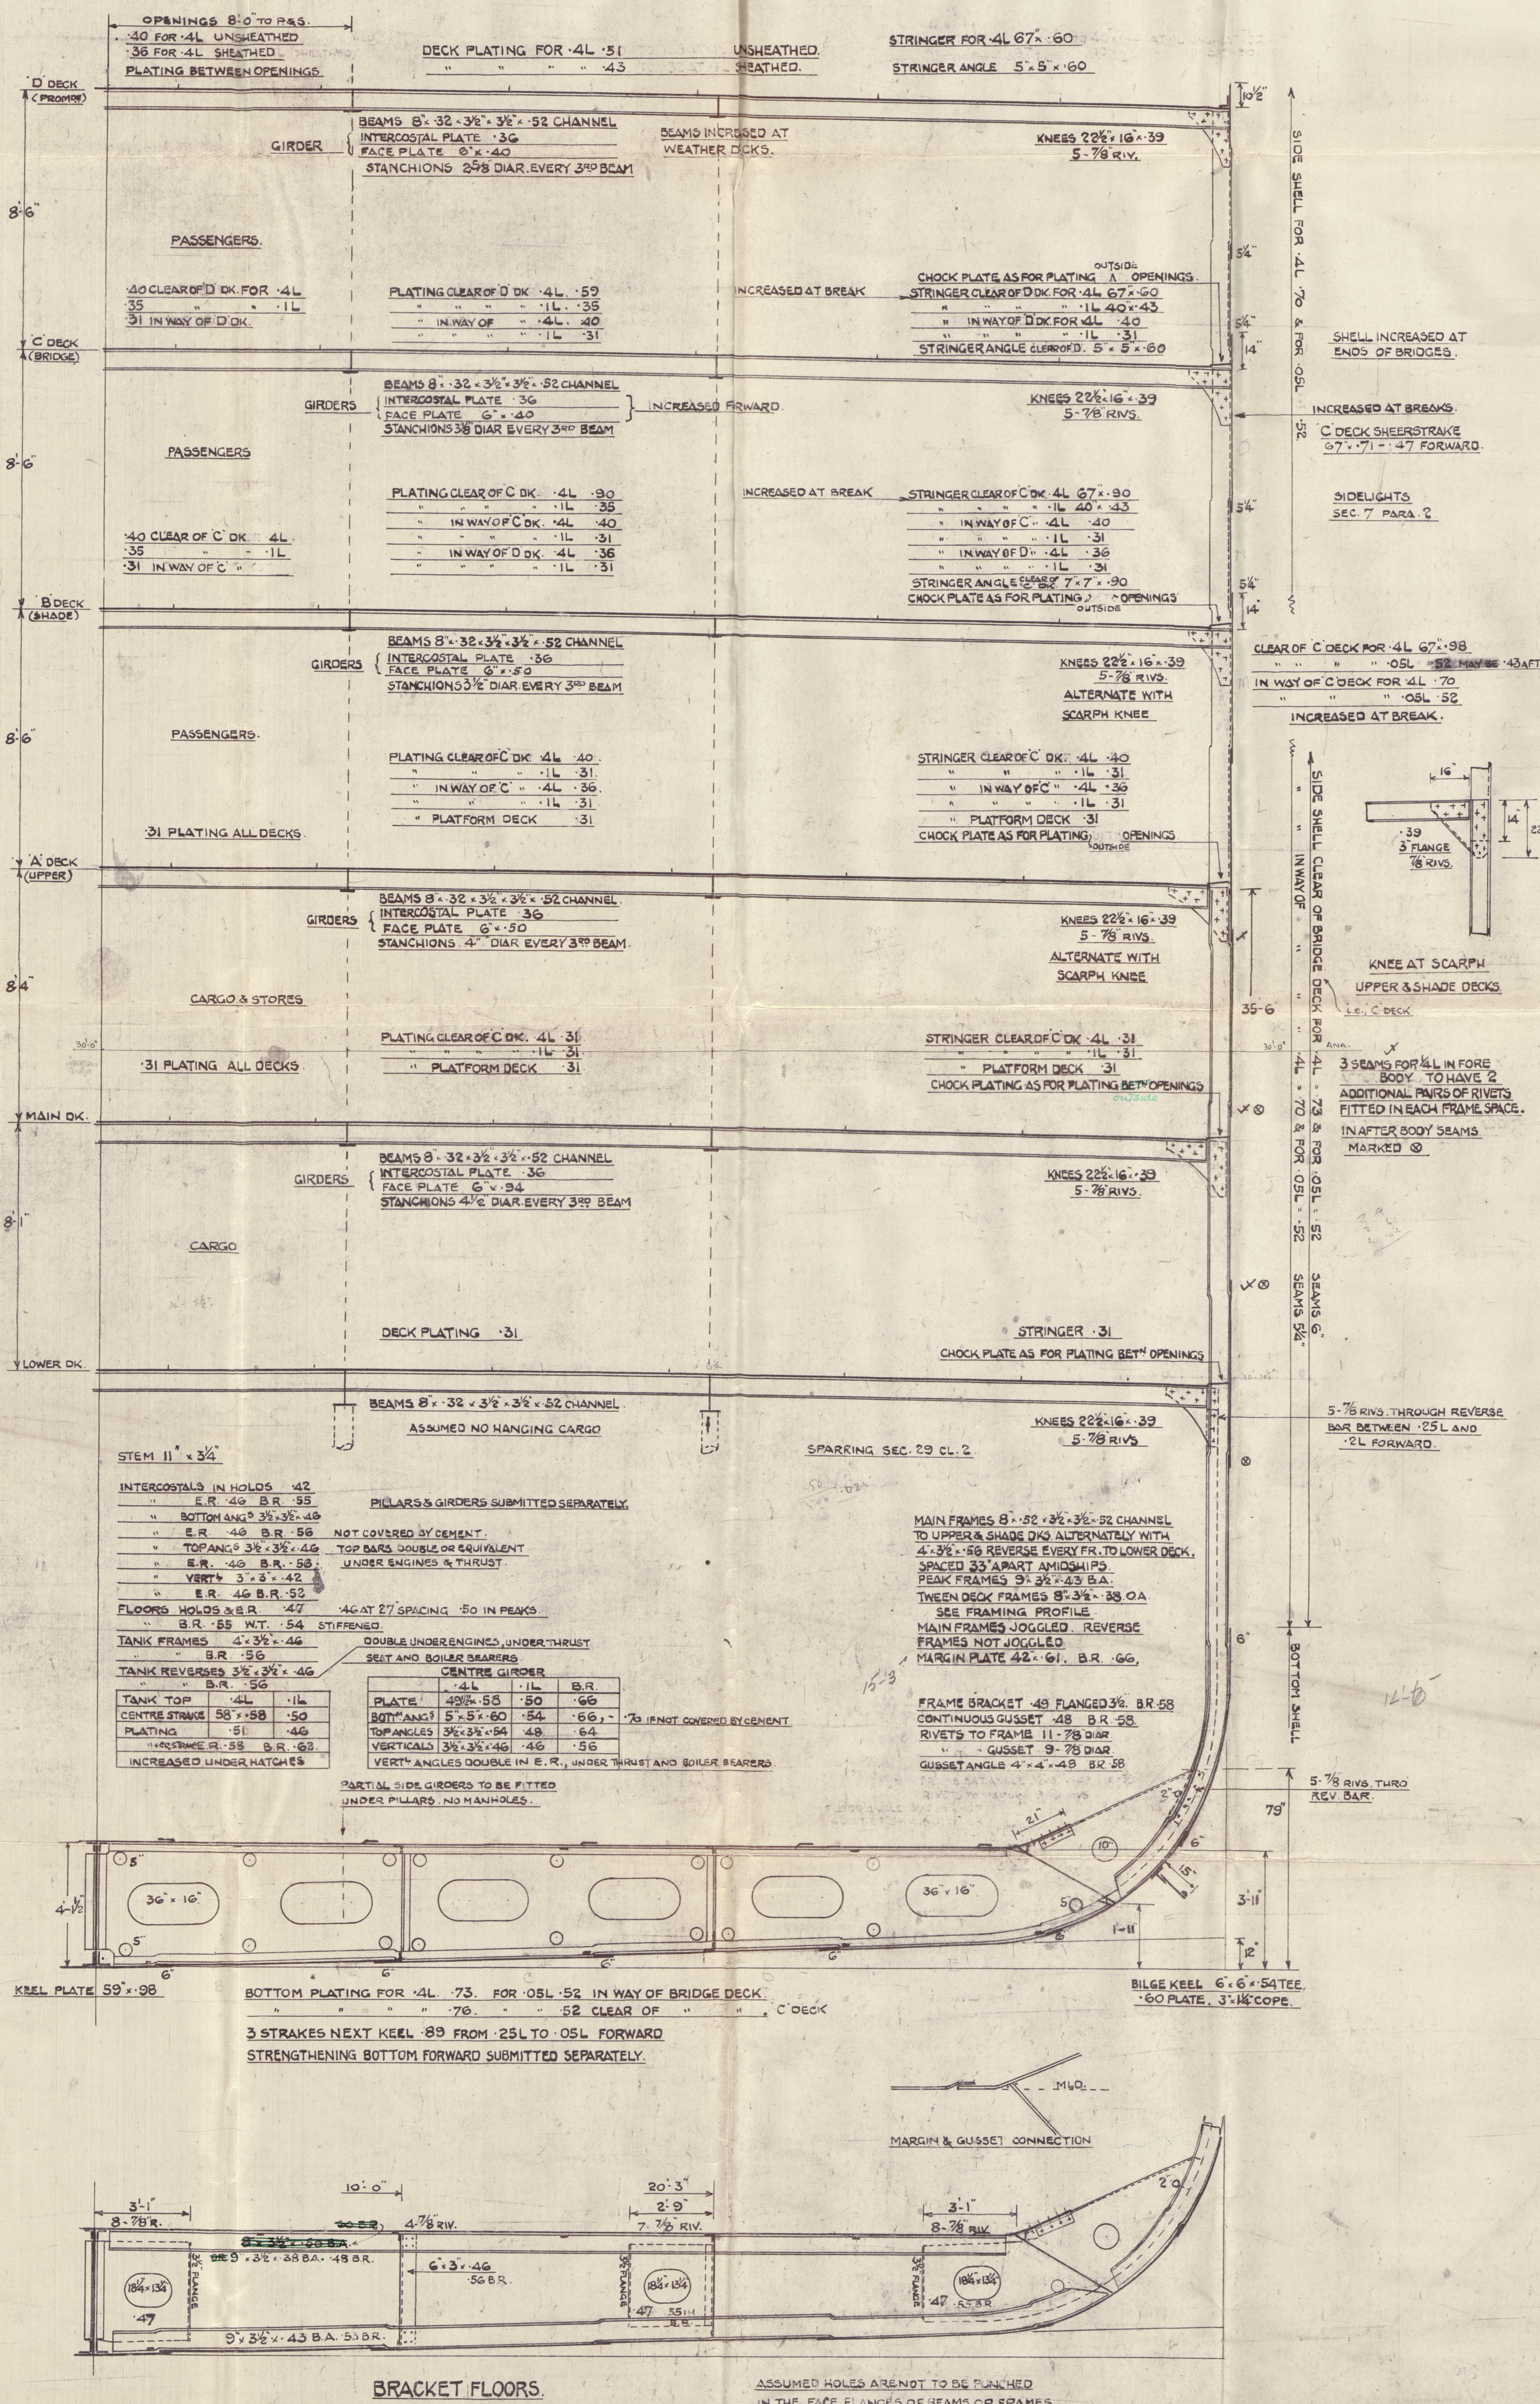




"AS FITTED"

1A

HARLAND & WOLFF LTD.  
BELFAST

No. 1431 "RHODESIA CASTLE" 


TITLE. MIDSHIP SECTION  
(AS FITTED PLAN)

DATE APPROVED VERIFIED 4:9:51.

Belfast 11th April 1917.

Belfast Rpt. No. 15283. "Rhodesia Castle"

RECORDS DEPT.,  
LONDON

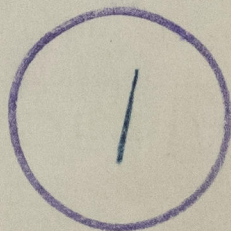

© 2020

Lloyd's Register  
Foundation

005353-005357-0051