
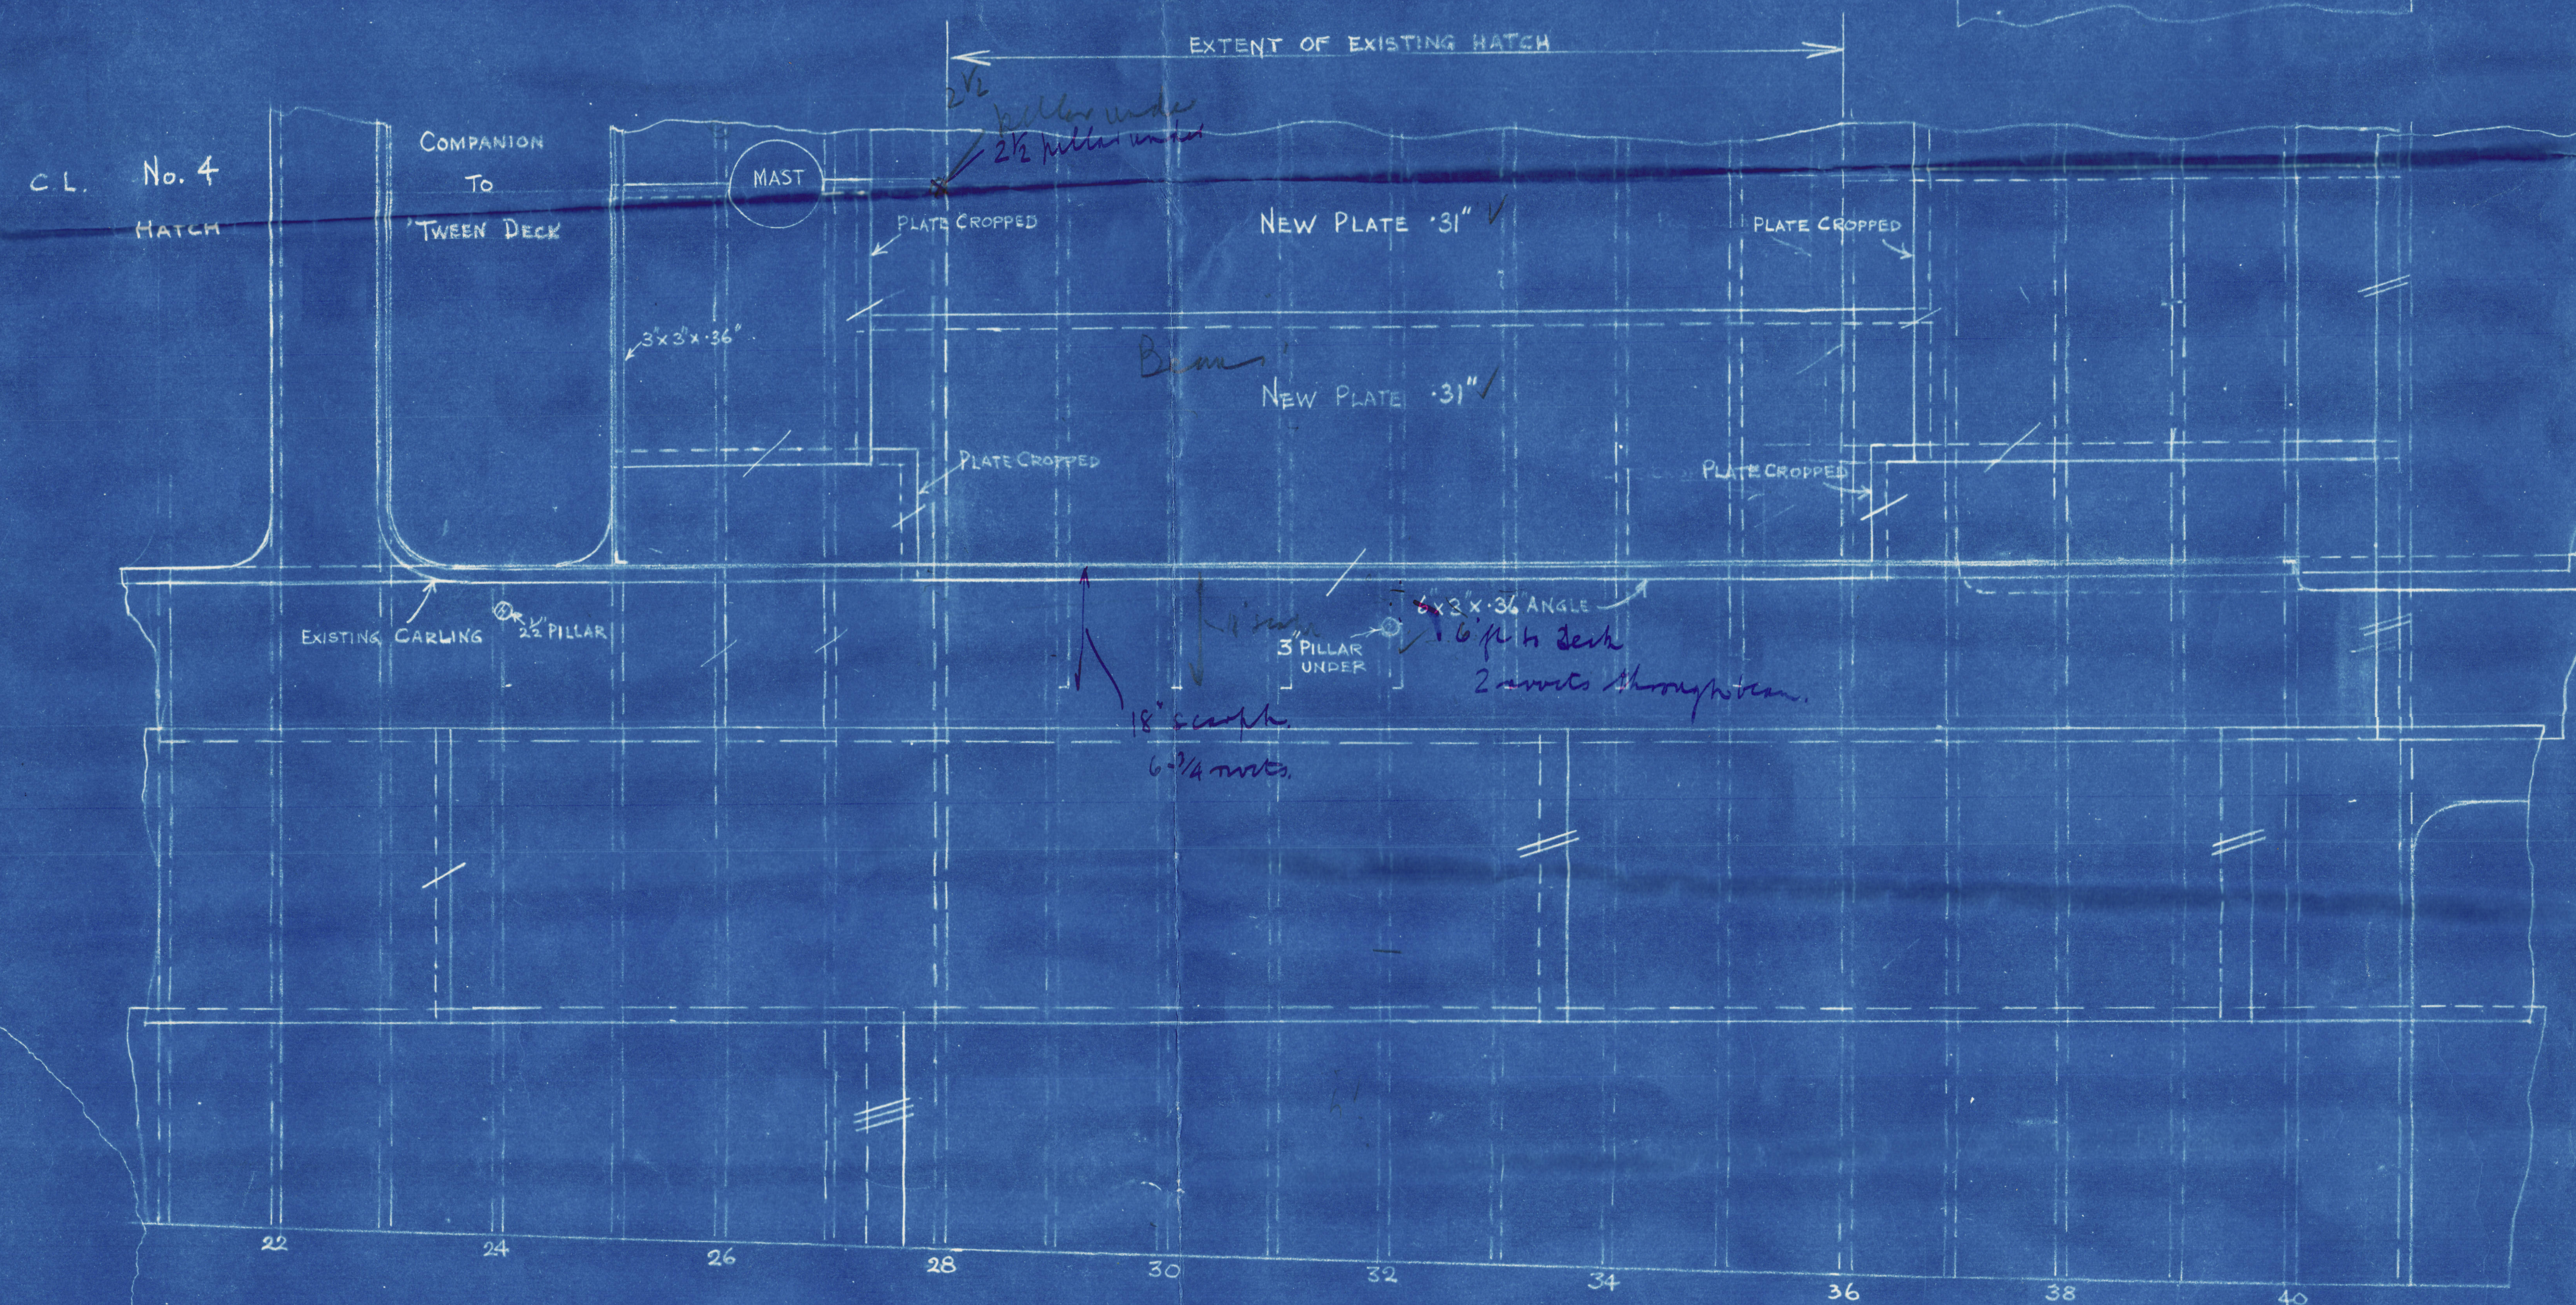
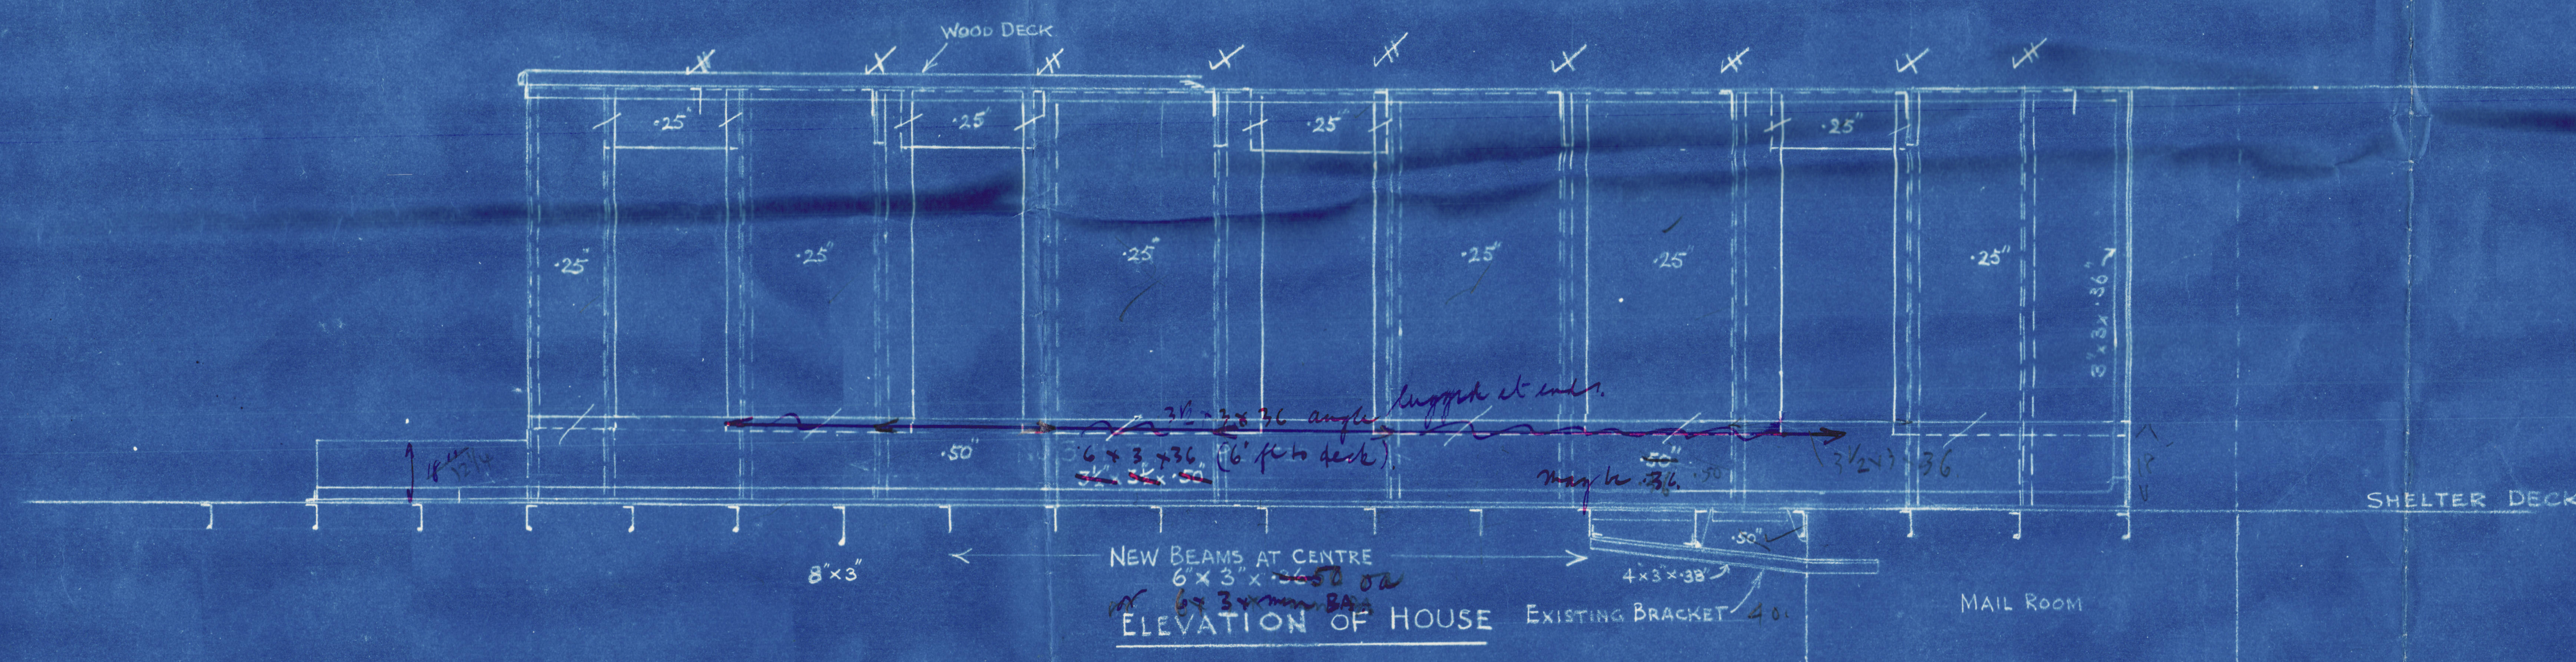




ELEVATION AT STARBOARD SIDE (LOOKING INBOARD)

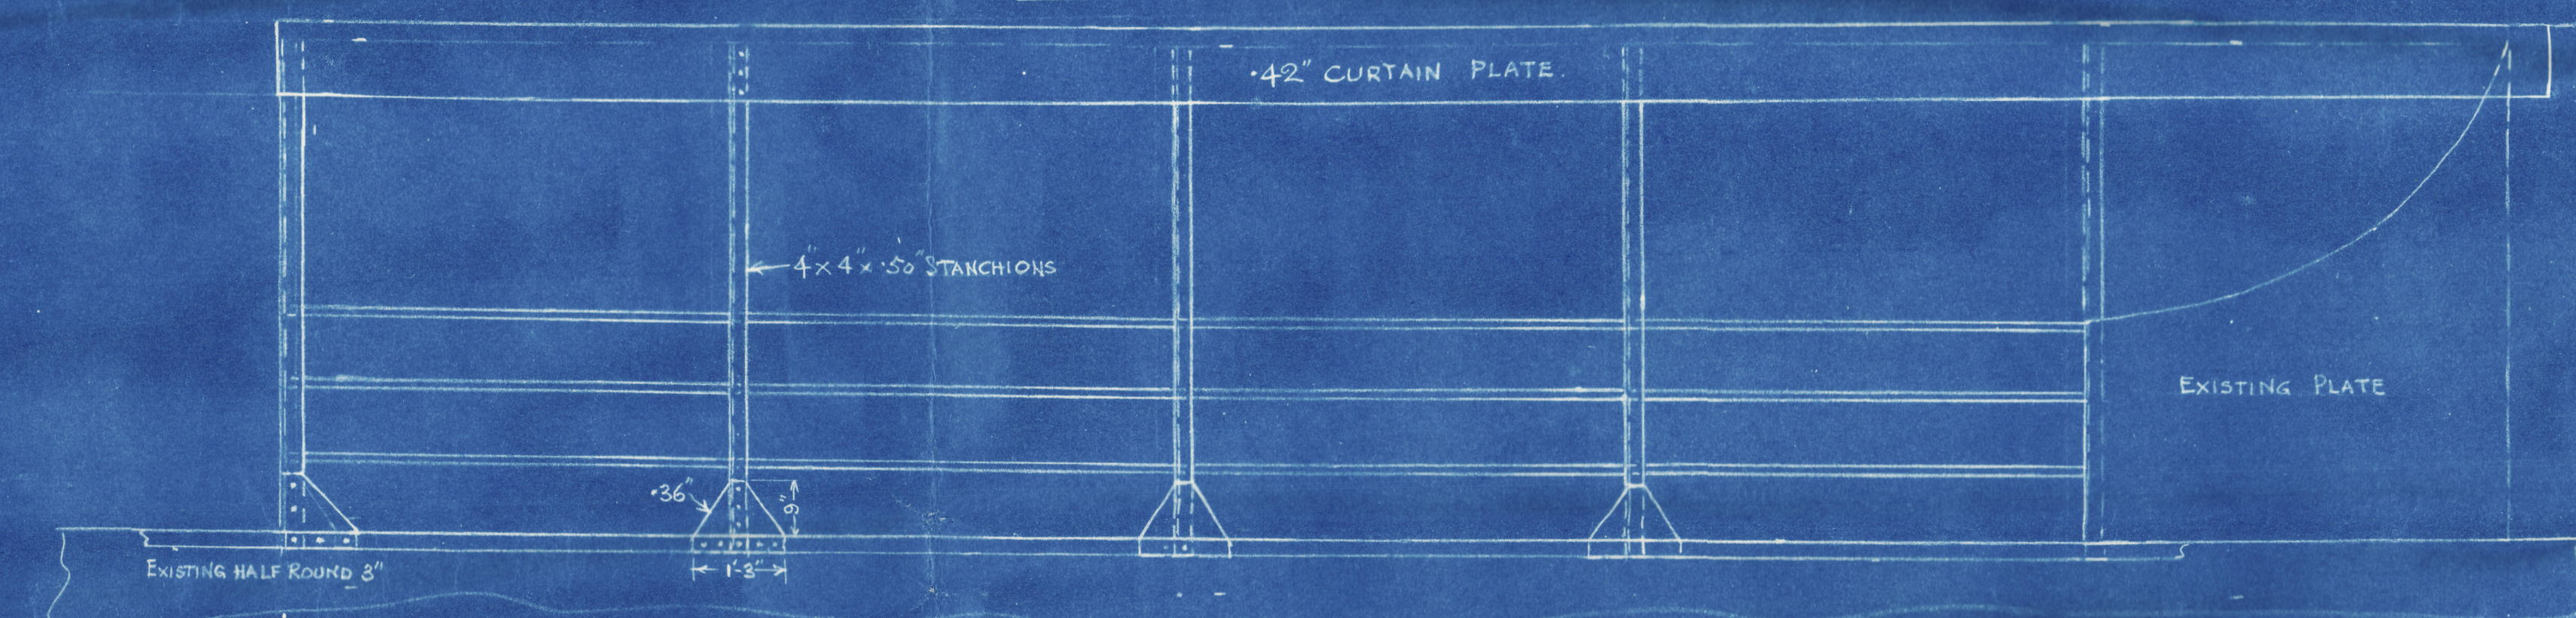

PLAN AT SHELTER DECK

215-117 4 -117

S. S. DRAKE
NEW DECK HOUSE & DECK OVER No. 3 HATCH
SCALE 1/2" = 1 FOOT

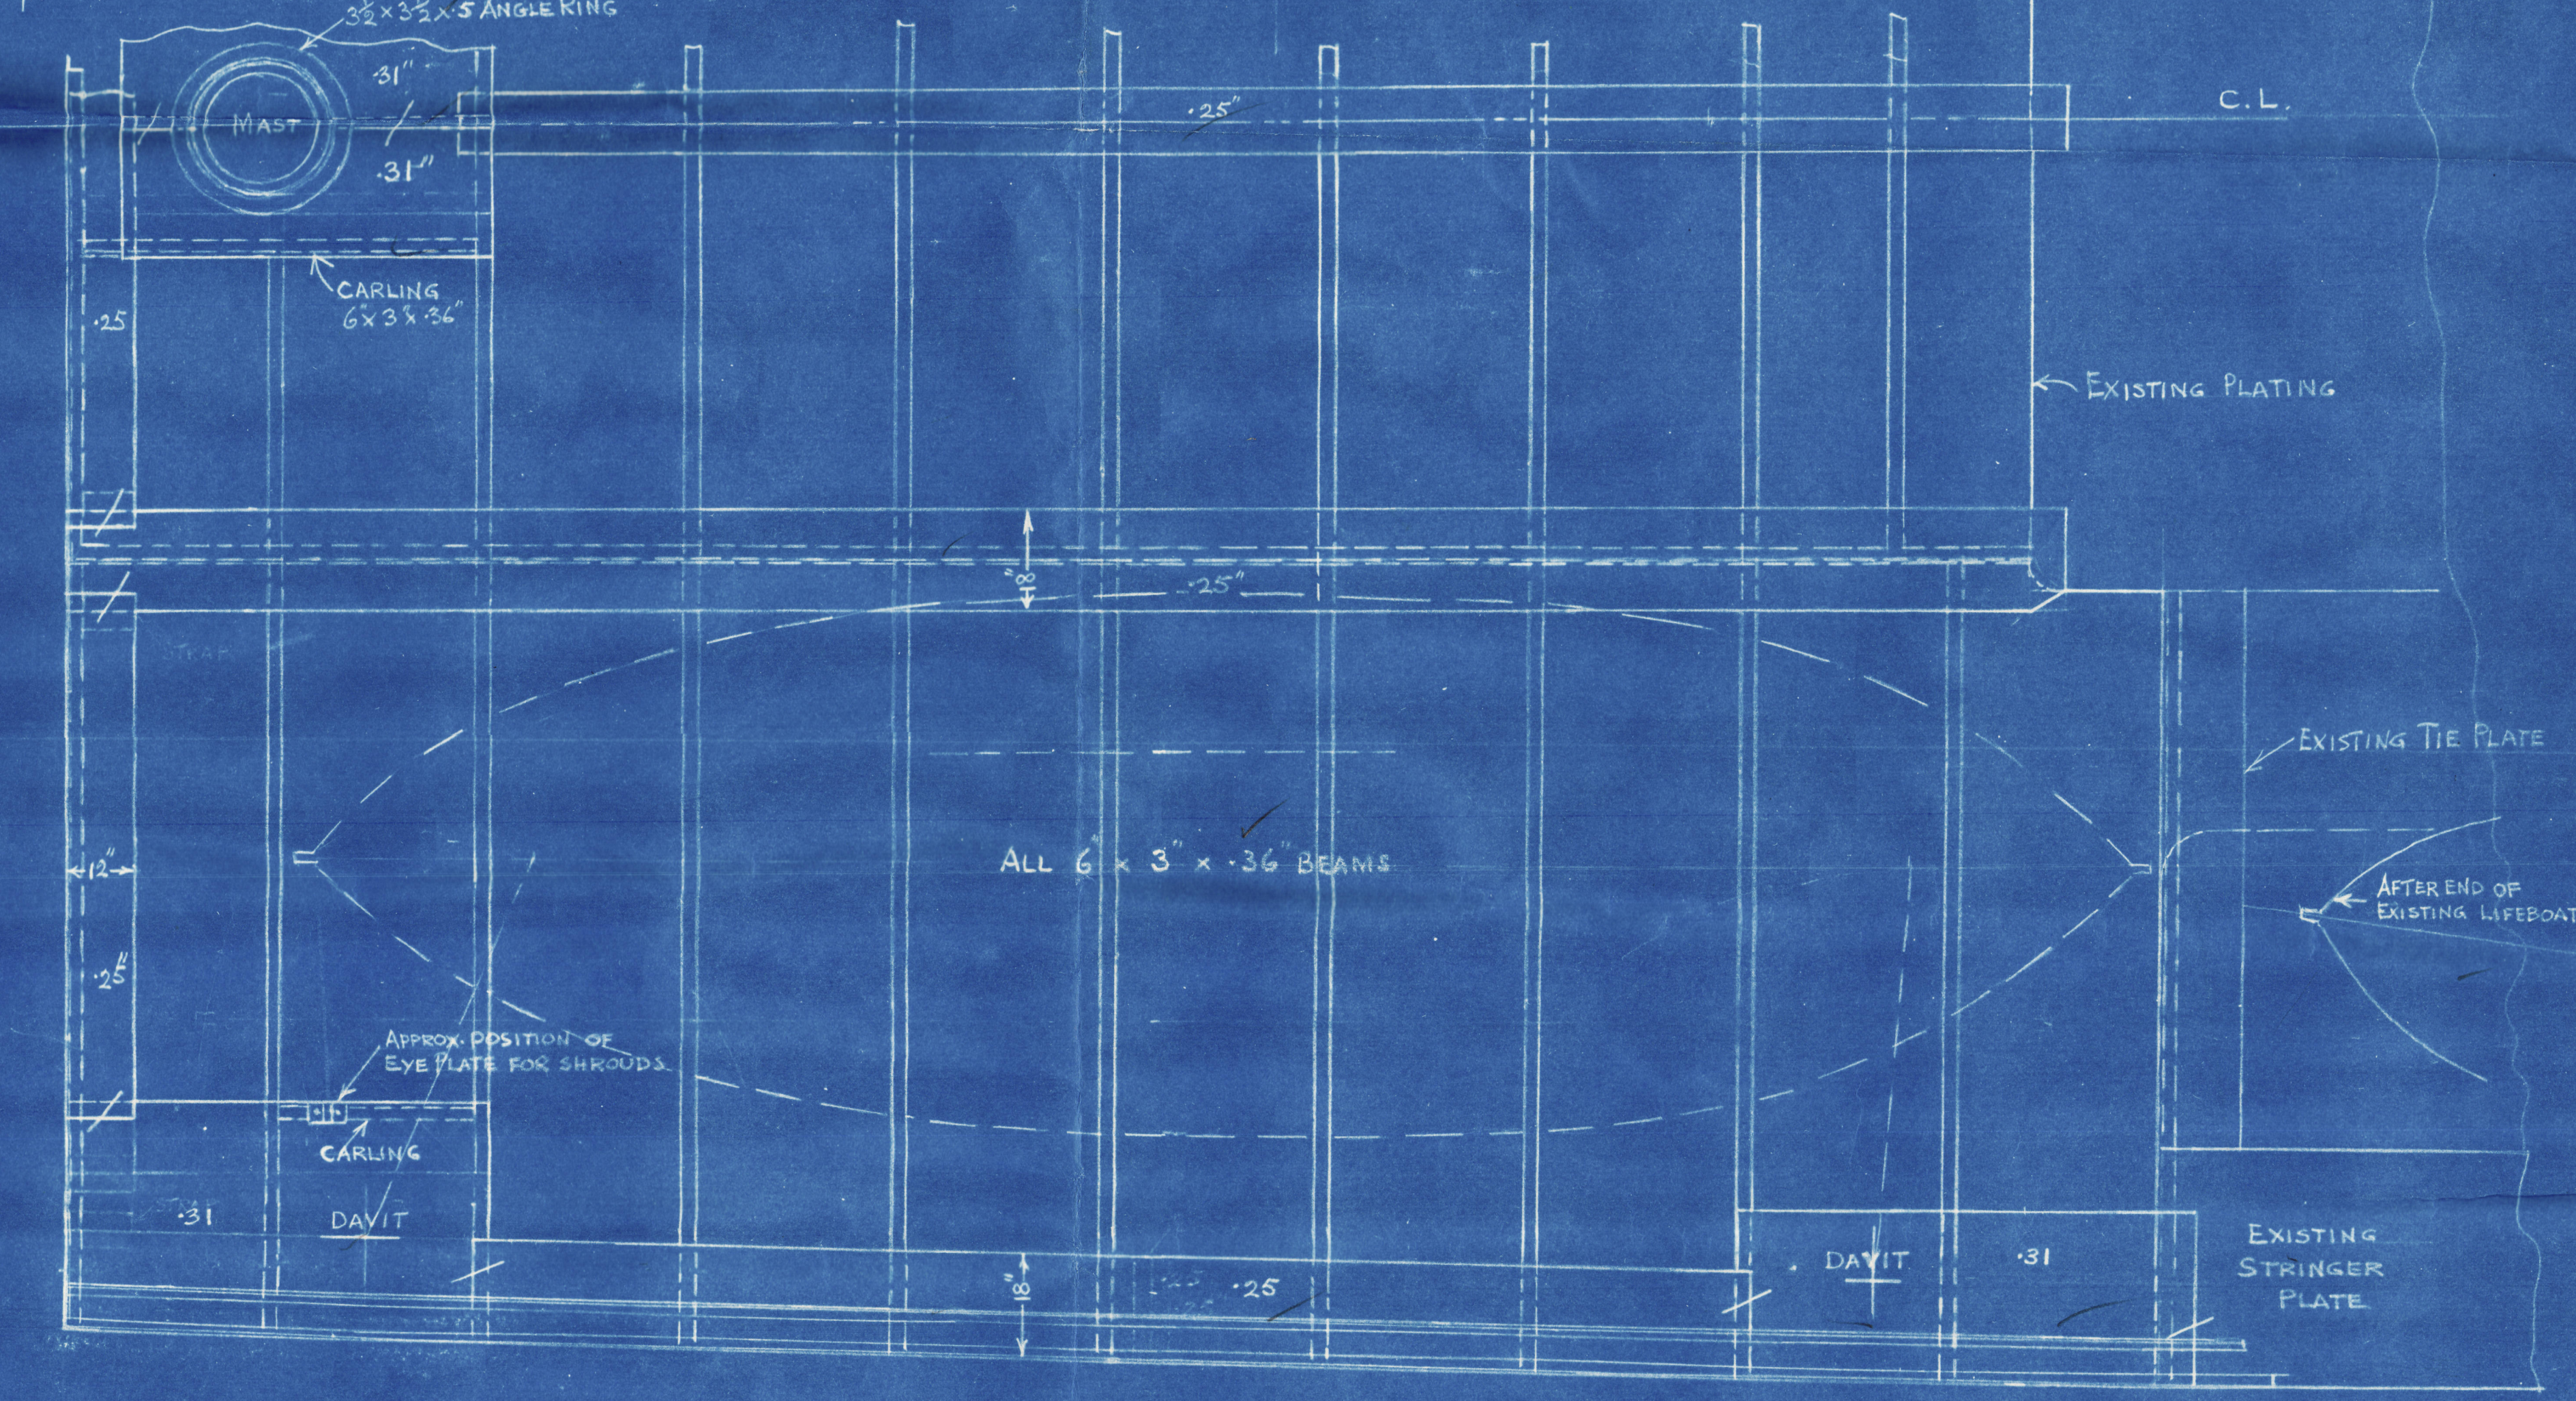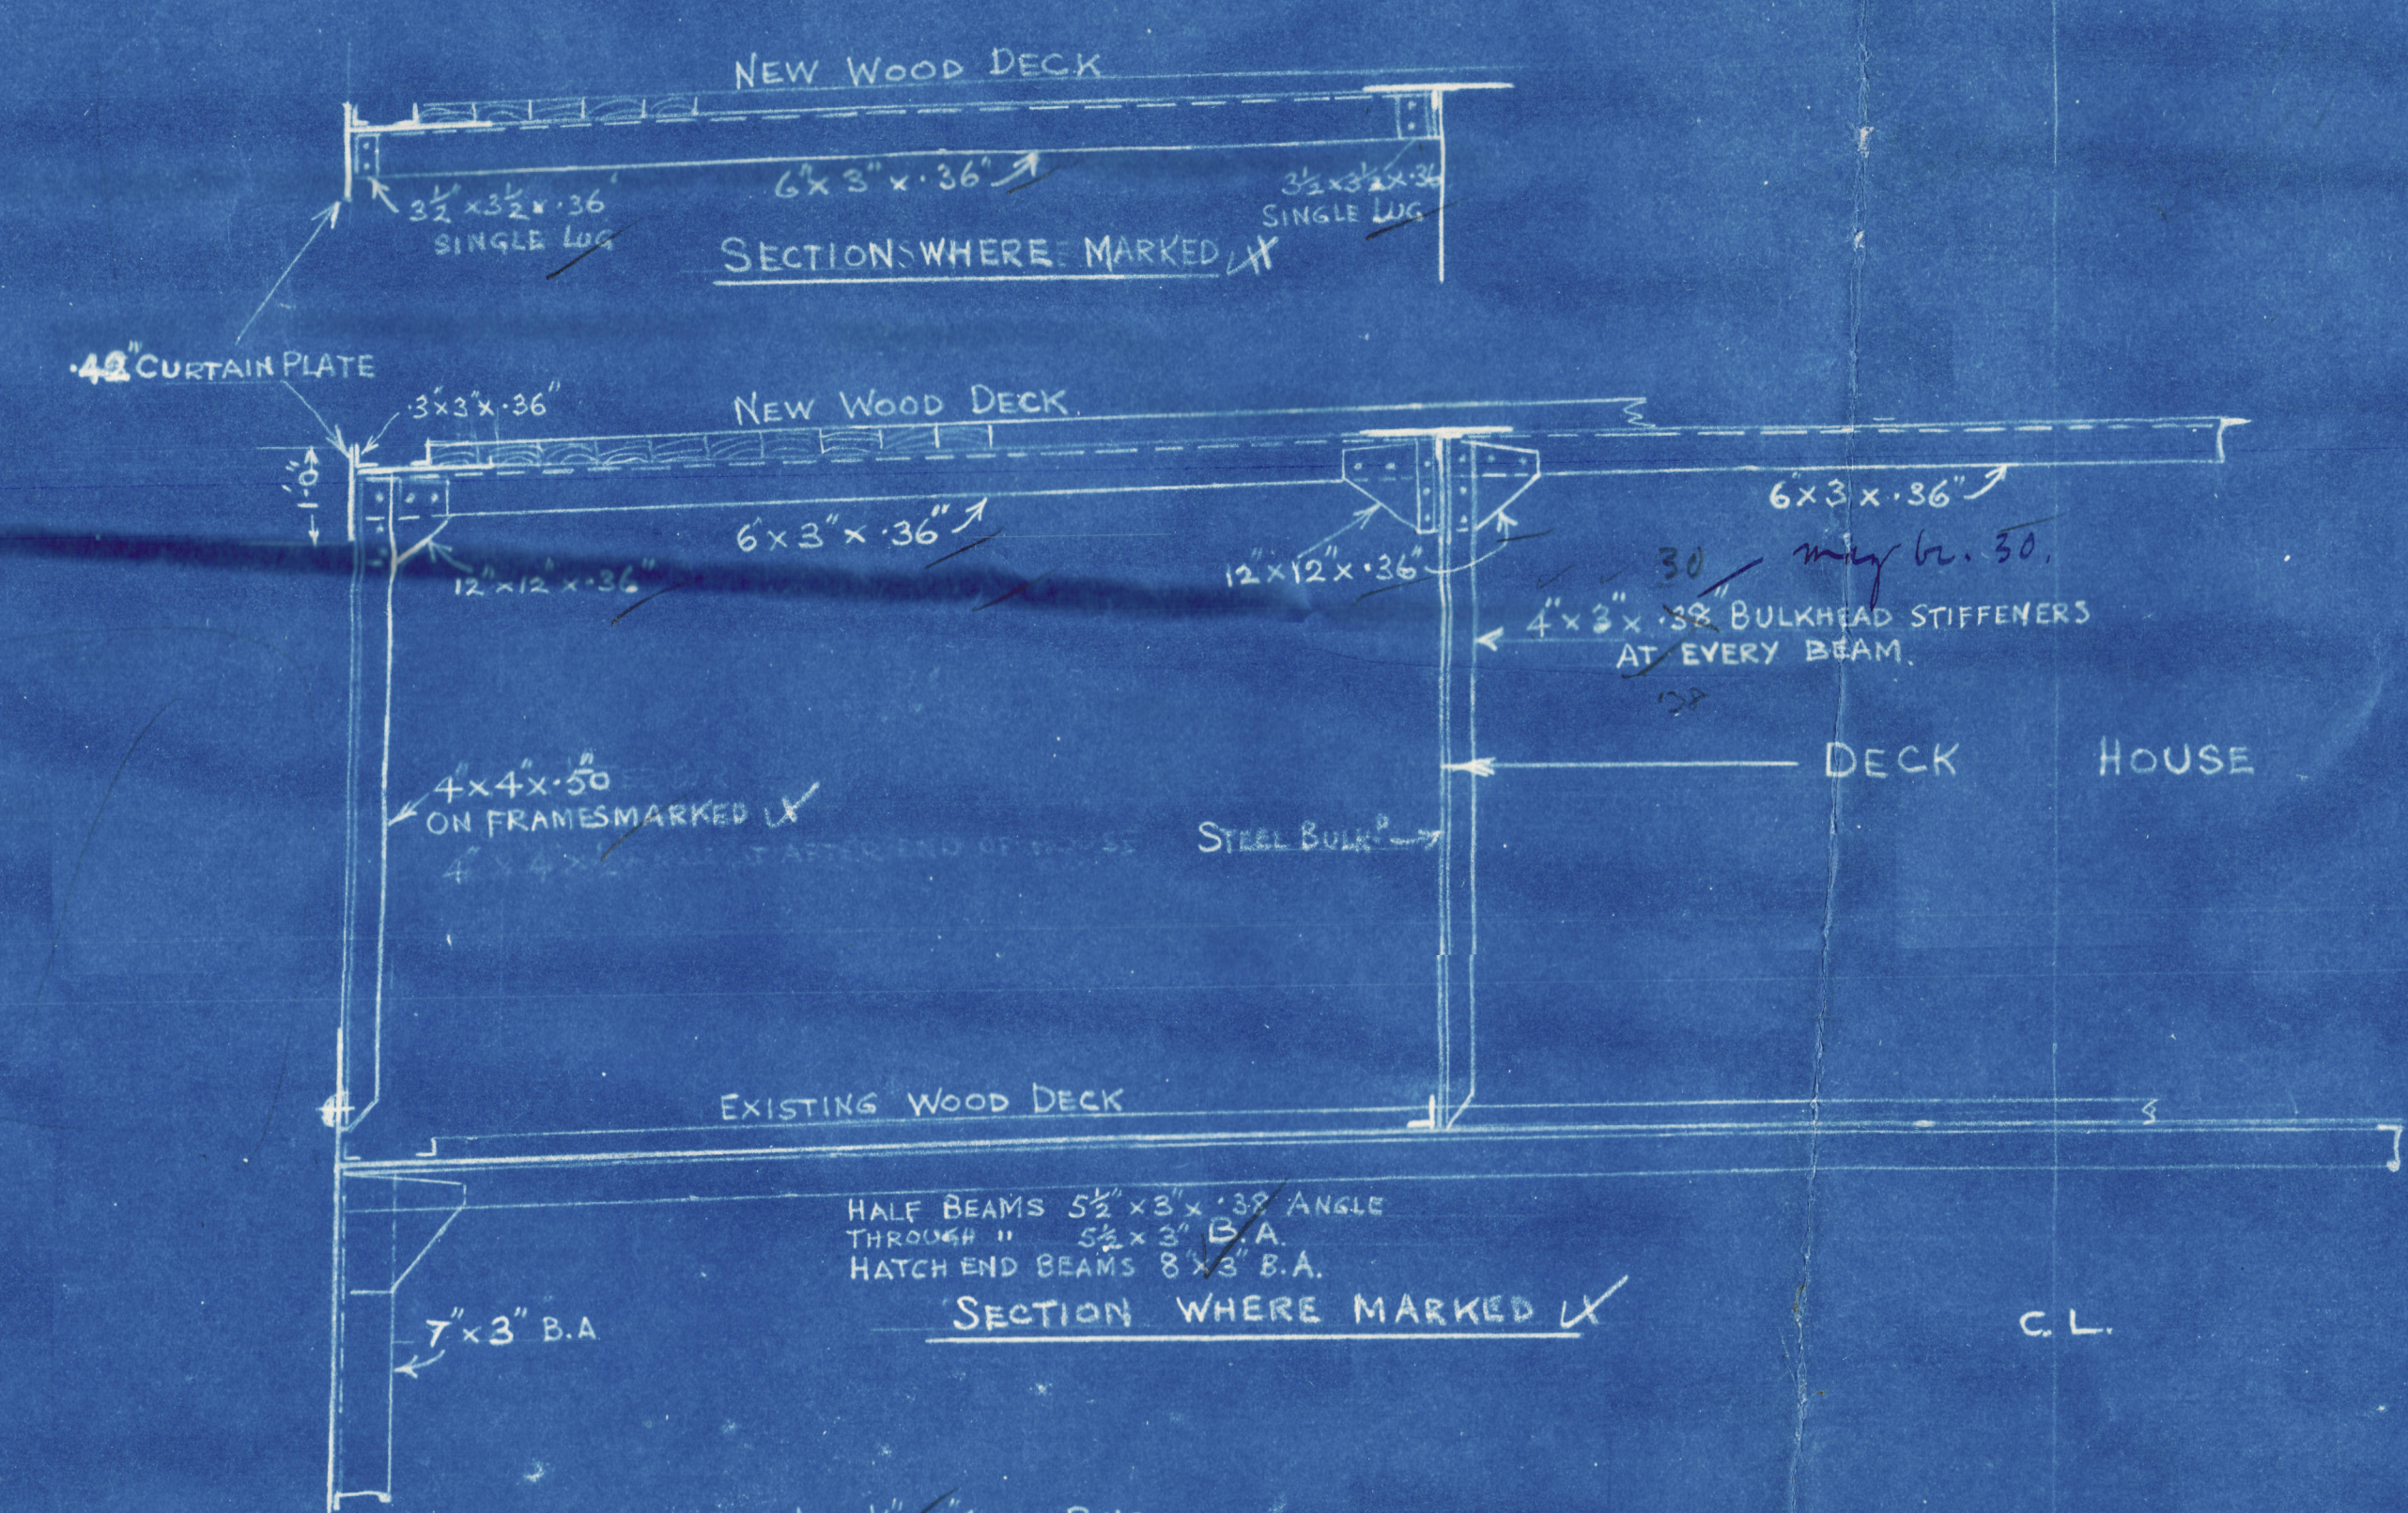

PLAN AT TOP OF HOUSE

GUTTERWAY BARS TO JOIN EXISTING G

1/8 3/4


DRAKE

ALTERATIONS

DECKHOUSE AFT ETC

8¹/₂ " Drake "

London Report No. 100640

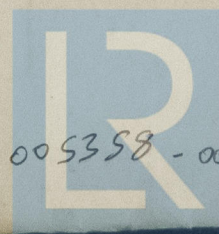

© 2021

005358 - 00 5366 - 0123
Lloyd's Register
Foundation