




9/8/34

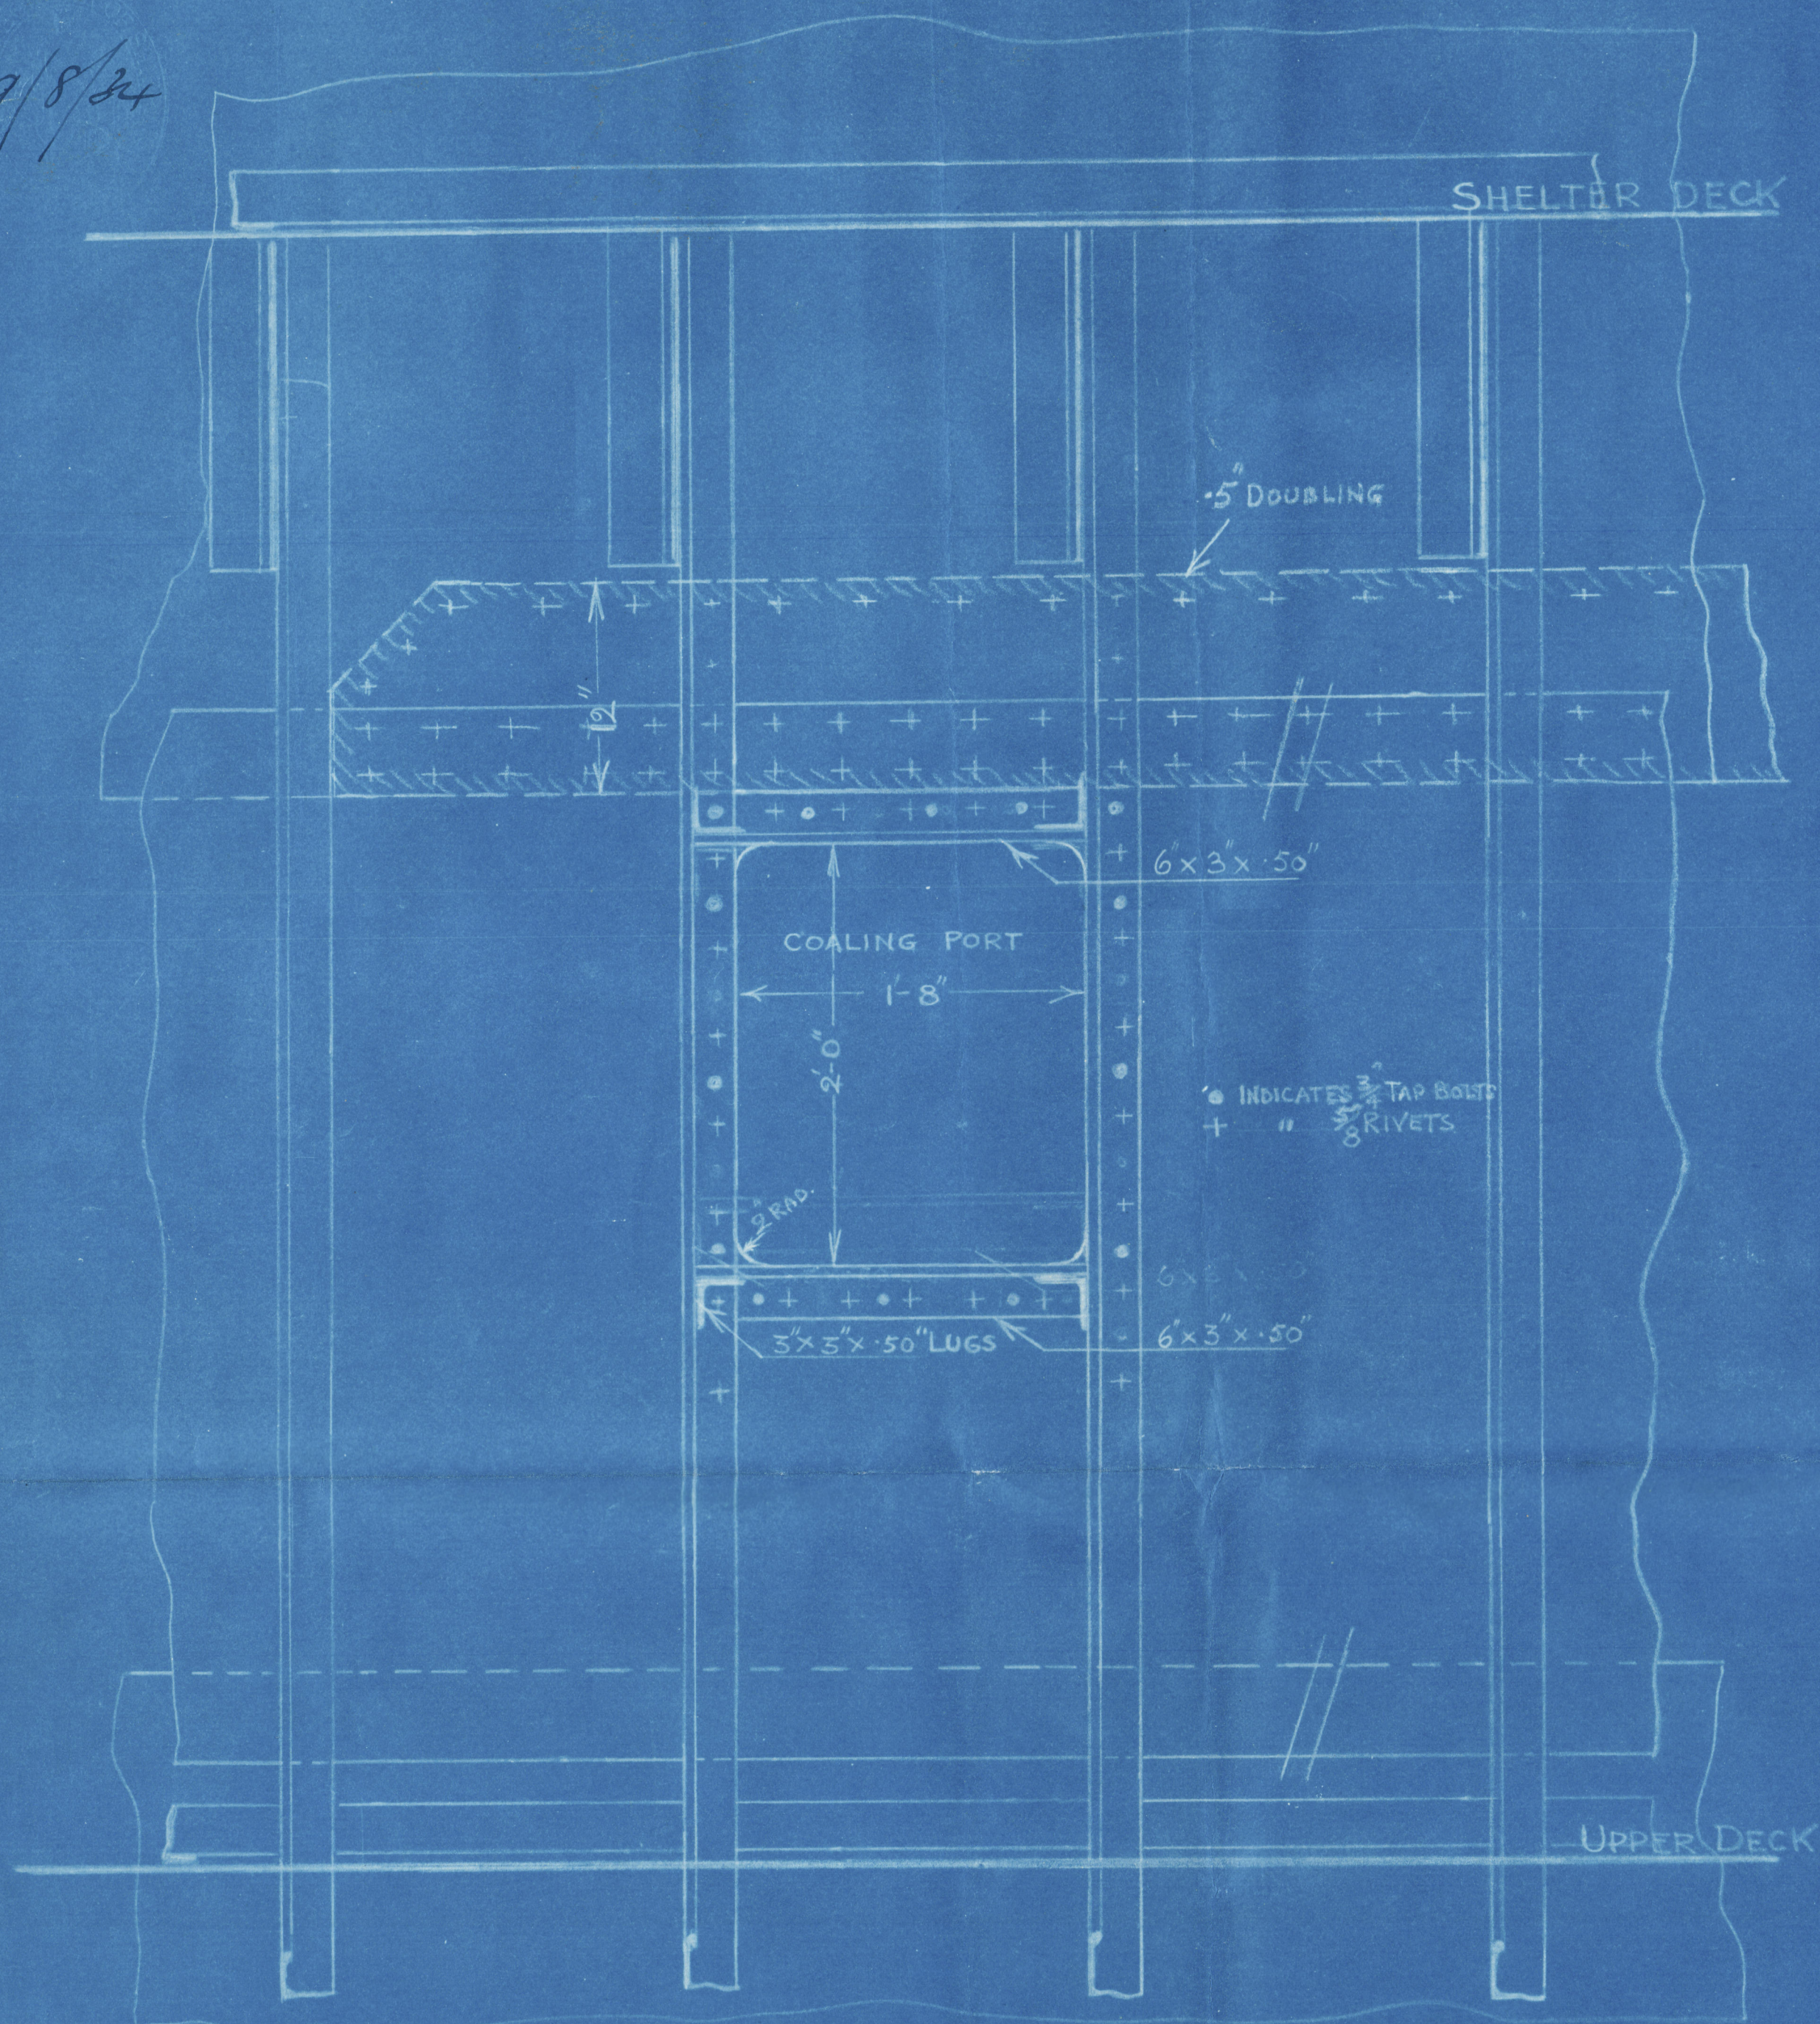

ELEVATION

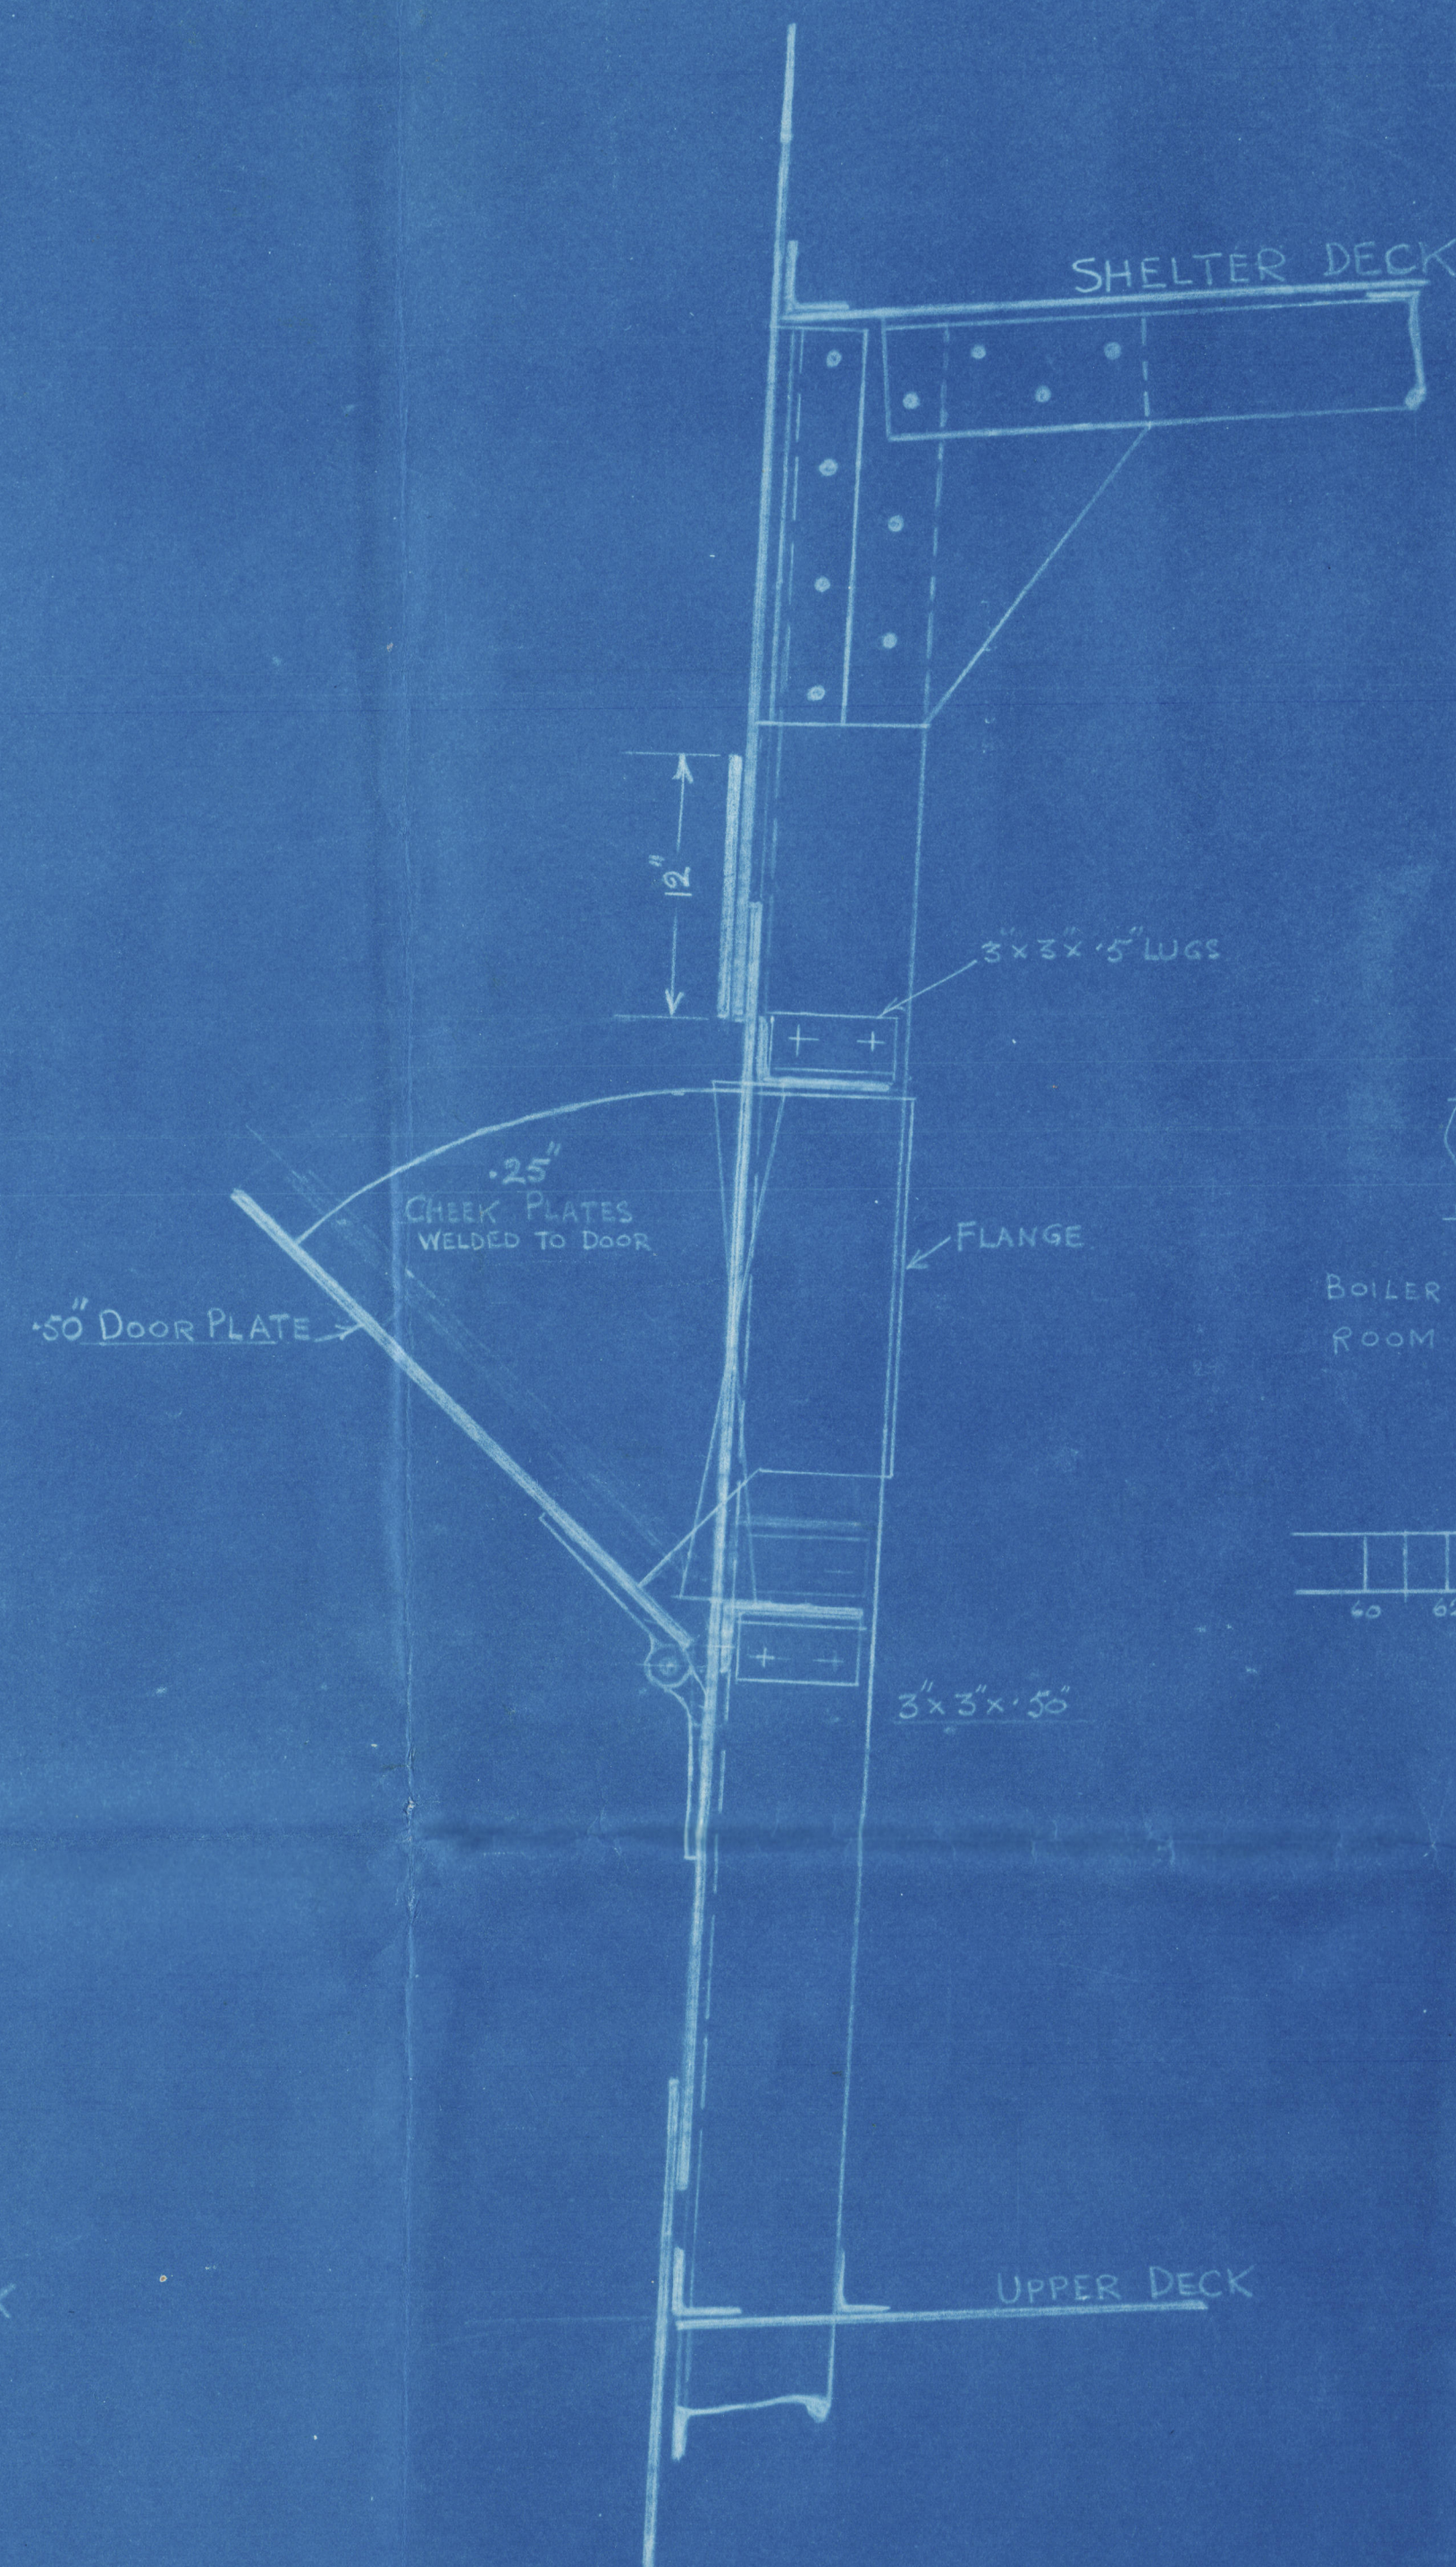

SECTION

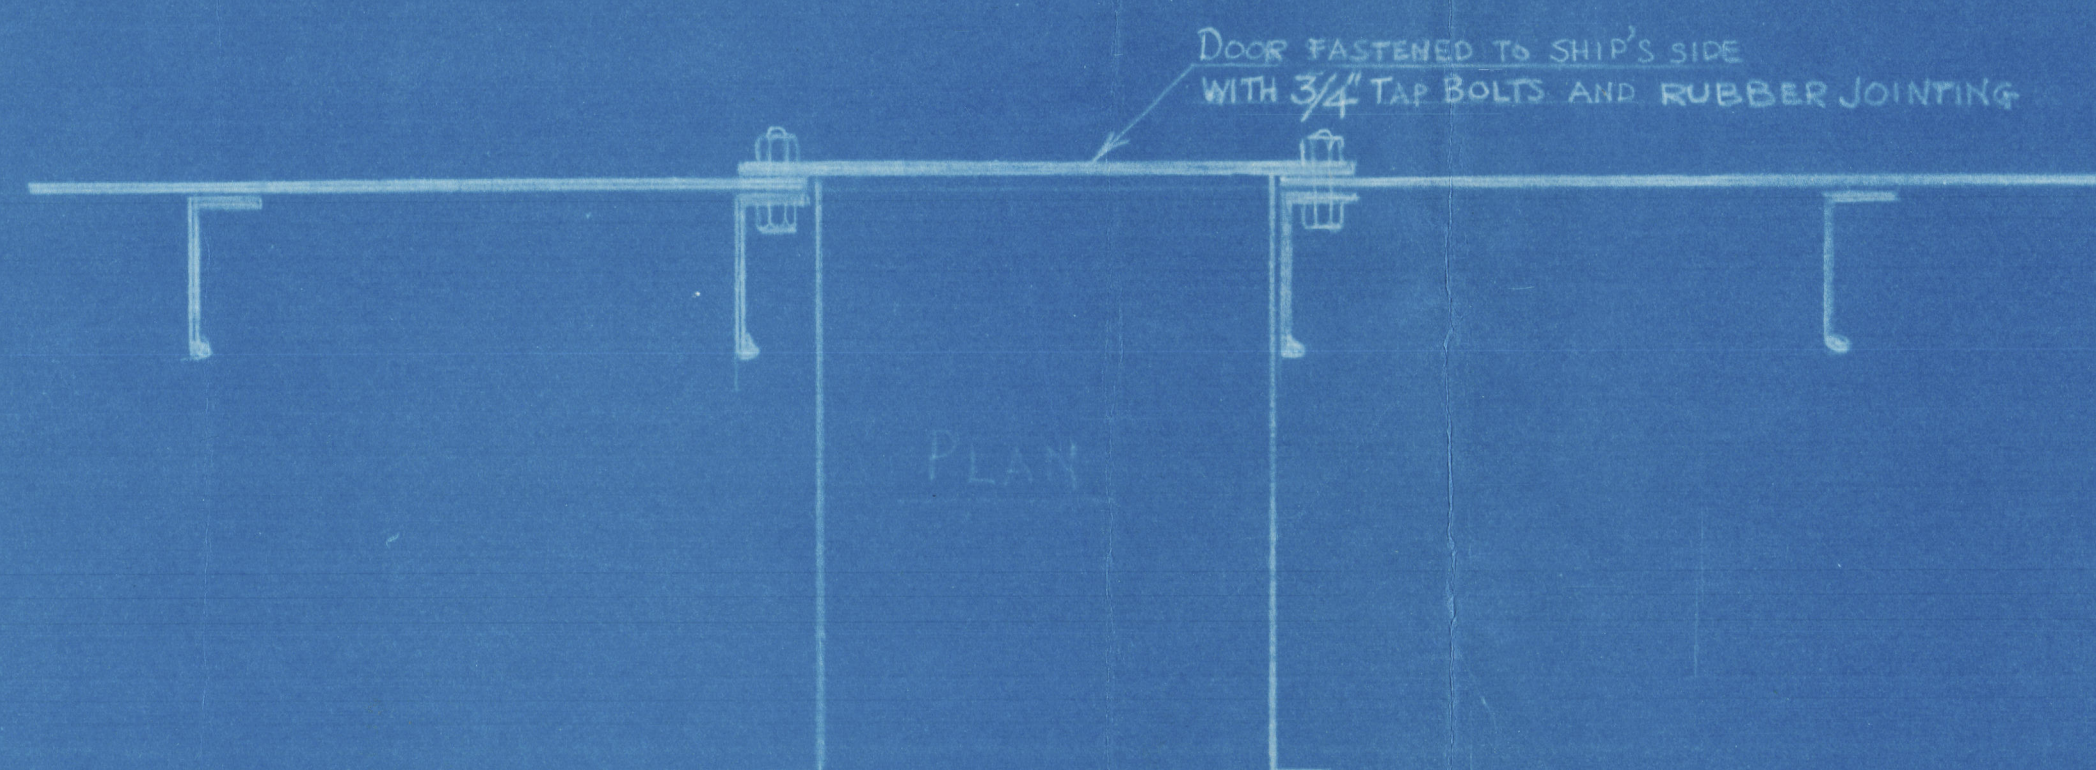


PLAN

PLAN

# S.S. DRAKE

## NEW COALING PORTS

SCALE 1 1/2" = 1 FOOT

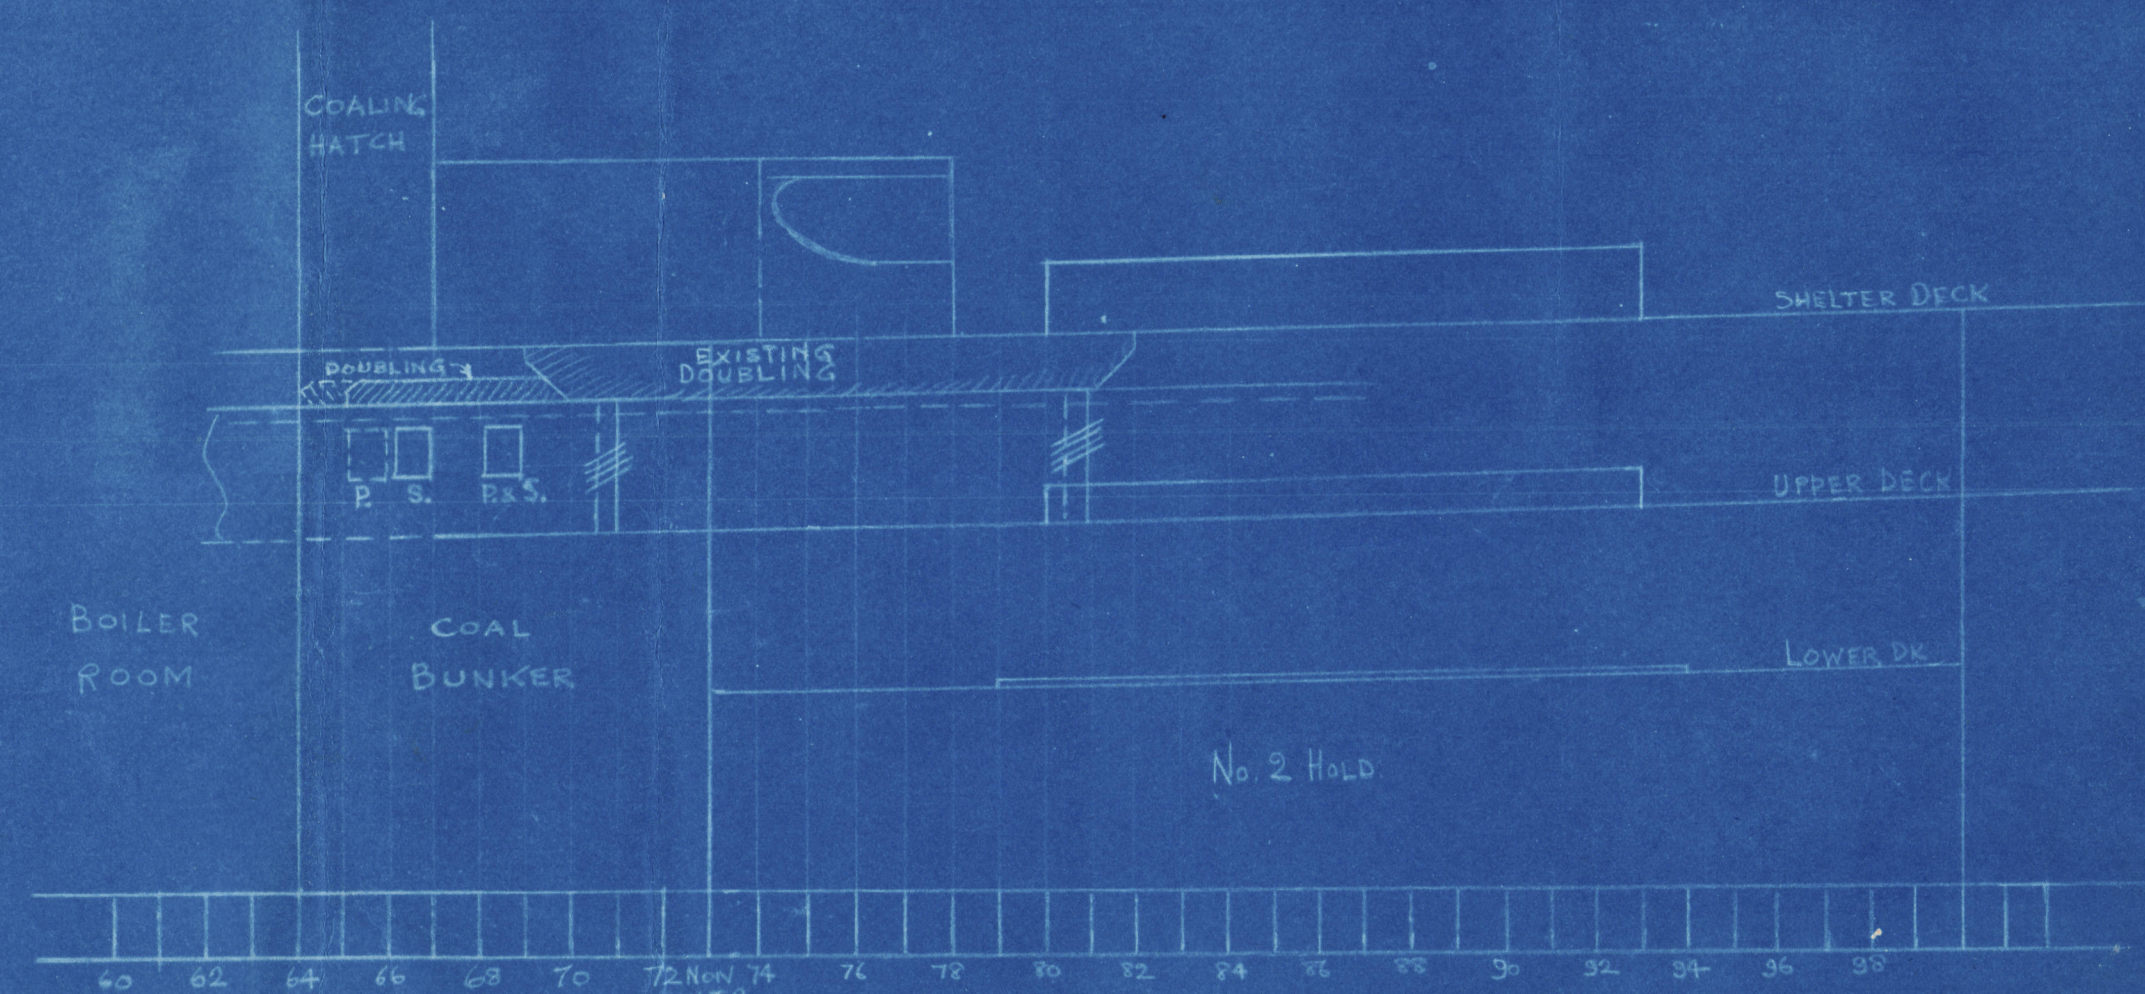

ELEVATION SHOWING POSITIONS OF COALING PORTS

R. & H. GREEN AND S. LEYWEIR, LTD.	
GENERAL OFFICES: 4 & 5, LONDON, E.	
STAFF DRAWING OFFICE	
16477	D.41
DRAWN BY: c.f.	DATE:
CHECKED BY:	7/8/34

9.8.34


DRAKE

ALTERATIONS

COALING DOORS

*7/5 "Drake"*

London Report No. 100,640

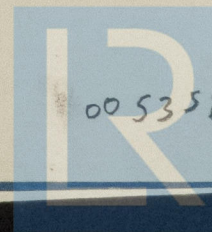

© 2021

005358-005366-0124

Lloyd's Register  
Foundation