
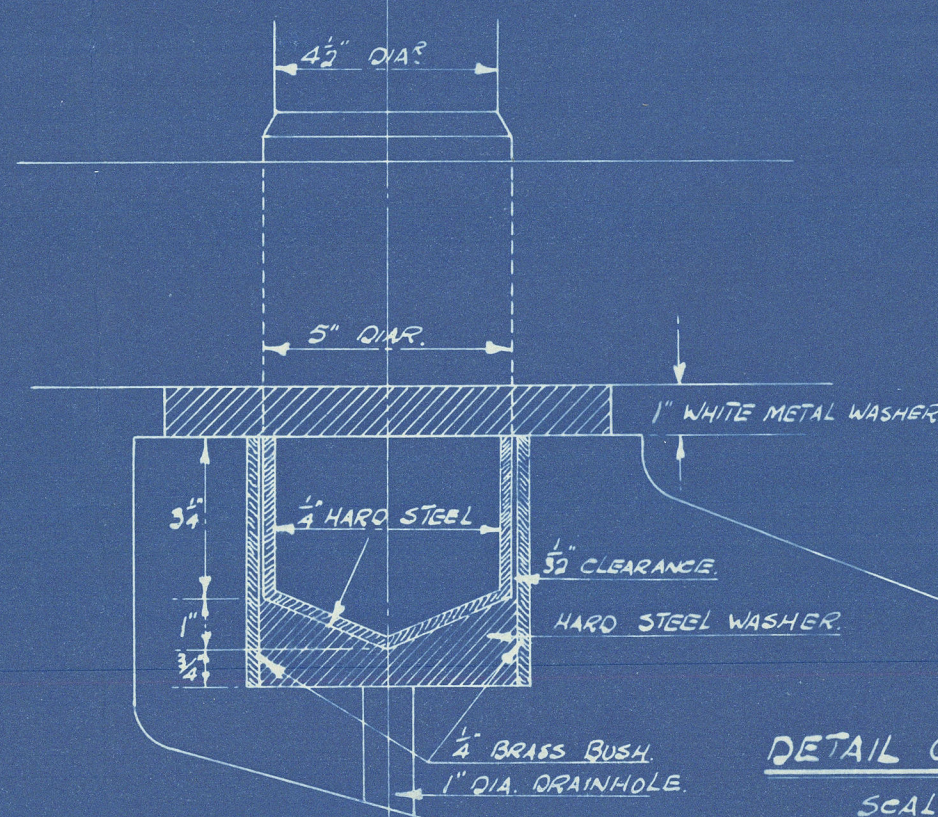
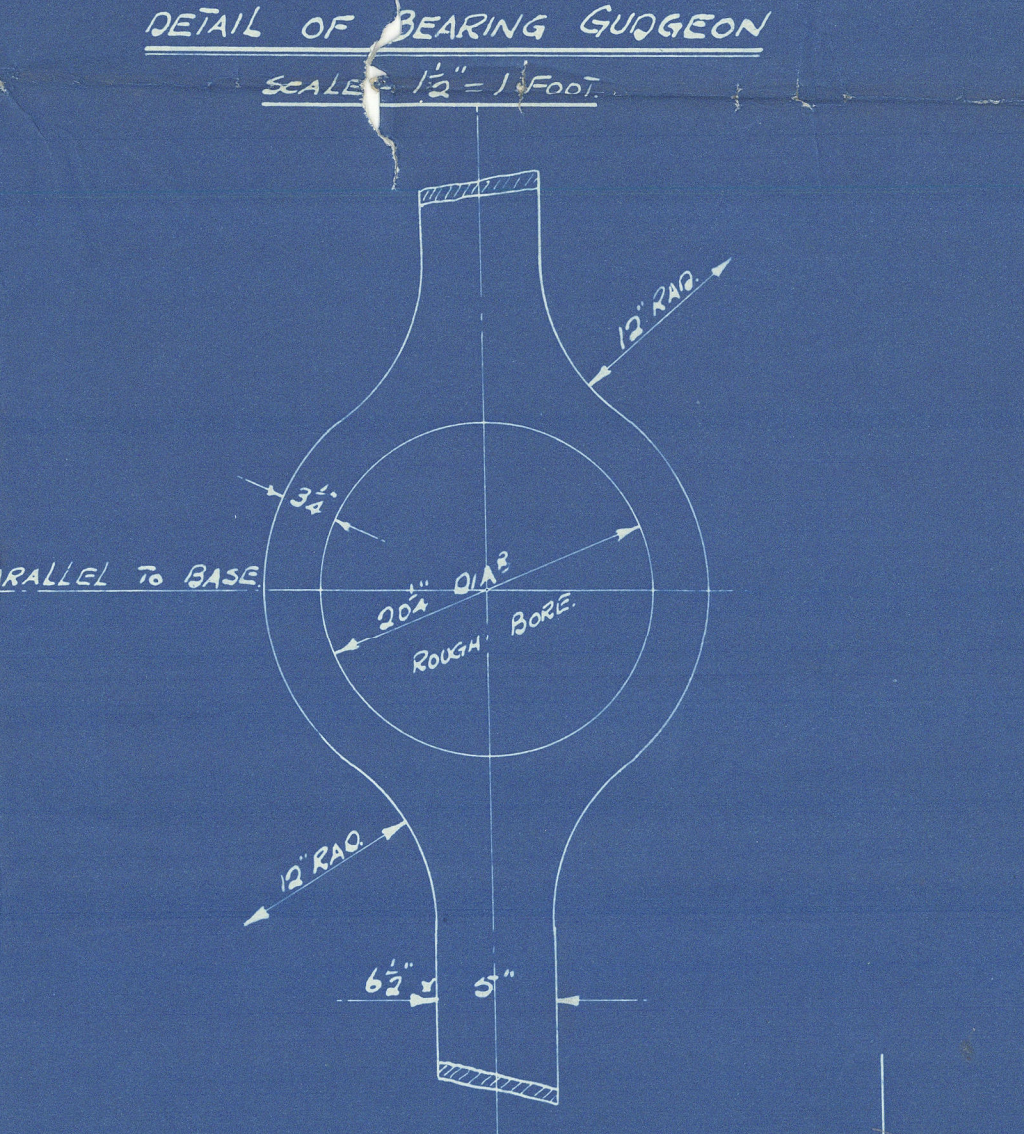
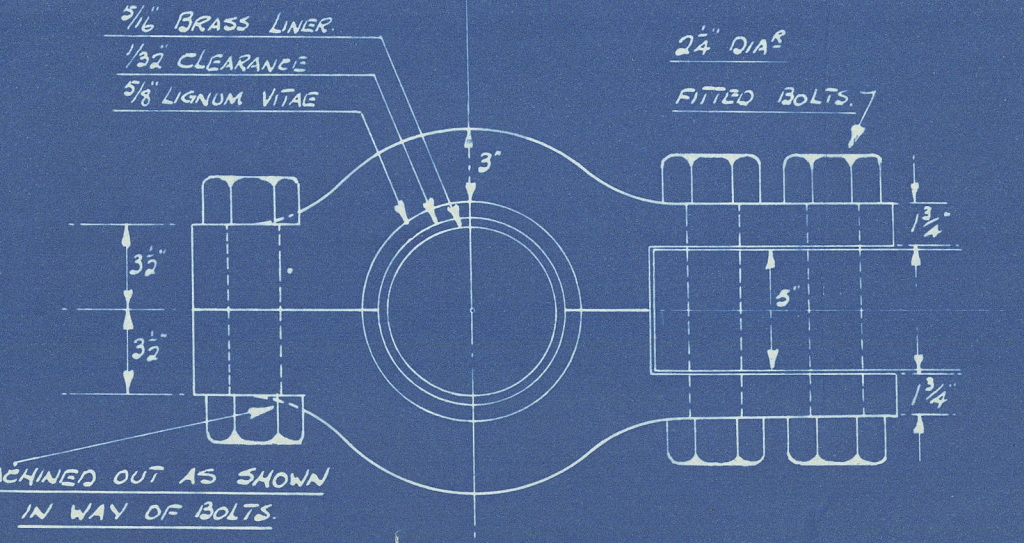
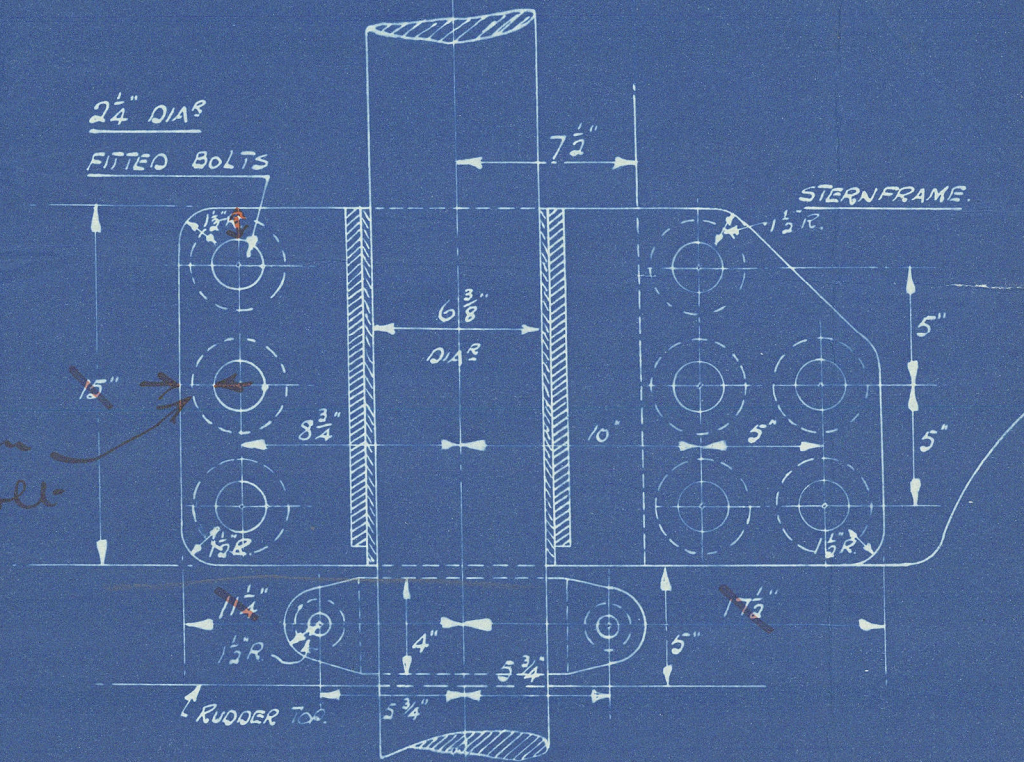
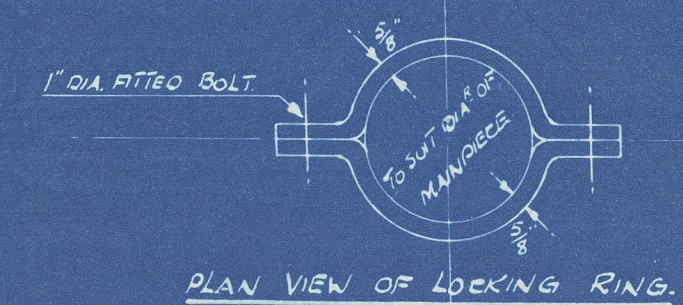
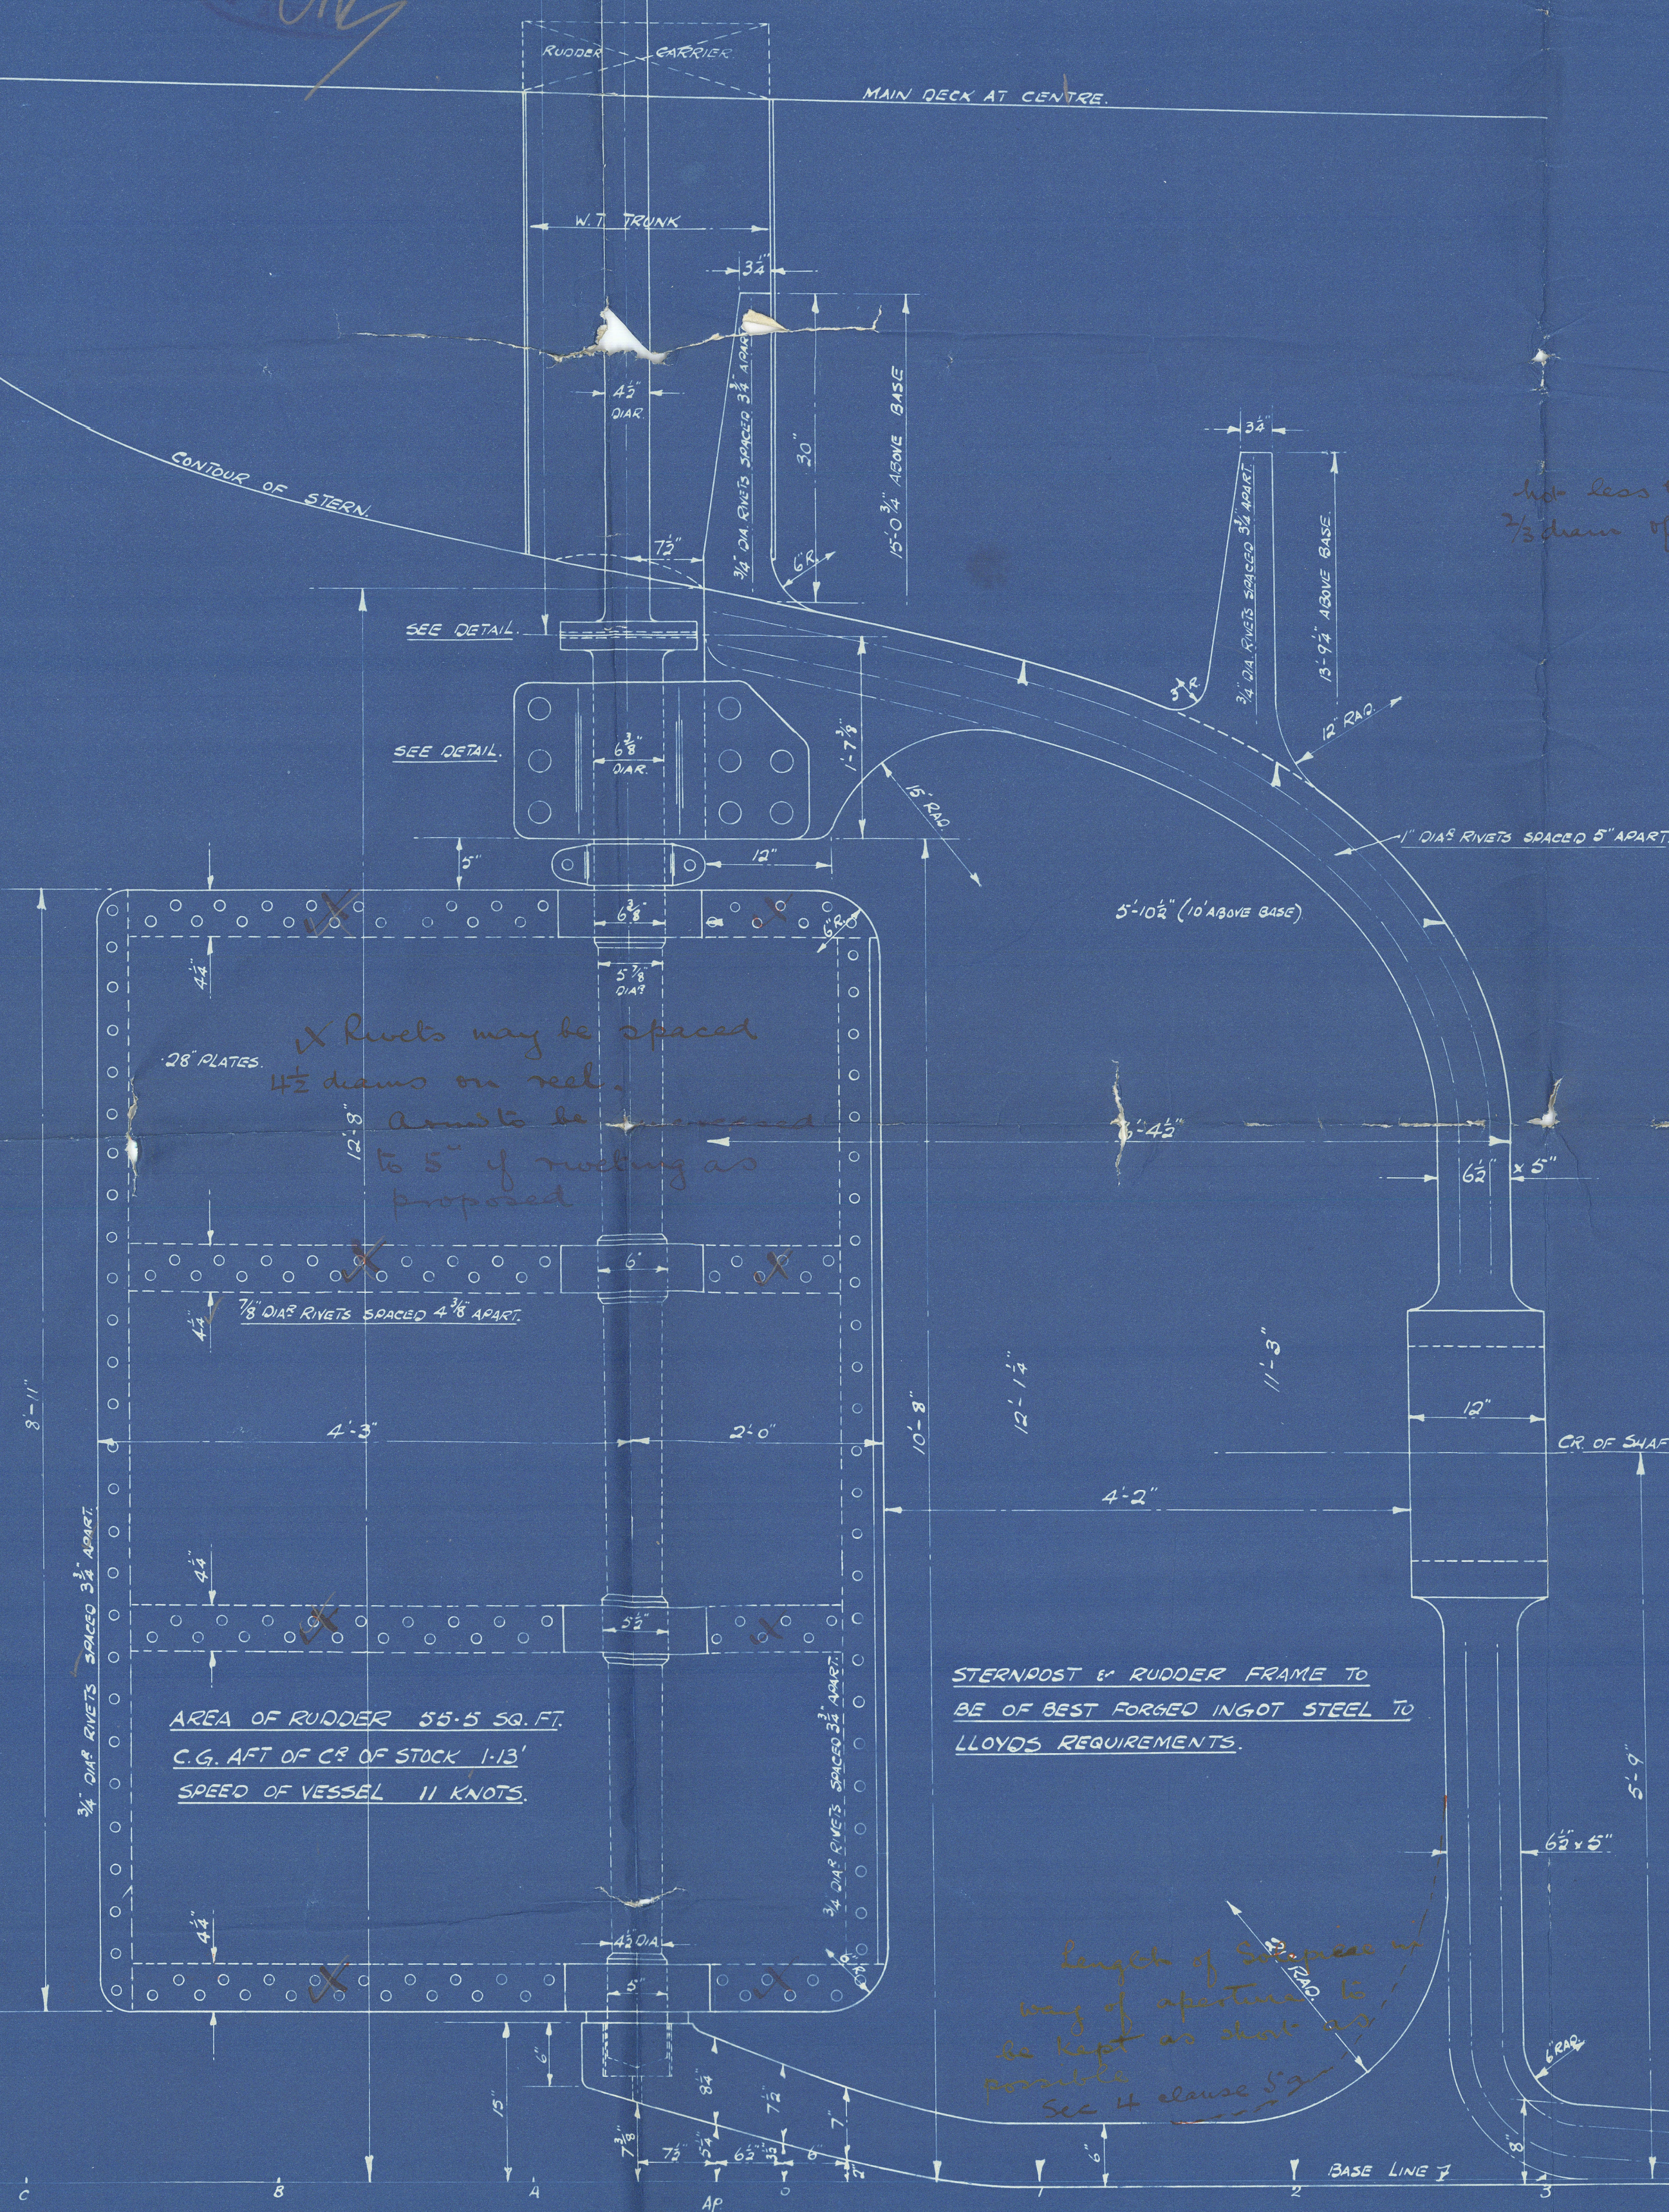
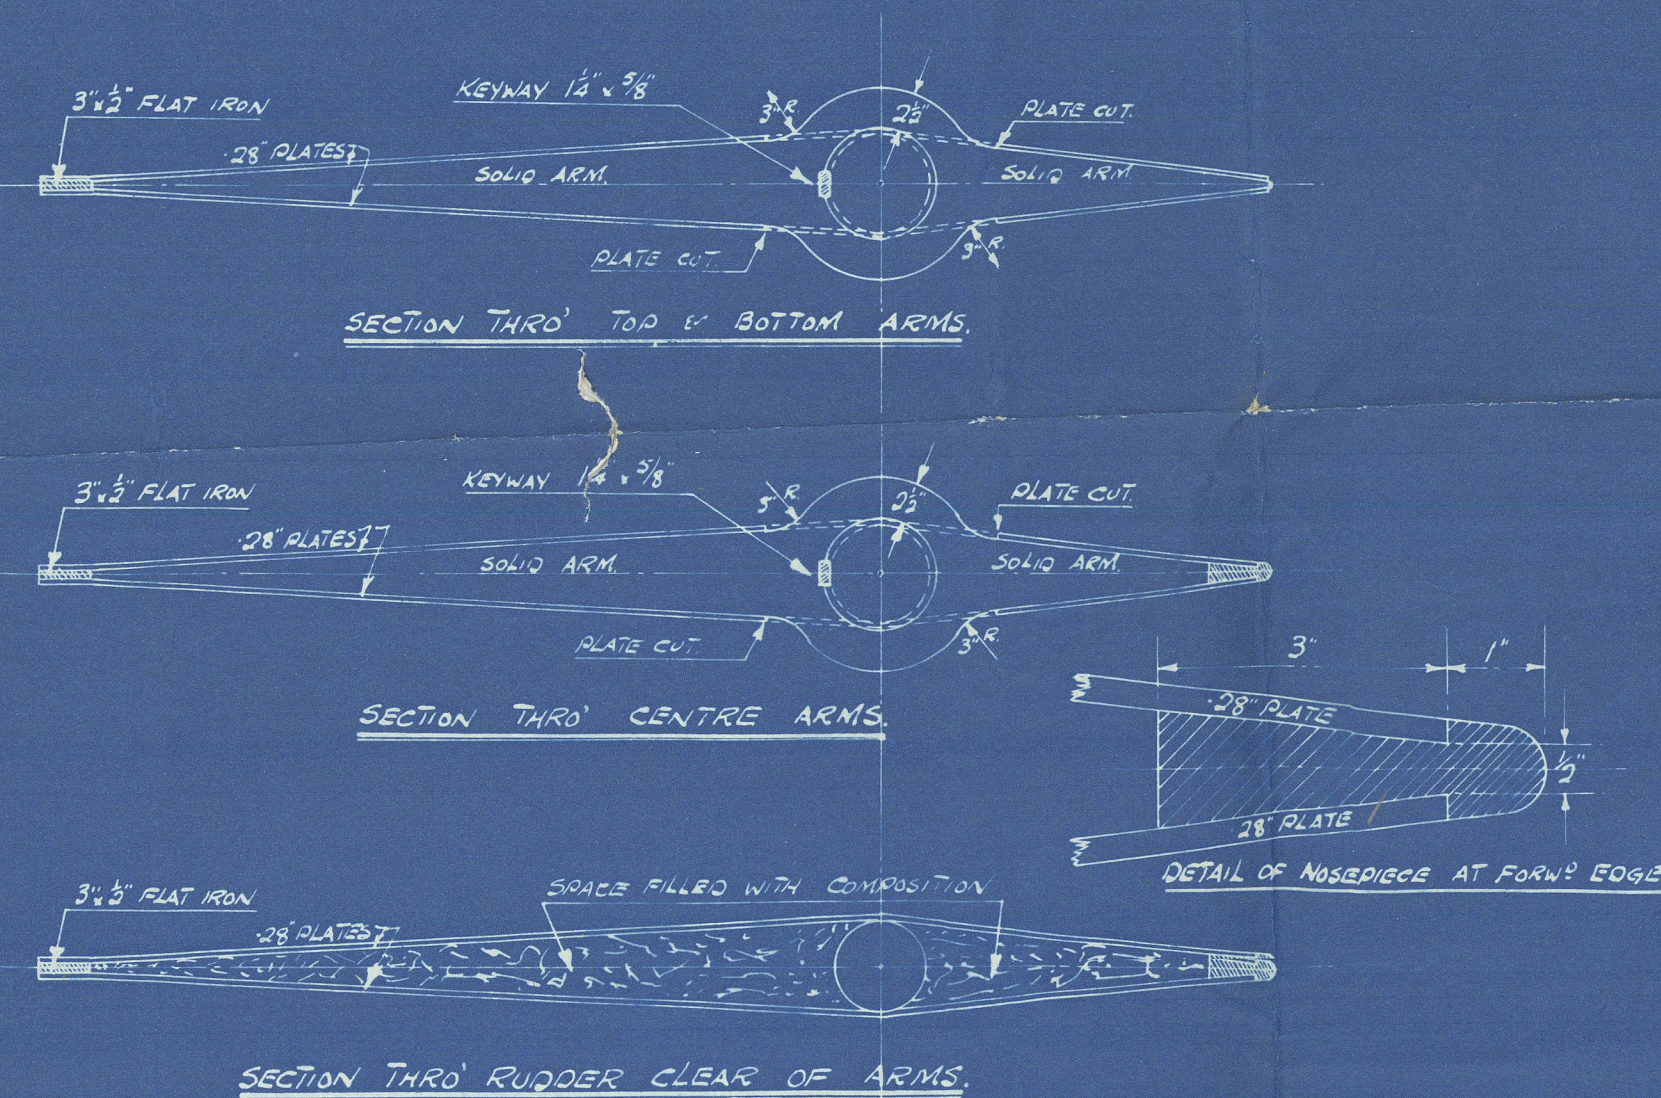


Nos. 362 & 363 SHIPS.
STERNPOST & RUDDER
 SCALE:- 1" = 1 FOOT.

AREA OF RUDDER 55.5 SQ. FT.
 SPEED OF VESSEL 11 KNOTS.
STERNFRAME AND RUDDER FRAME OF
BEST FORGED INGOT STEEL.

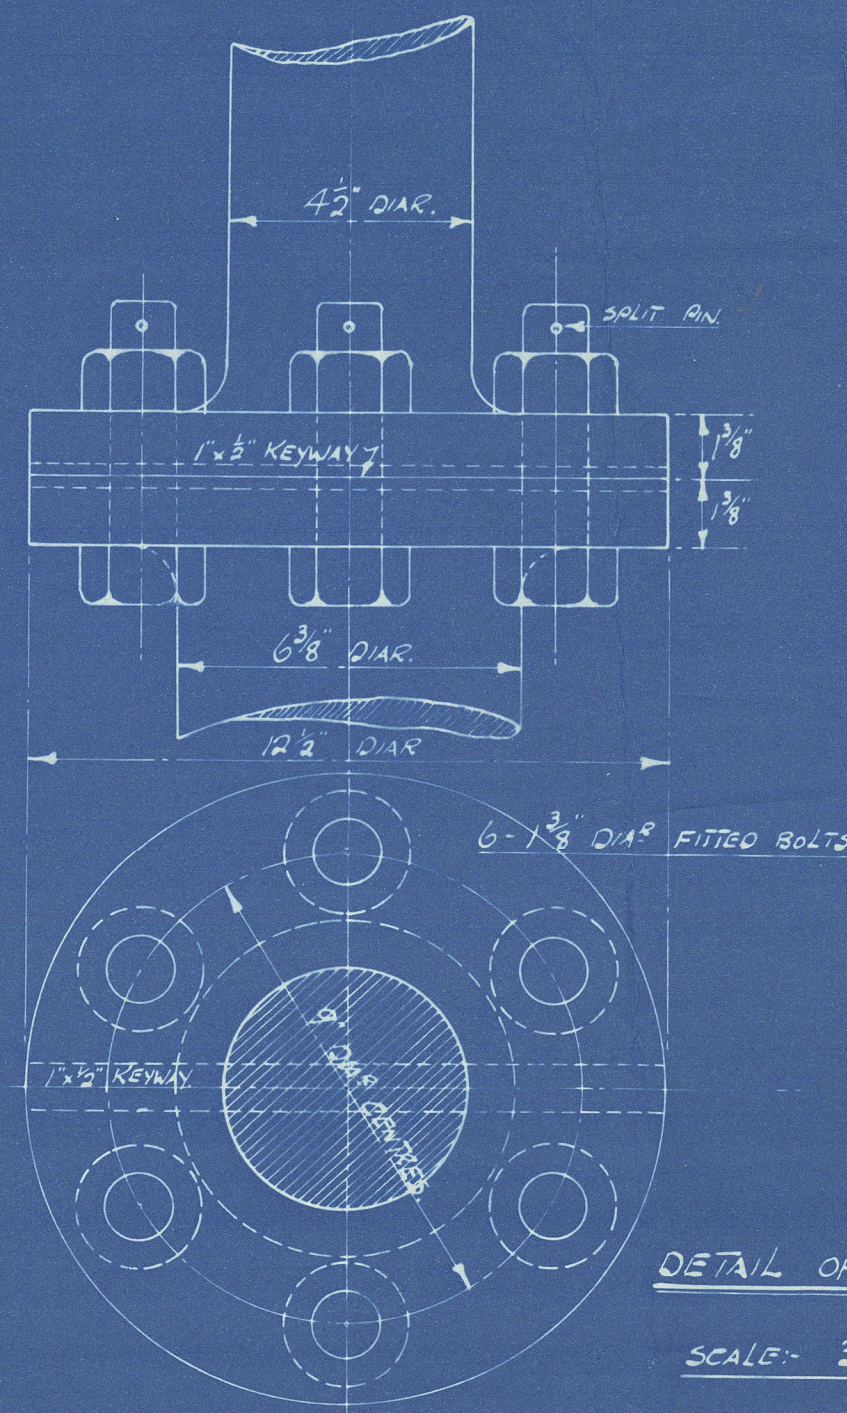

STERNPOST & RUDDER FRAME TO
 BE OF BEST FORGED INGOT STEEL TO
 LLOYD'S REQUIREMENTS.

APPROVED
 LLOYD'S REGISTER OF SHIPPING
 Date 20.12.35

005367-005376-0110

3

Messy Anderson Dkya ha

No 362/3

Quader Stenpost

No 362 "DEVON COAST."

No 363. "DORSET COAST."

GLASGOW REPORT No. 57331

GLASGOW REPORT No. 57496

No 364 "ANTRIM COAST"

GLASGOW REPORT No. 57844

No 367. "NORFOLK COAST"

GLASGOW REPORT No. 59050

No 368 "WELSH COAST"

GLASGOW REPORT No. 59180

GLASGOW REPORT No.



© 2020

Lloyd's Register
Foundation