

SHIPS No 257.
PROFILE & DECKS

DIMENSIONS - LENGTH LWL 242'-9"; BREADTH MLD 39'-4"; DEPTH MLD 18'-6" to U.Dk, 22'-6" to R.Q.Dk
To LLOYD'S SURVEY CLASS + 100. A.I. WITH FREEBOARD CORRESPONDING TO A SUMMER
MOULDED DRAFT OF 16'-7 1/2" (NEW LOAD LINE RULES)

ALL BULB ANGLES SHOWN ARE N.B.S.




MASTS, WINDLASS, WINCH, STEERING GEAR & DECKHOUSES
SUPPORTED TO SURVEYORS SATISFACTION.

SHEER AFT 12"

SHEER FWD 39"

Bridge Deck

SHELL AT BREAK

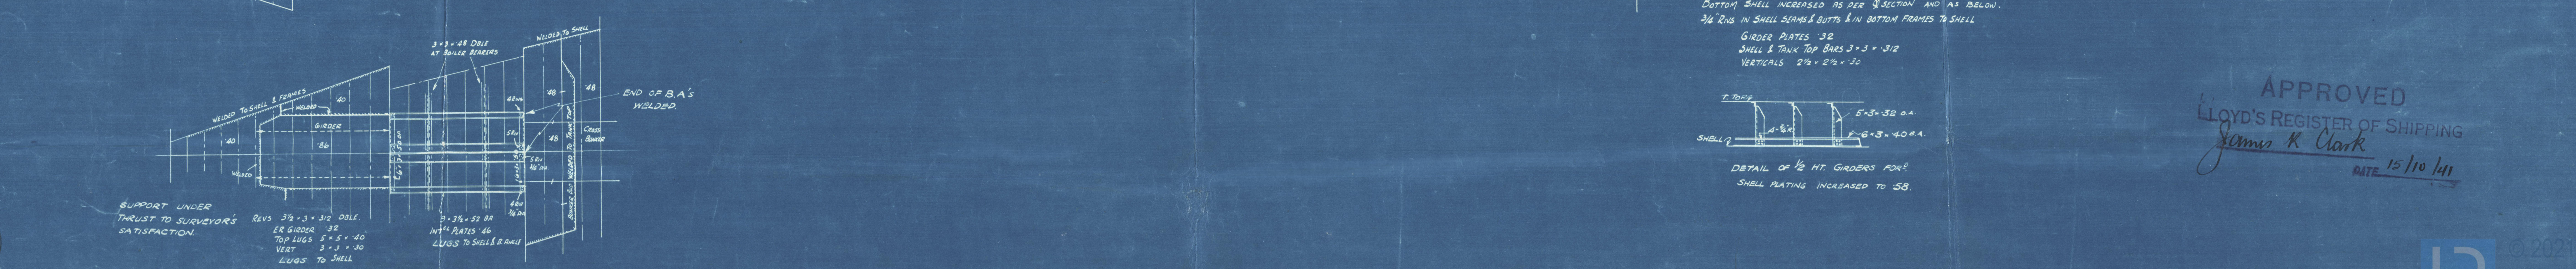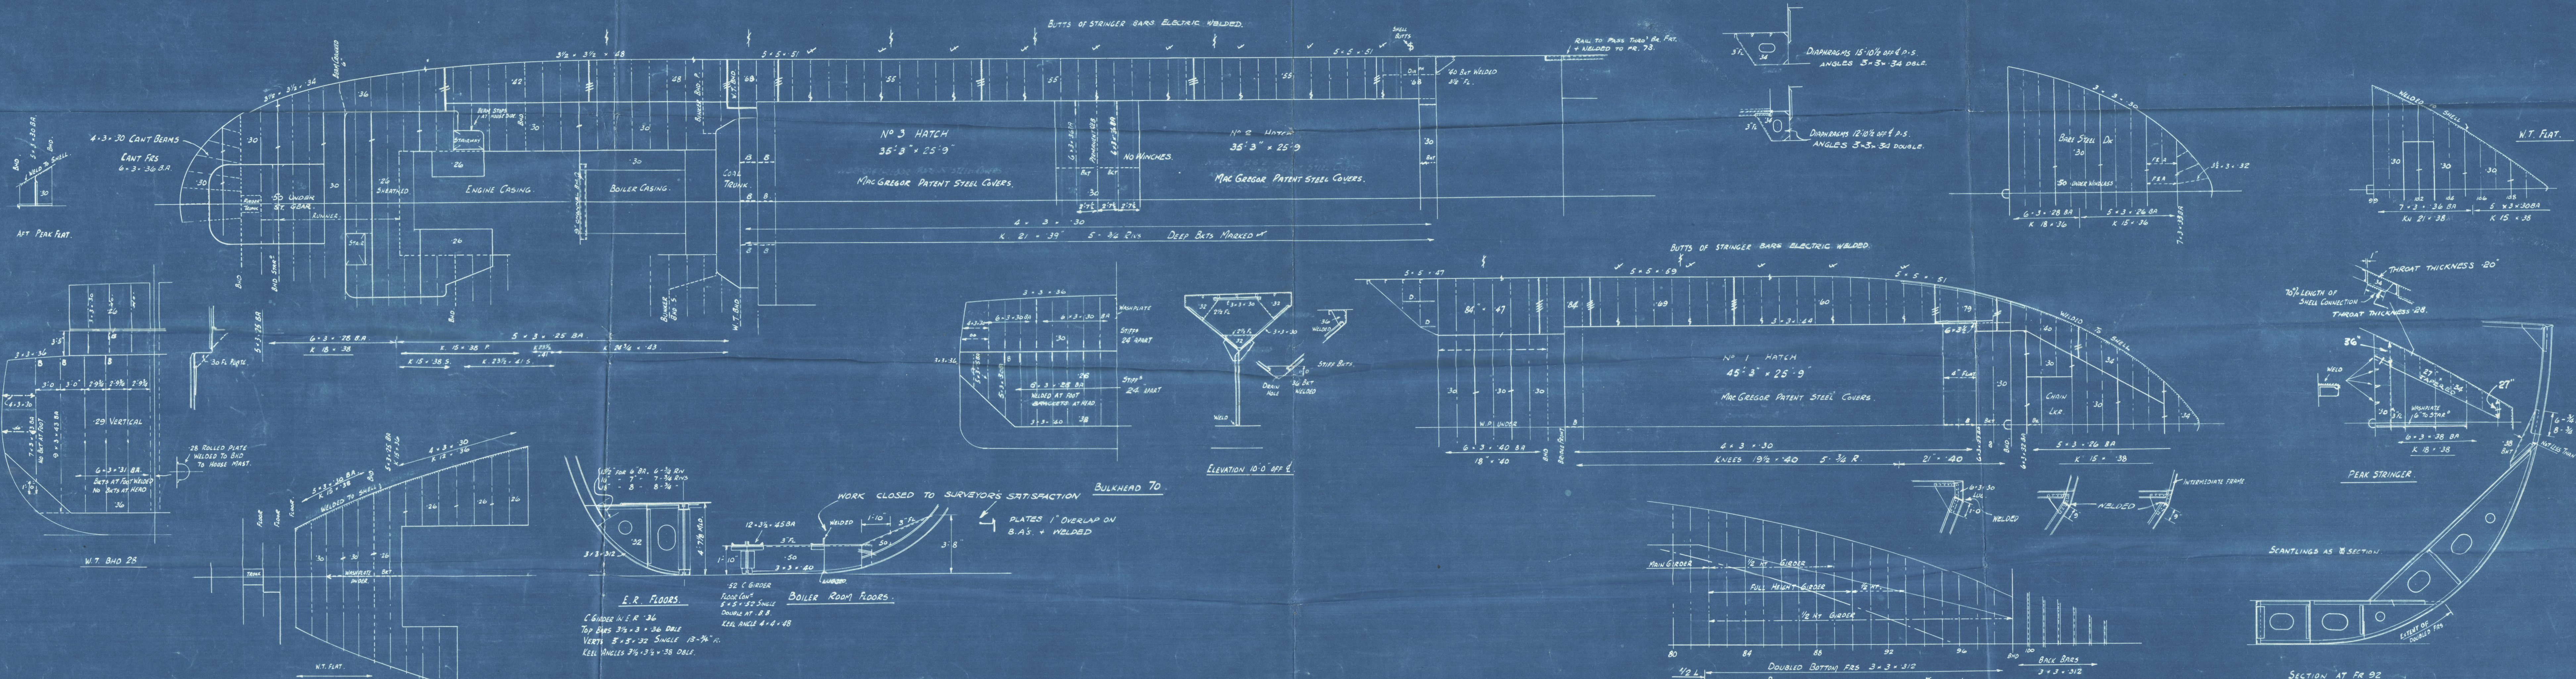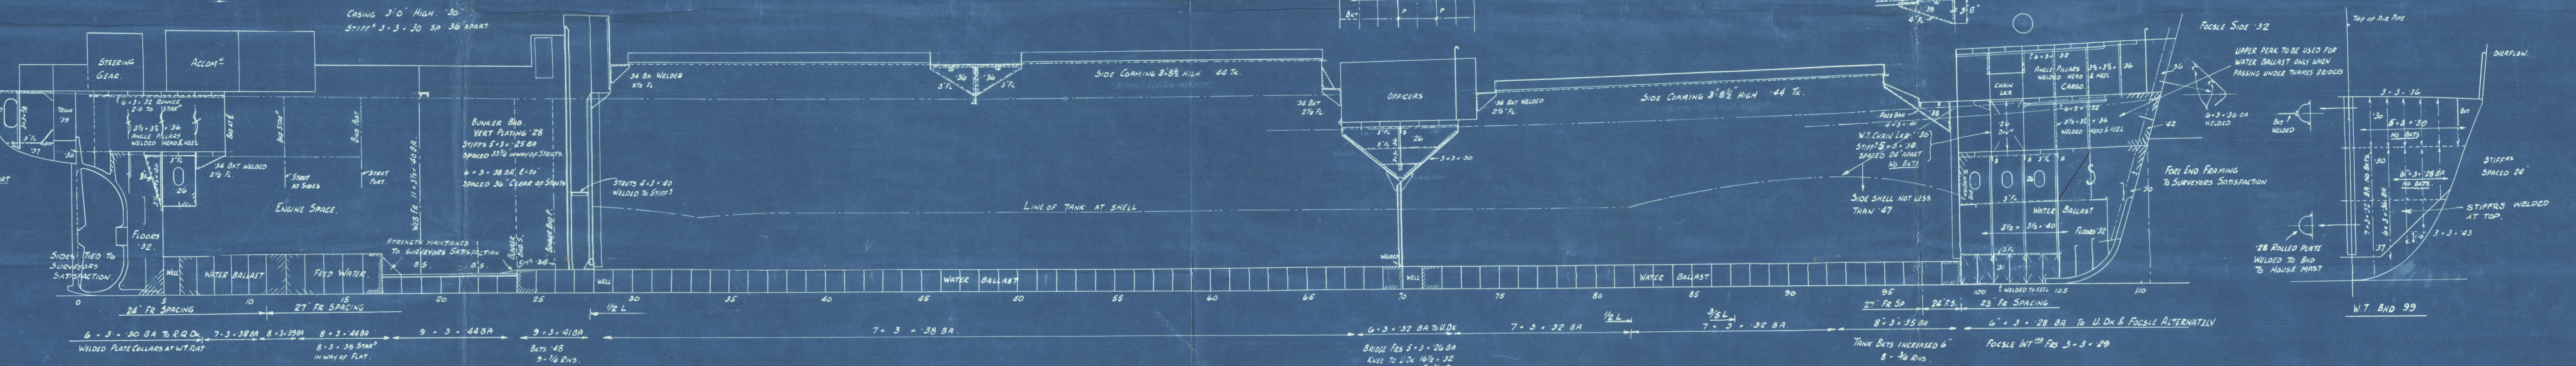

005377 - 005386 - 0260

The Burntisland S.B. Co. Ltd


Profile & Decks.

Yard N^o 257.

" WILLIAM PEARMAN "

Lth Report N^o 20674

RECORDS DEPT.
LONDON.

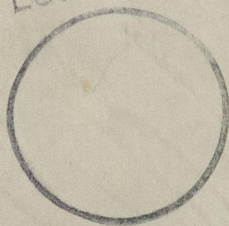

RETAIN

© 2021

Lloyd's Register
Foundation