


SCALE: 1/2 INCH = 1 FOOT.

BIERN POST	
KEEL PIECE IN SCREW APERTURE	20%
RUDDER STOCK	
RUDDER STOCK SECTIONAL AREA	20%
RUDDER	
RUDDER PLATE	10%
FLAT PLATE KEEL	
PLATES CONNECTED TO STEM & STERNPOST	20%
FLOOR PLATES	
SOLID FLOORS UNDER ENGINE & BOILER SPACES	20%
TANK TOP PLATING	
PLATING IN E & B SPACES & UNDER THRUST	20%
DECK PLATING	
SHELTER & MAIN DECK PLATING AHEAD E & B	
CASINGS FROM FRAME 33 TO FRAME 94	10%

"d" = 20.0.

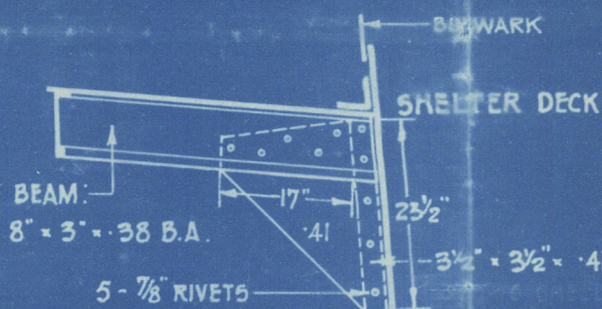

TYPICAL DETAIL OF
BEAM KNEE WHERE NO FRAME IS FITTED.

S/S Arcoona

Midship Action
As vessel built-

Wm Beardmore Esq
No. 630

Glasgow Report No. 43641



005387-005396-0002