

COPY.

Rpt. C. 11 (Contd.)

Index No. 31219


Lloyd's Register of Shipping.

16 AUG 1951

Ship's Name S.S. "ARKABA"

Official No. 151993

Memorandum of alterations reported since ship was surveyed for assignment of Load Lines in

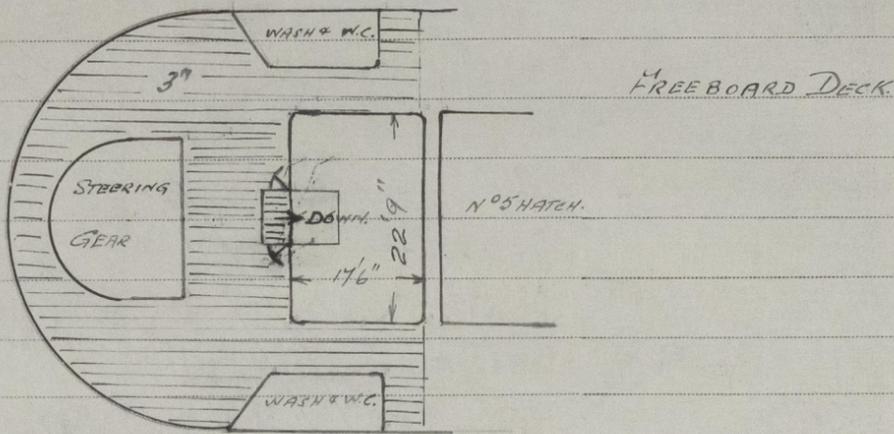

Deck house at after end now altered as shown and companionway made.

Deck house has 0.5" coaming and 0.3125" plating with 3" x 3/8" bar stiffeners at 24" to 36" spacings electric welded.

Two doors of solid hard wood construction operated from both sides provide access to companionway openings are 58" high 24" wide and sills 18" high.

F. K. L. Bink
Surveyor to Lloyd's Register.

Sydney N.S.W.

3rd August 1951

G.H.W.

21 AUG 1951



© 2020

Lloyd's Register
Foundation