
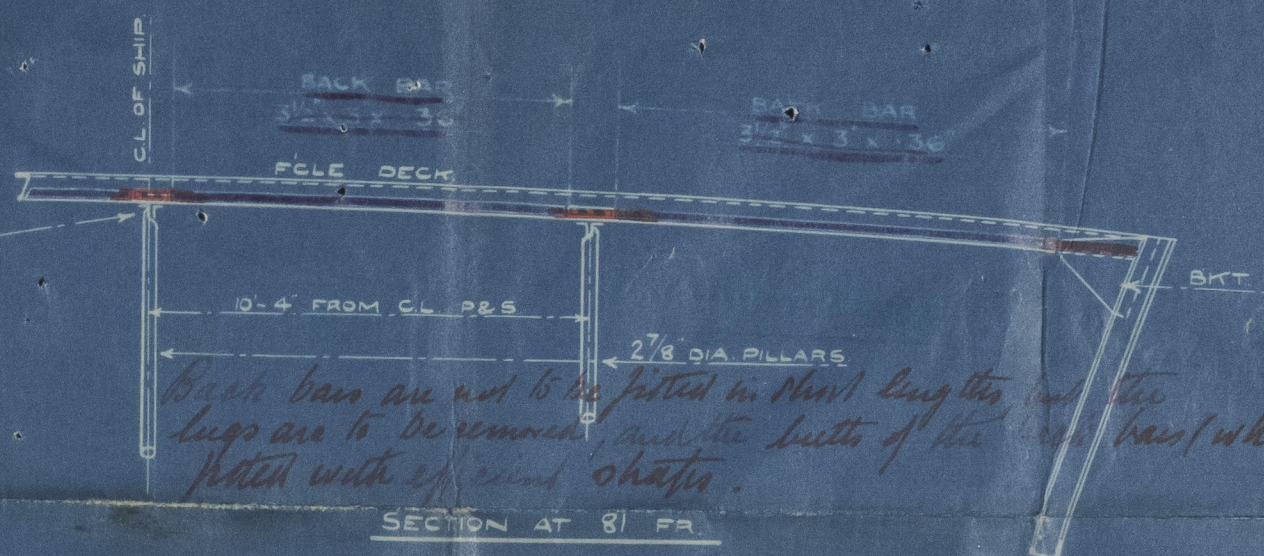


NEWCASTLE-UPON-TYNE  
 NO. 11191 DATE 25-8-21  
 ARMSTRONG YARD


NOS 907 & 13.

SKETCH SHOWING PROPOSED EXTRA  
 STIFFENING TO FORECASTLE BEAMS.

SCALE  $\frac{1}{4}" = 1 \text{ FOOT.}$

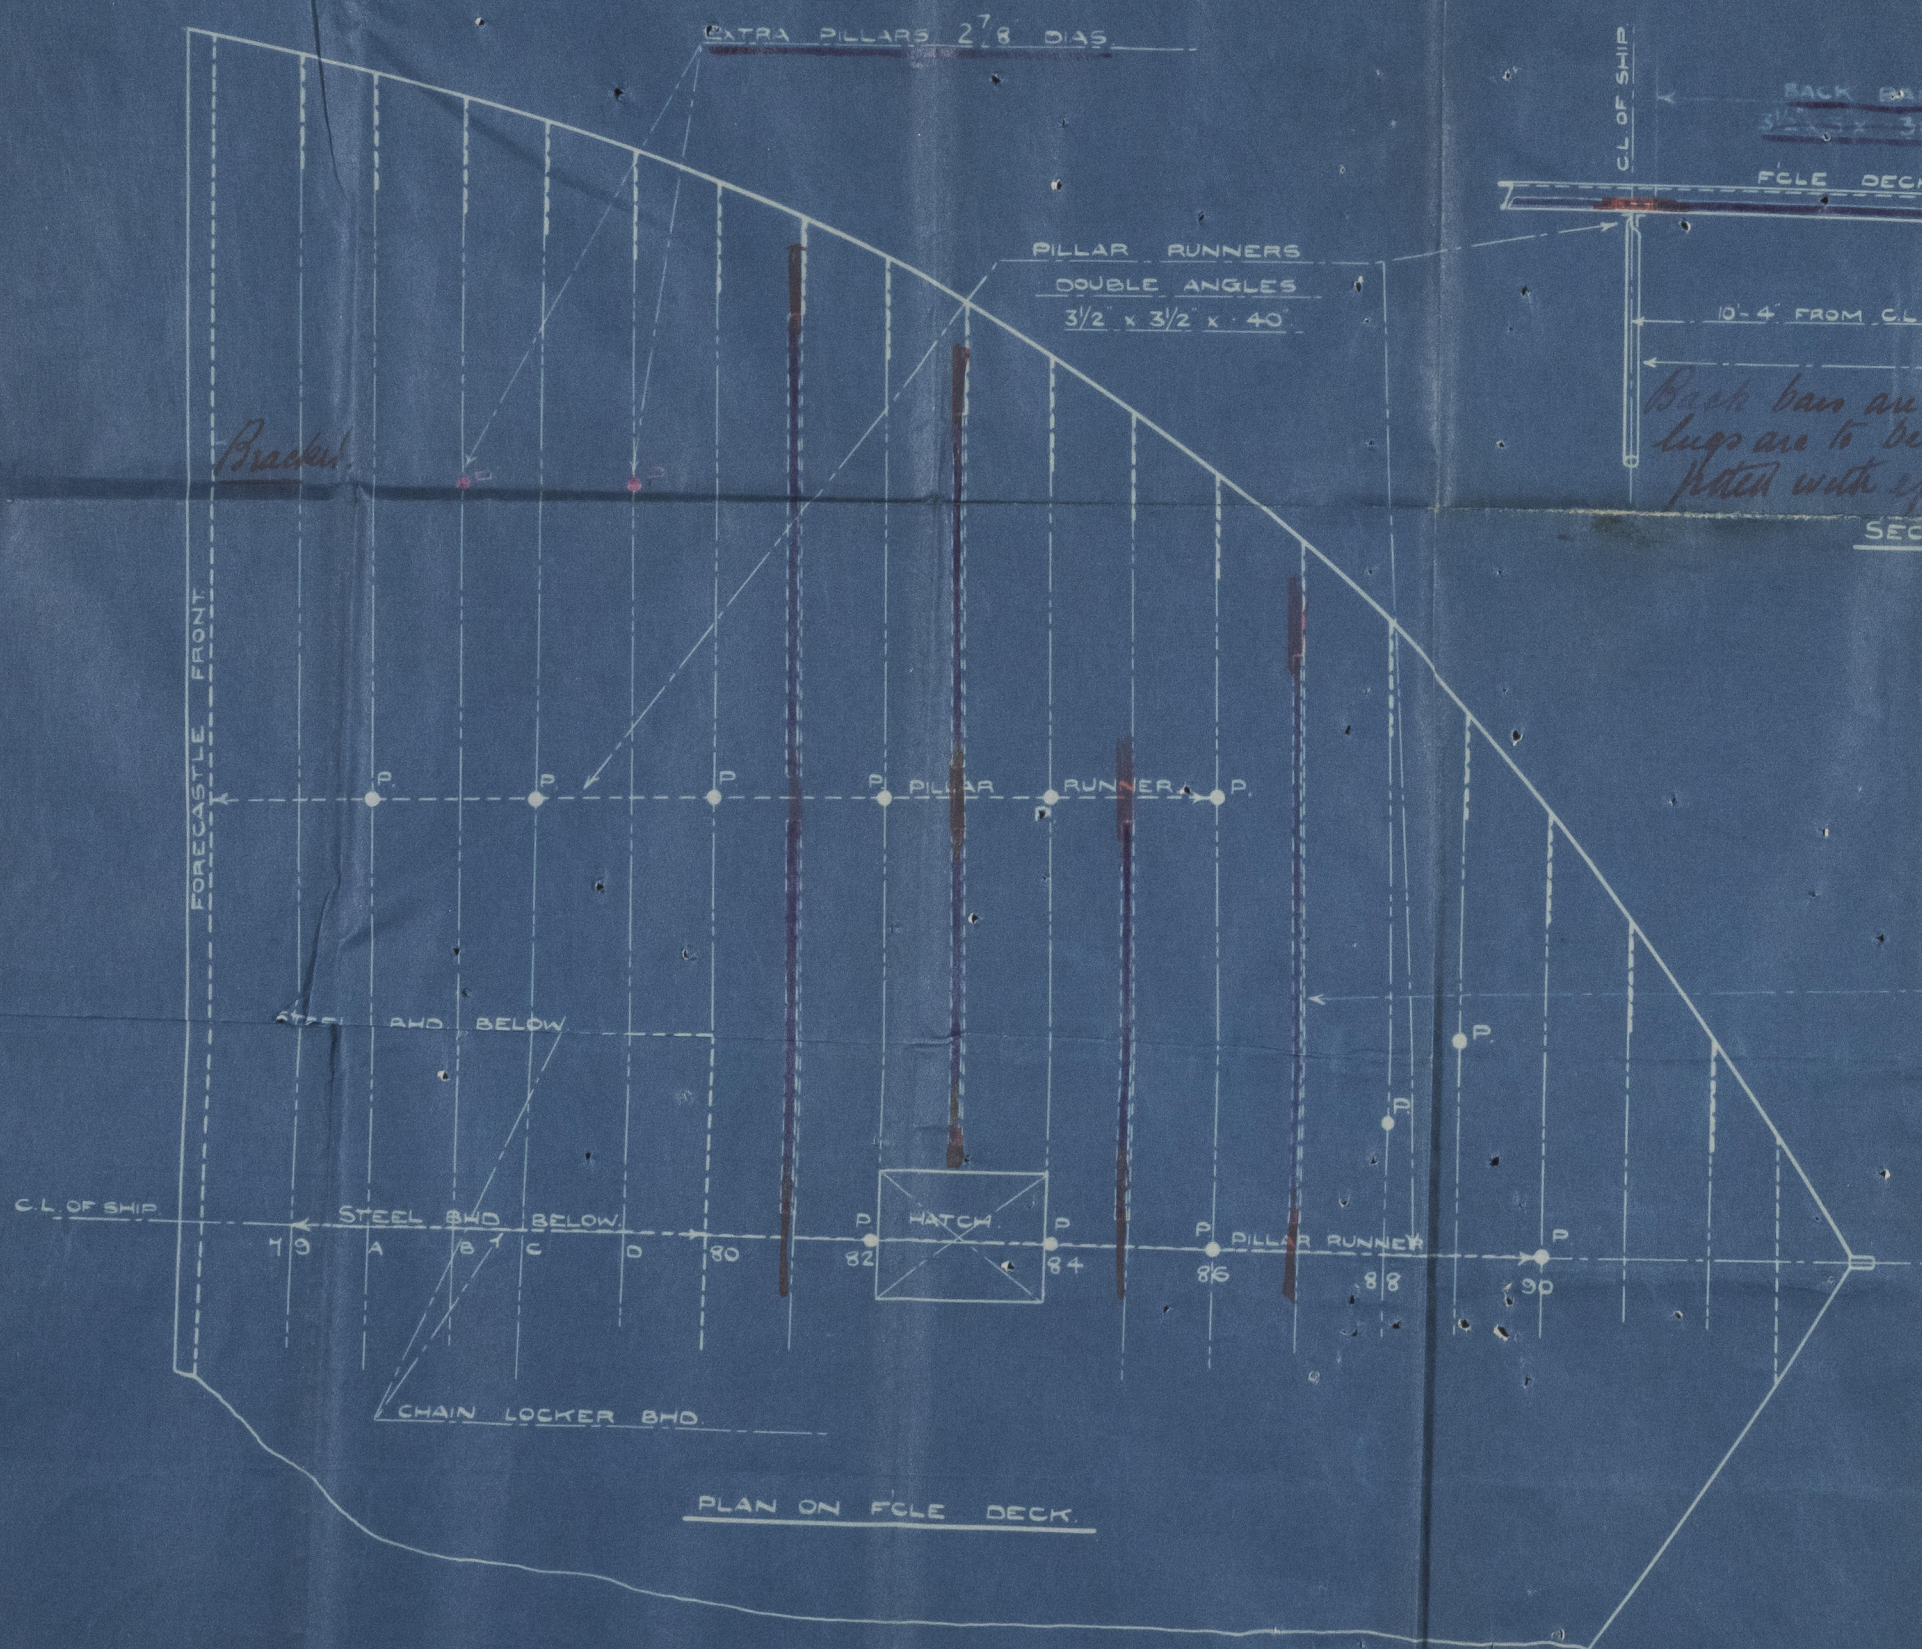

*Back bars are not to be fitted in short lengths, but the lugs are to be removed, and the butts of the back bars (when necessary) fitted with efficient shafts.*

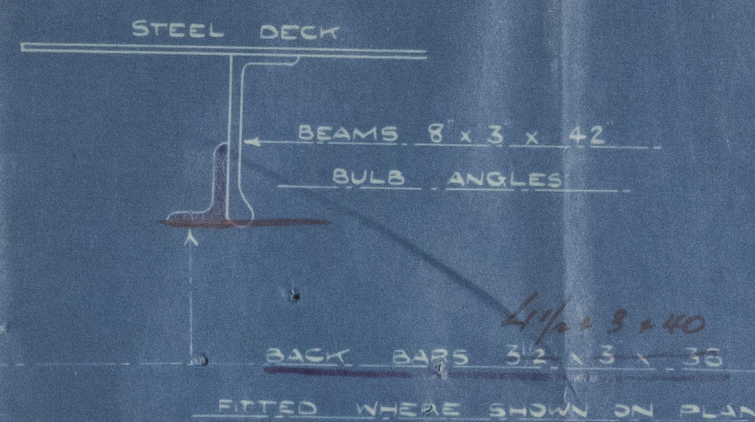

*Back bars to be arranged 15' take runners.*

*bb*  
 29.8.21



© 2020  
 Lloyd's Register  
 Foundation