
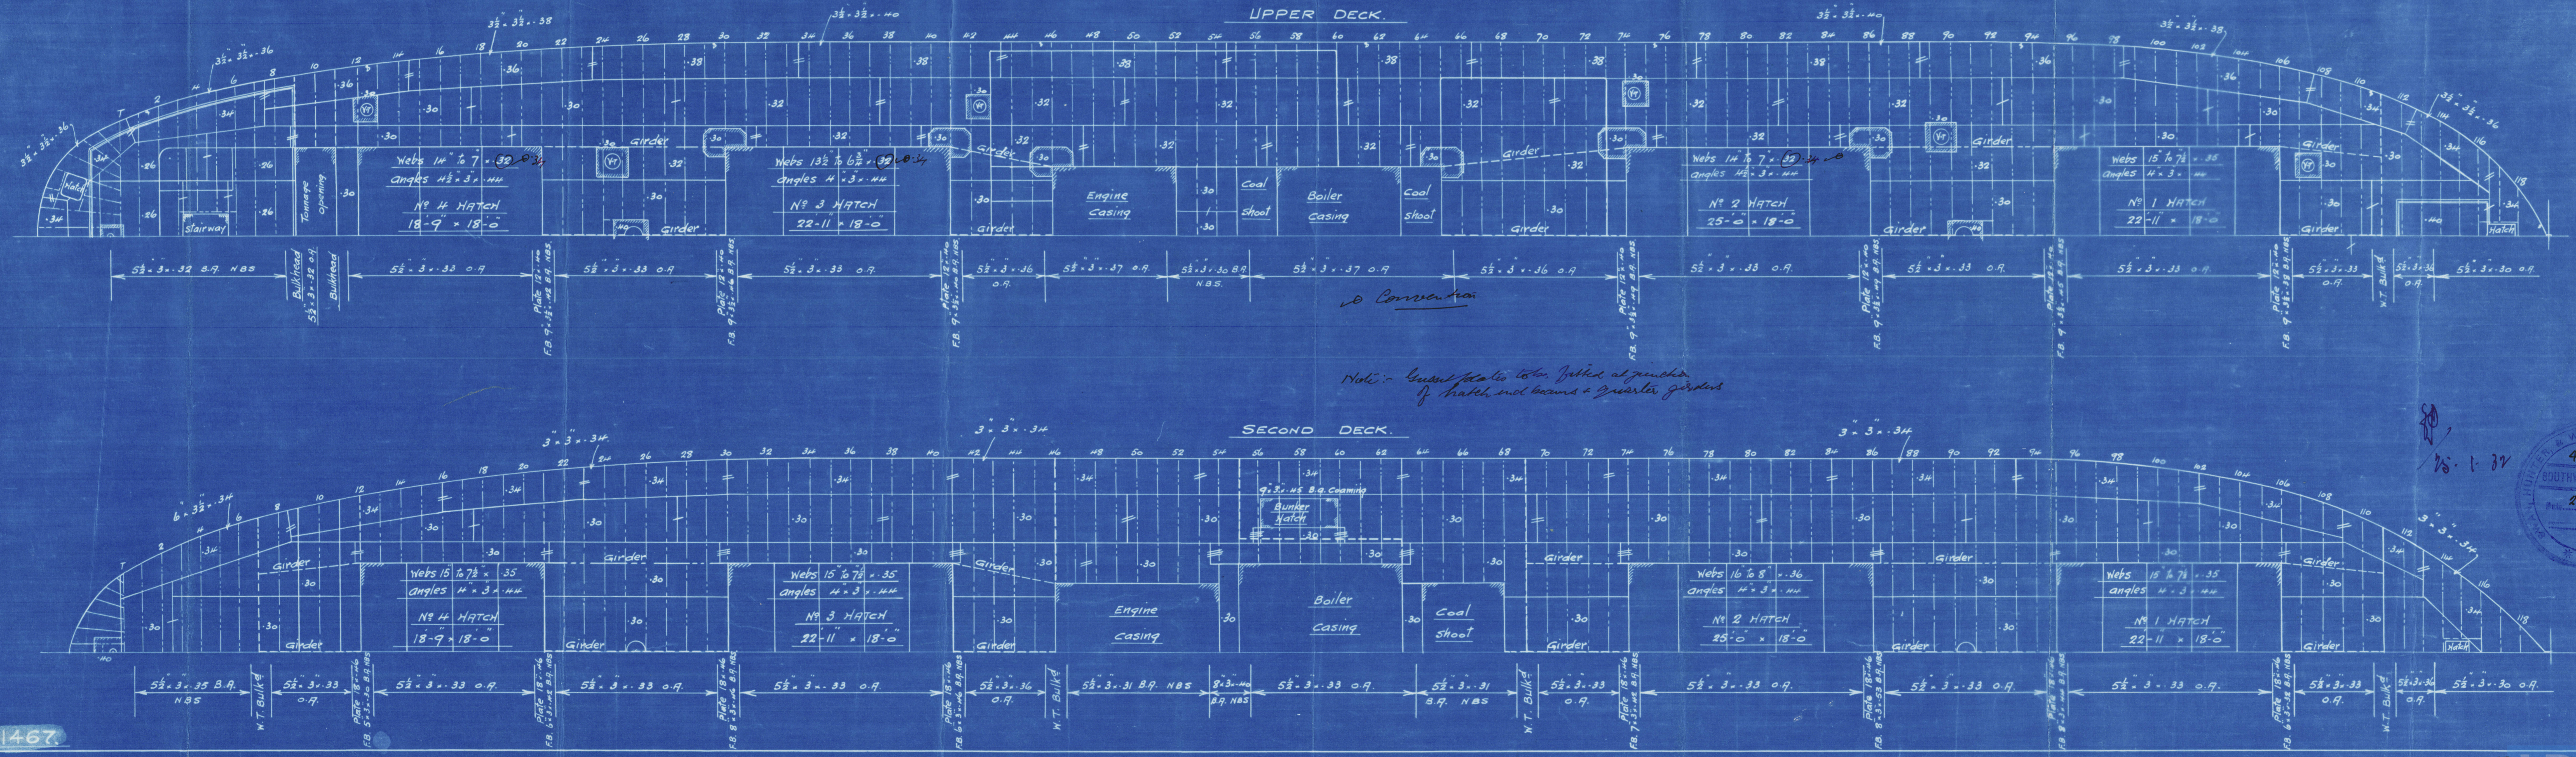


26.1.32

# S.S. N°1477. PROFILE AND DECKS.


SCALE  $\frac{1}{8}$ " = ONE FOOT.

DIMENSIONS:- LENGTH B.P. 248'-0", BREADTH MLD 39'-4", DEPTH MLD 24'-4" (TO UPPER DECK).

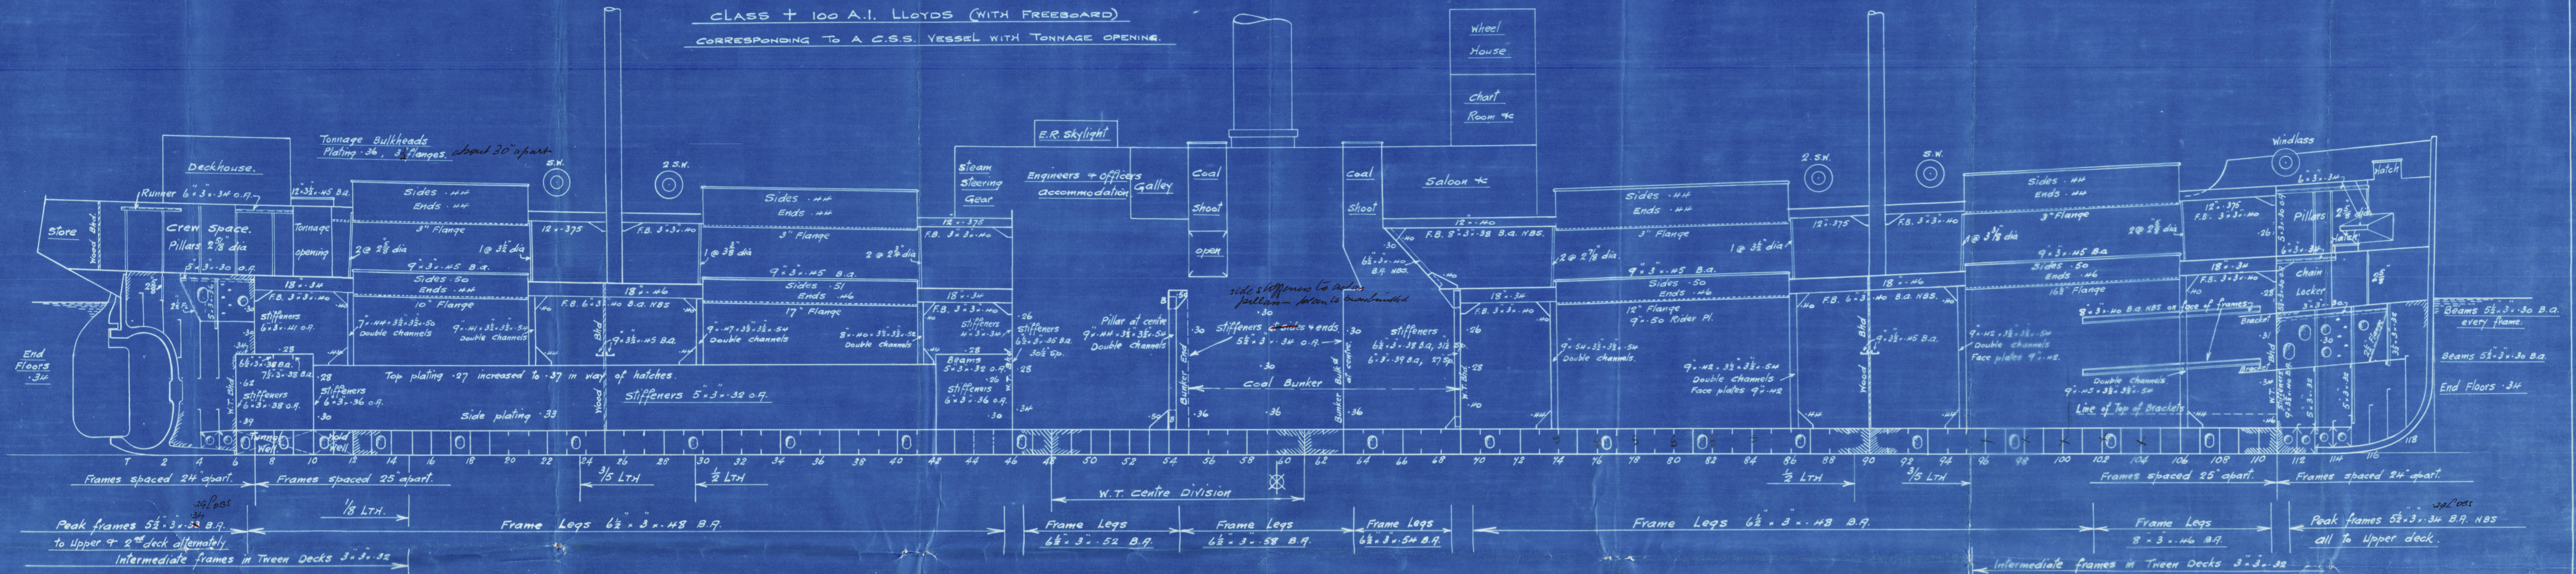

N°1467.

26.1.32

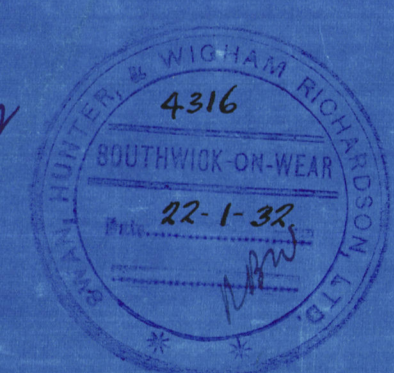

SWAN, HUNTER +  
WIGHAM RICHARDSON  
Nº 1477 LD

PROFILE  
& Decks.  
(2)

ALA

S. S. "Menda"  
NEWCASTLE ON TYNE.  
Report No. 88698.



© 2021

Lloyd's Register  
Foundation

005397-005402-0140