

S.S. MOYRA.

MIDSHIP SECTION, N^o 1477.

SCALE $\frac{1}{2}$ = ONE FOOT.

DIMENSIONS: LENGTH B.P. 248'-0", BREADTH MLD 39'-4", DEPTH MLD 24'-4" TO UPPER DECK, 16'-10" TO SECOND DECK.

CLASS + 100 A.I. LLOYDS, (WITH FREEBOARD)

CORRESPONDING TO A C.S. VESSEL WITH TONNAGE OPENING.

NUMERALS.

L	=	248
B	=	39.33
D	=	24.33
1 st N ^o	L x D	= 6034
2 nd "	L x (B+D)	= 15788
L/D	=	10.2
d	=	14.06



EQUIPMENT N^o

L x (B+D)	=	15788
Deckhouses	62.5' x 7.66' x 5'	= 239
		16027

EQUIPMENT.

2 Bower Anchors	33 cwt's each,	Stockless.
1 " "	28 " "	" "
1 Stream "	8 1/2 " "	Ex Stock.
240 Fathoms	1 1/2 " Stud chain cable	
75 "	4 " Steel wire,	Stream.
90 "	3 1/2 " " "	Towline.
2 @ 90 "	2 1/4 " " "	Lawser.
2 @ 90 "	1 3/4 " " "	Warps.

26.1.32

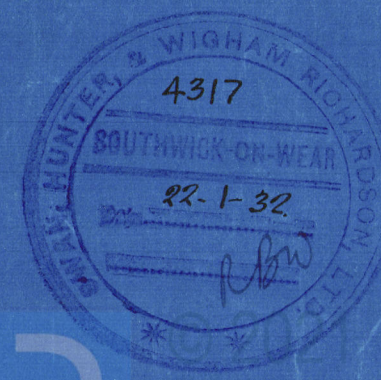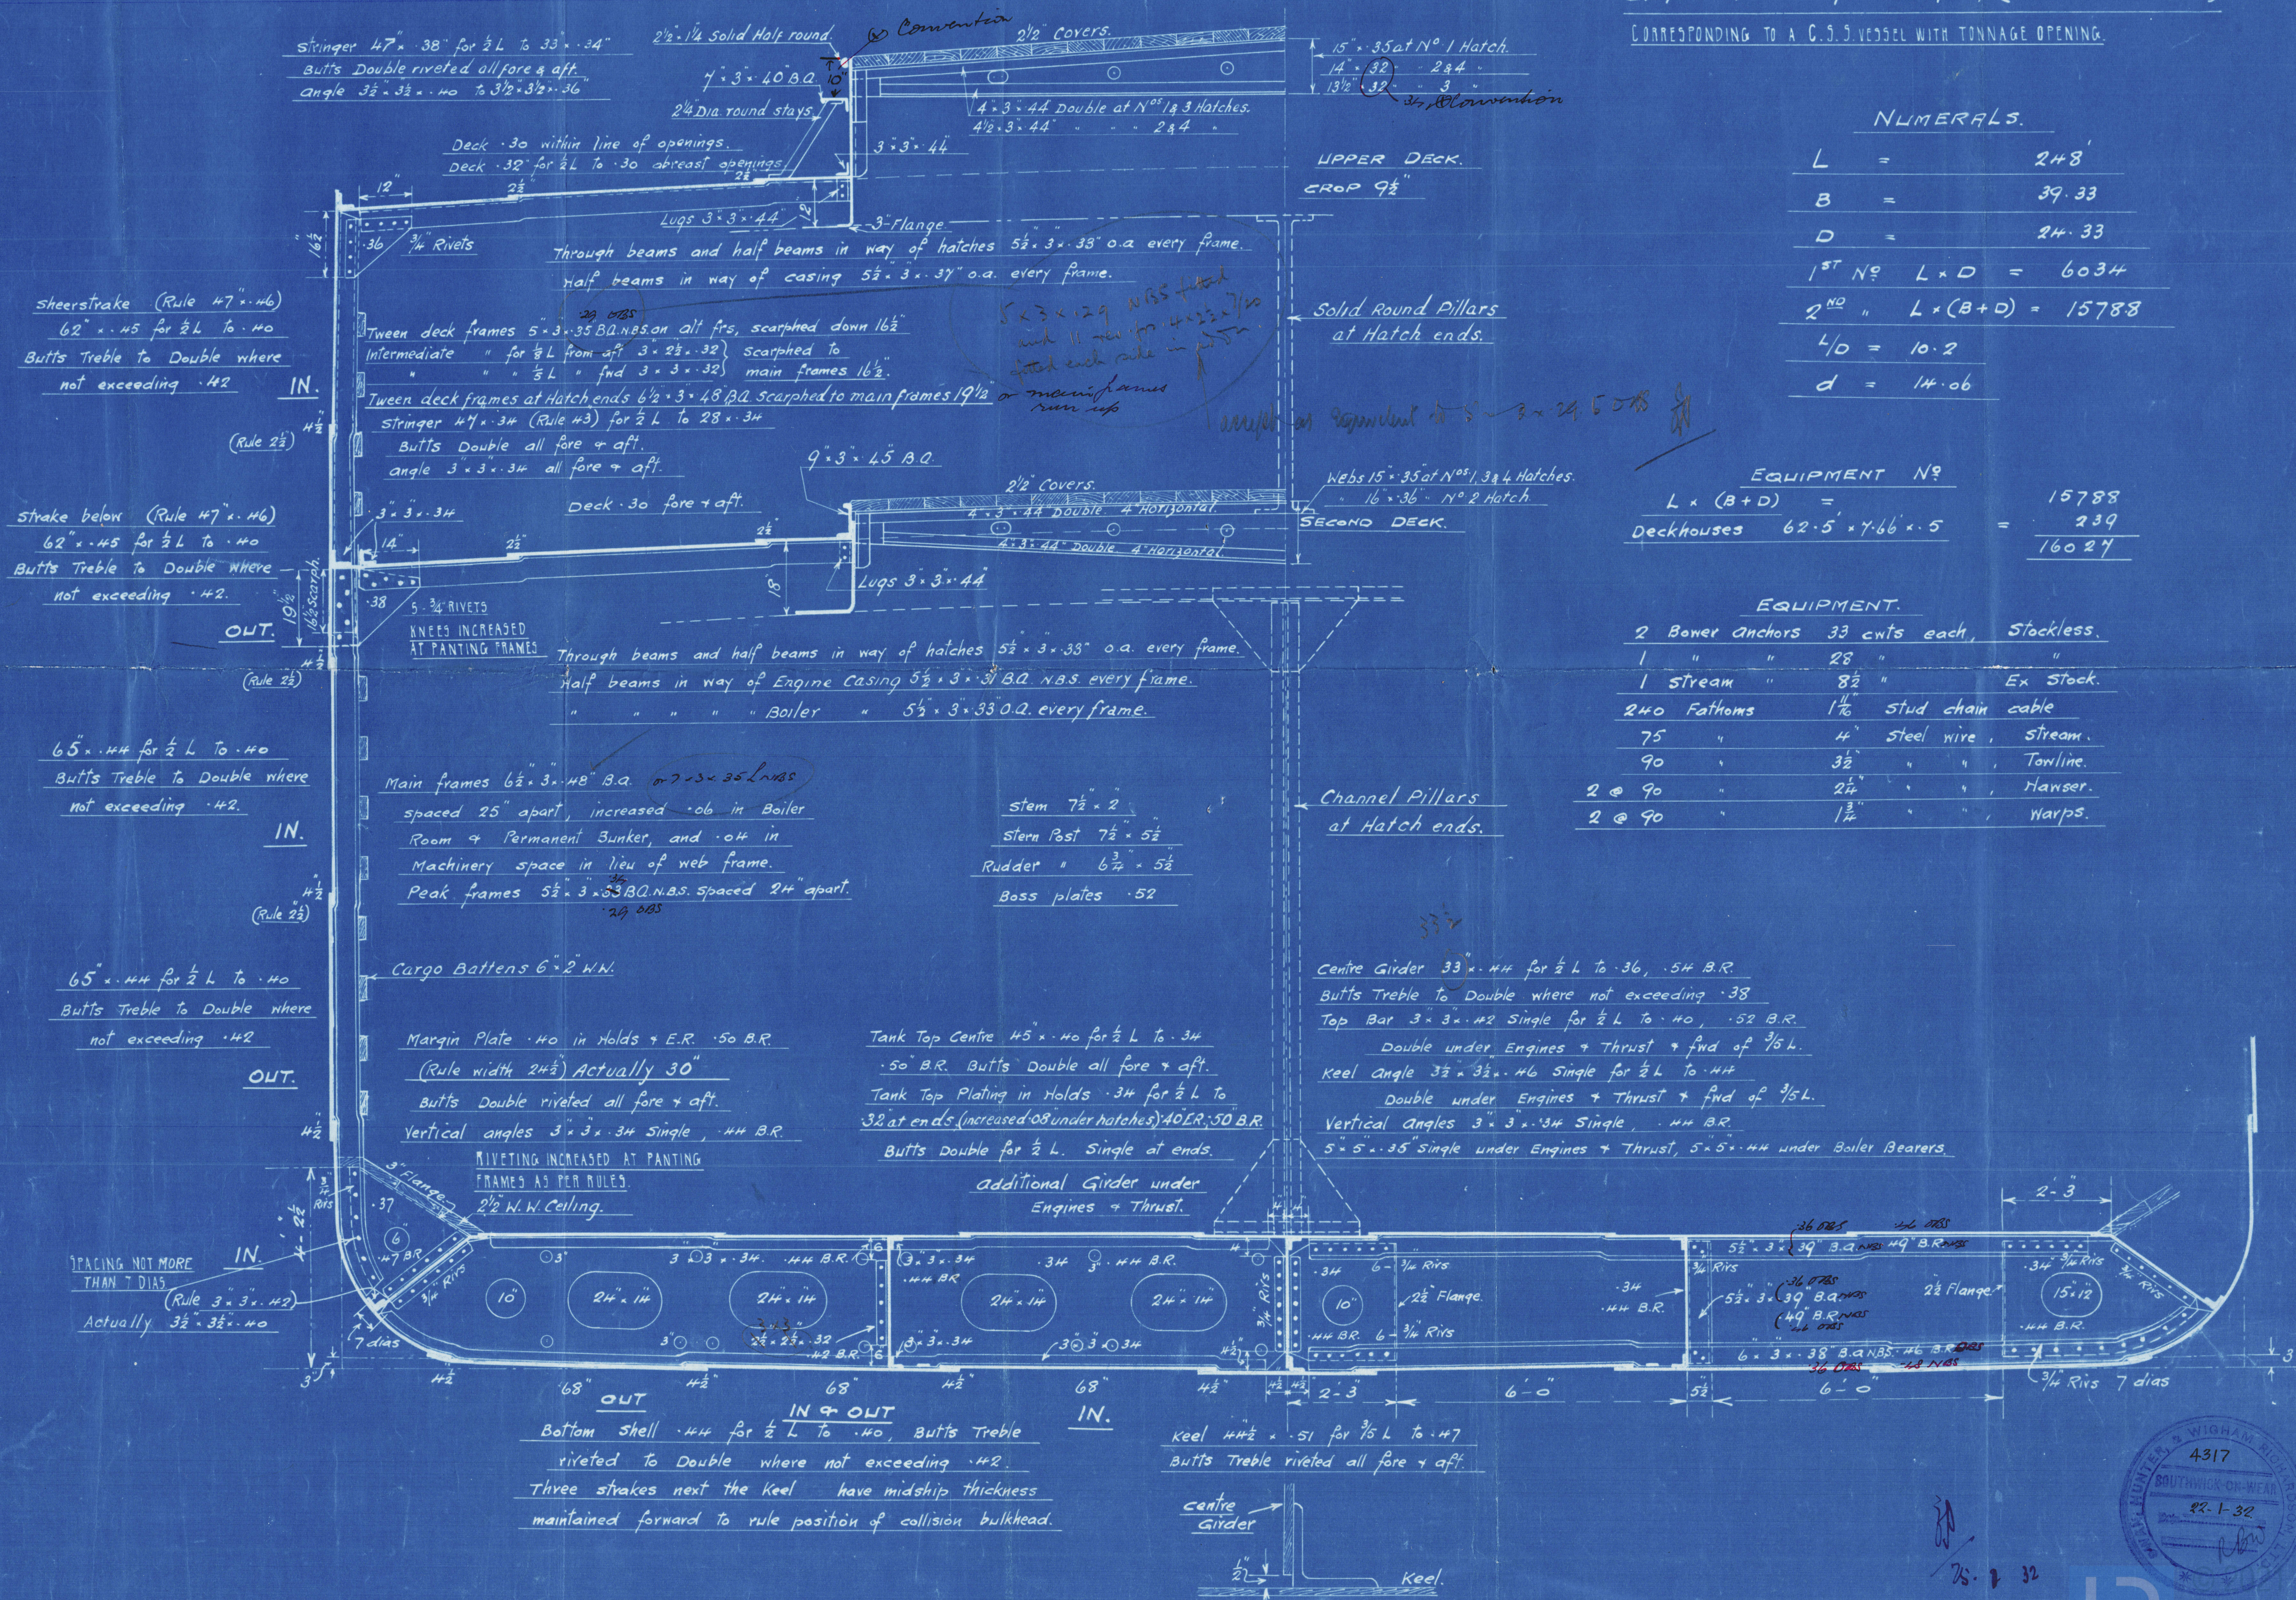

SWAN, HUNTER +

WIGHAM, RICHARDSON
LD

NO 1477

MIDSHIP SECTION

(1)

"Liverpool Loyalist"
EX

S.S. "Zenda"

NEWCASTLE ON TYNE.

Report No. 88698

ALA



© 2021

Lloyd's Register
Foundation

005397-005402-0141