


SAINT - BERTRAND

2^{me} Pont PRINCIPAL

Plan de sondage. *Thickness measured by sounding.*

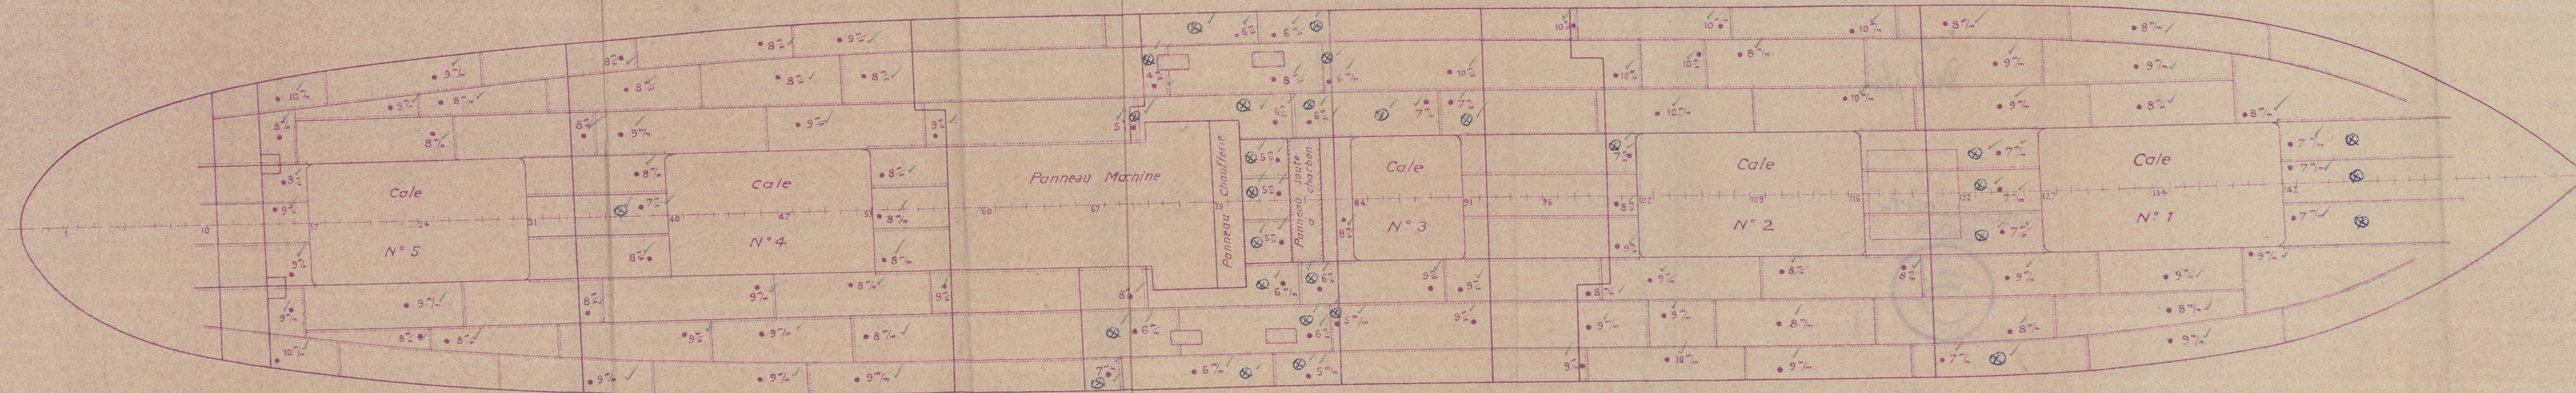

⊗ TOLE A CHANGER



© 2020

Lloyd's Register
Foundation

005403-005411-0067


"SAINT BERTRAND



2ND.

Deck plan

RECORDS DEPT.
LONDON

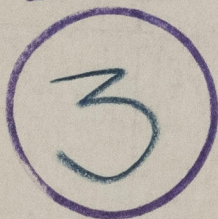

© 2020

Lloyd's Register
Foundation

005403-005411-0067