


LLOYD'S REGISTER OF SHIPPING

UNITED WITH THE BRITISH CORPORATION REGISTER

Ship's Name **S.S. "MODESTA"**Official No. **1290**

Memorandum of alterations reported since ship was surveyed for assignment of Load Lines in **Kiel.**

Tonnage openings 1810x950 without coaming fitted with 4" storm boards in welded channels to full height of openings have been installed in bridge house aft bulkhead starboard side and in adjacent store room bulkhead (ss).

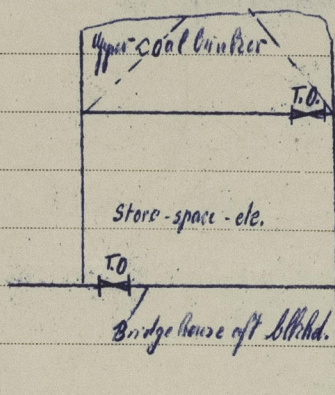

Kiel, 19th January, 1953

Georg Koller

It is submitted the surveyor be requested to confirm that a copy has been placed on board the ship.

lie

12 FEB 1953