


Lloyd's Register of Shipping.

Ship's Name *S/S. Modesta*

Official No. 1290

Memorandum of alterations reported since ship was surveyed for assignment of Load Lines
in *July 1948*

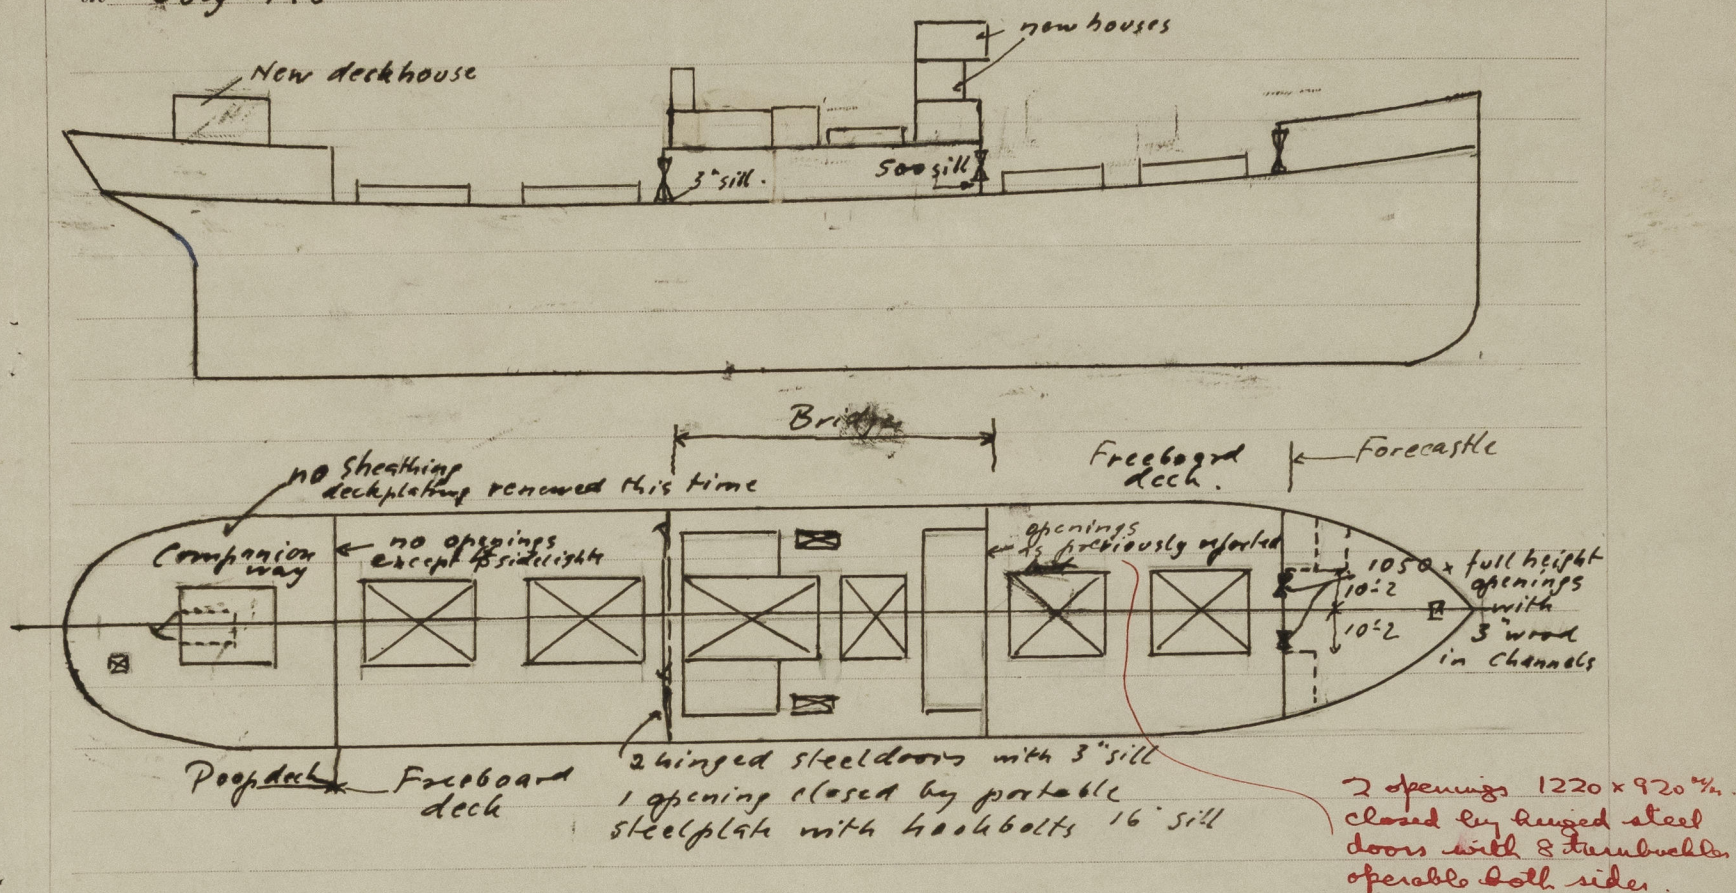

New Companion way on poopdeck: coaming 10" γ_m
plating 6" γ_m , stiffeners $\angle 2\frac{1}{2} \times 2\frac{1}{2} \times \frac{5}{16}$ spaced 200-250
Solid wooden doors with 300" γ_m fill. 18" sill.

Forecastle 2 openings 1050 x full height and new
steel bulkhead between openings. openings closed with
3" wood.

Poop: Bulkhead now closed. only 4 deadlights
fitted 12" diam, with hinged deadlights. Access to
Crew through companionway on poopdeck.

The Owners request timber foreboard to be
assigned, plan of details for timber foreboard attached.
Center girder in double bottom tanks N: 2, 3, 4 & 5
($\frac{1}{2}L$) made watertight.

21th. June.
Jan. 23rd October 1952