
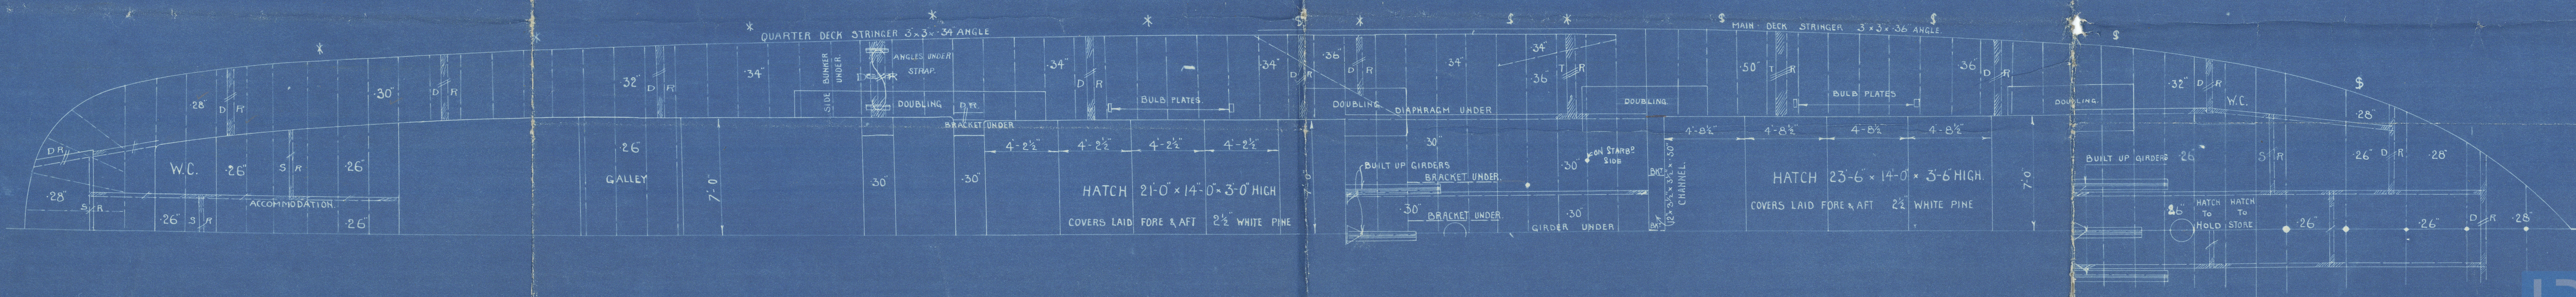
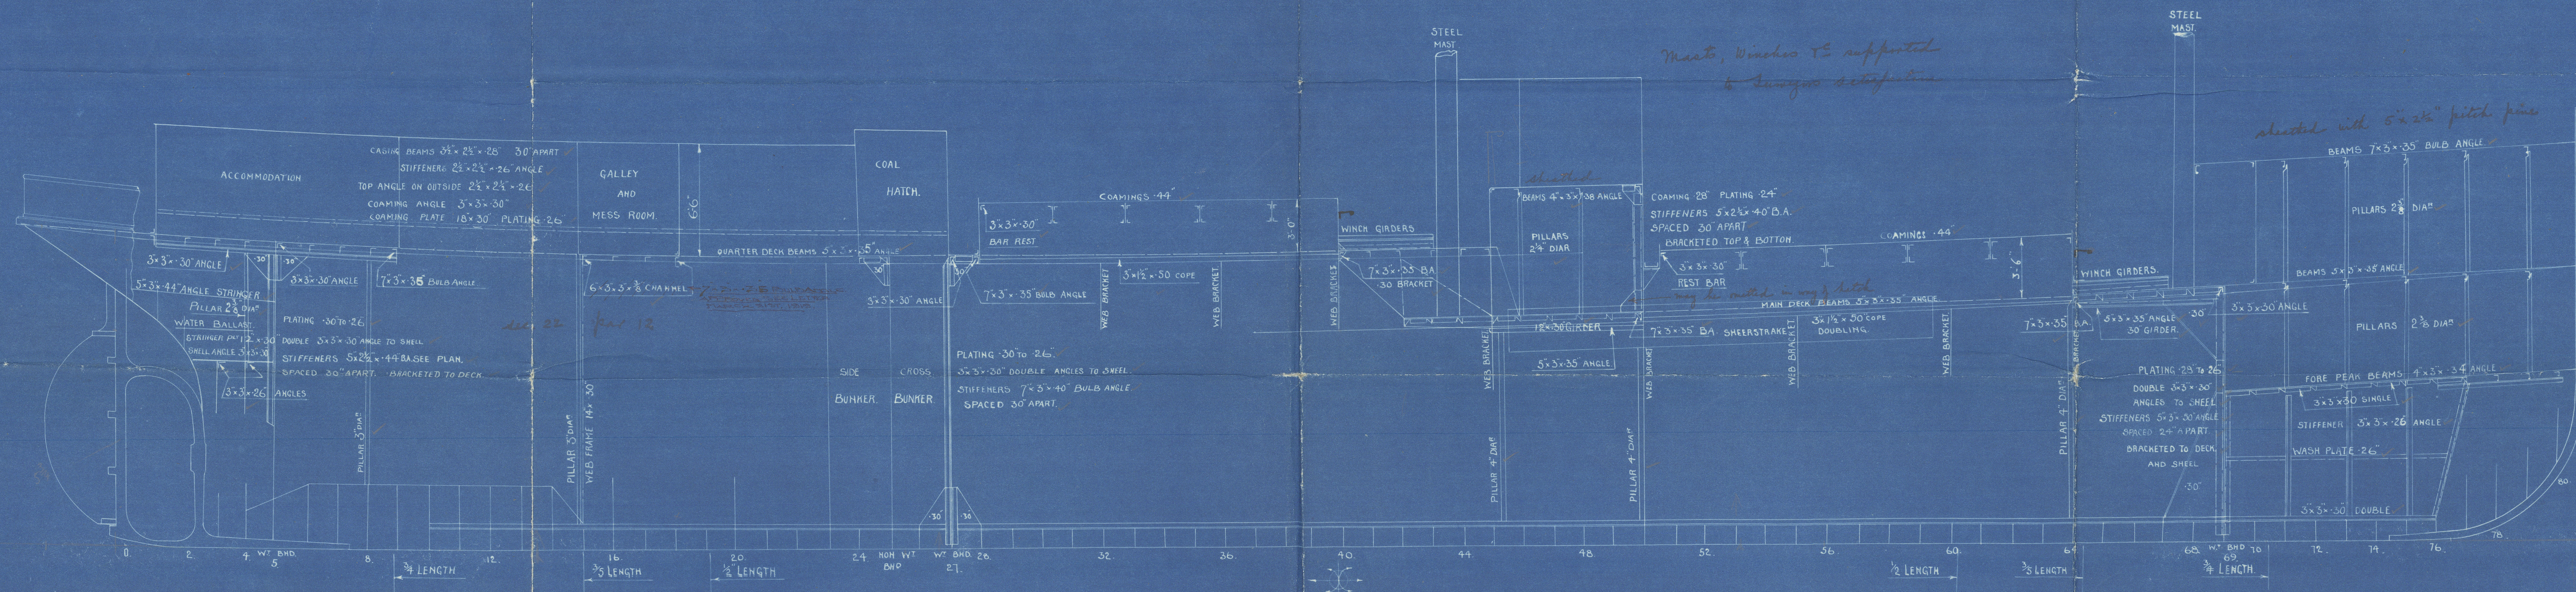


28-2-19

N^o 104. 108

PROFILE.

SCALE 1/4" = 1 FOOT.

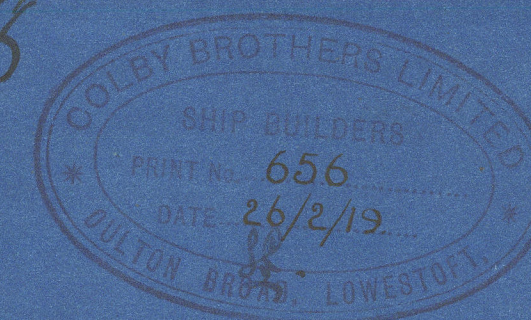

© 2020
Lloyd's Register
Foundation

005436-005442-0046

LLOYDS APPROVED COPY.—

PROFILE. 104.

COLBY BROS

S.S. 104+108

PROFILE + DKS

John Evelyn *

104. S.S. "Jort Lavenack"

Lon Rpt

82801

108. S.S. "Pytoner"


RETAIN

RECORDS DEPT.
LONDON.

83179 (2hd)

005436-005442-0046

0046

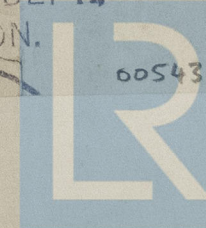

Lloyd's Register
Foundation