

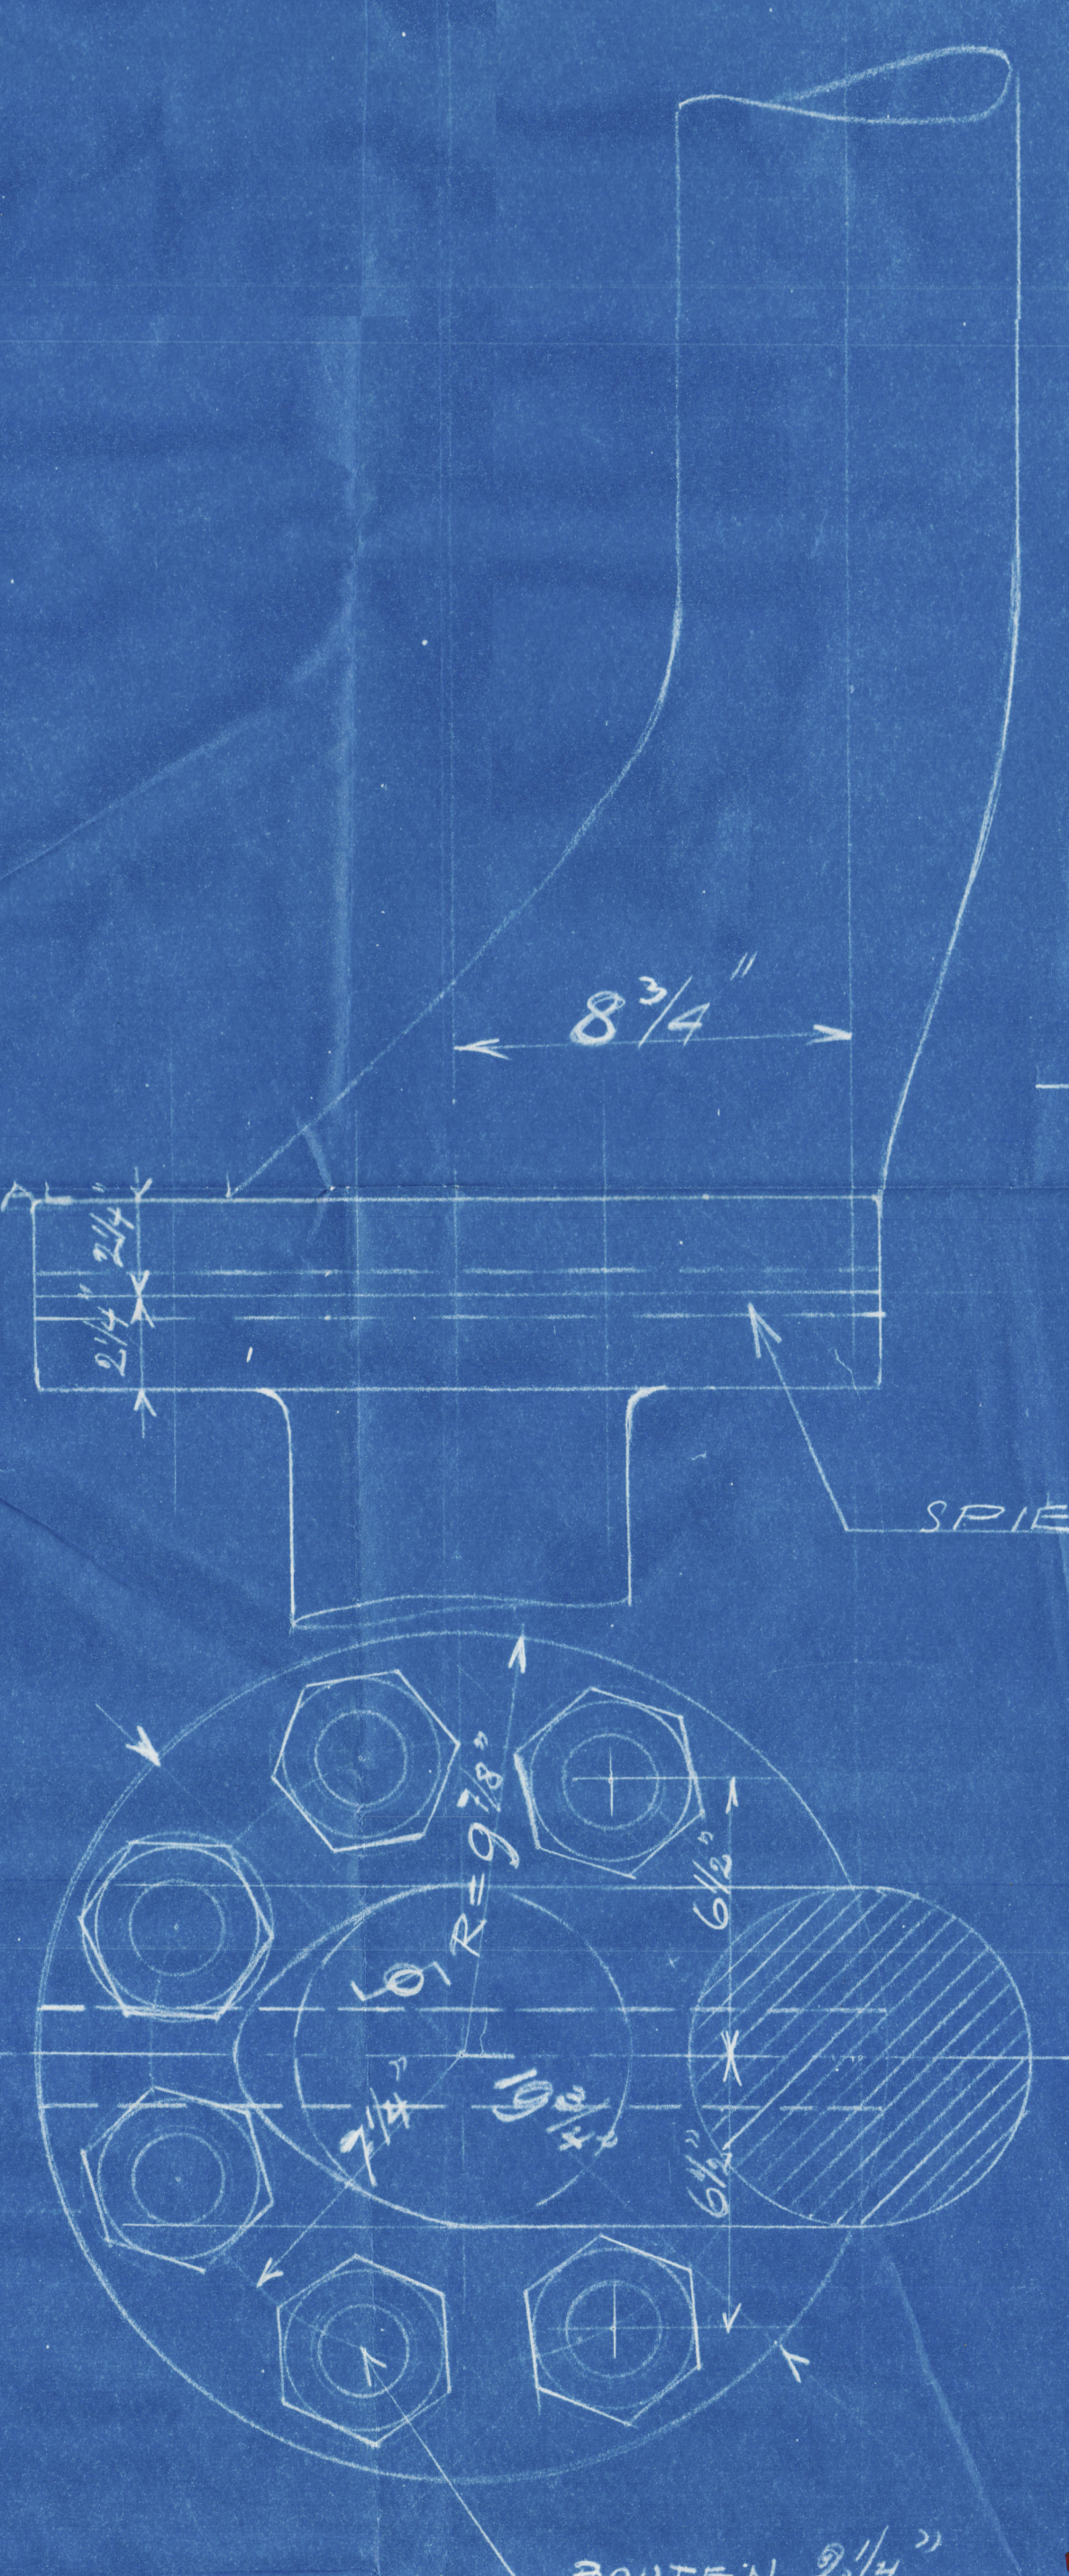
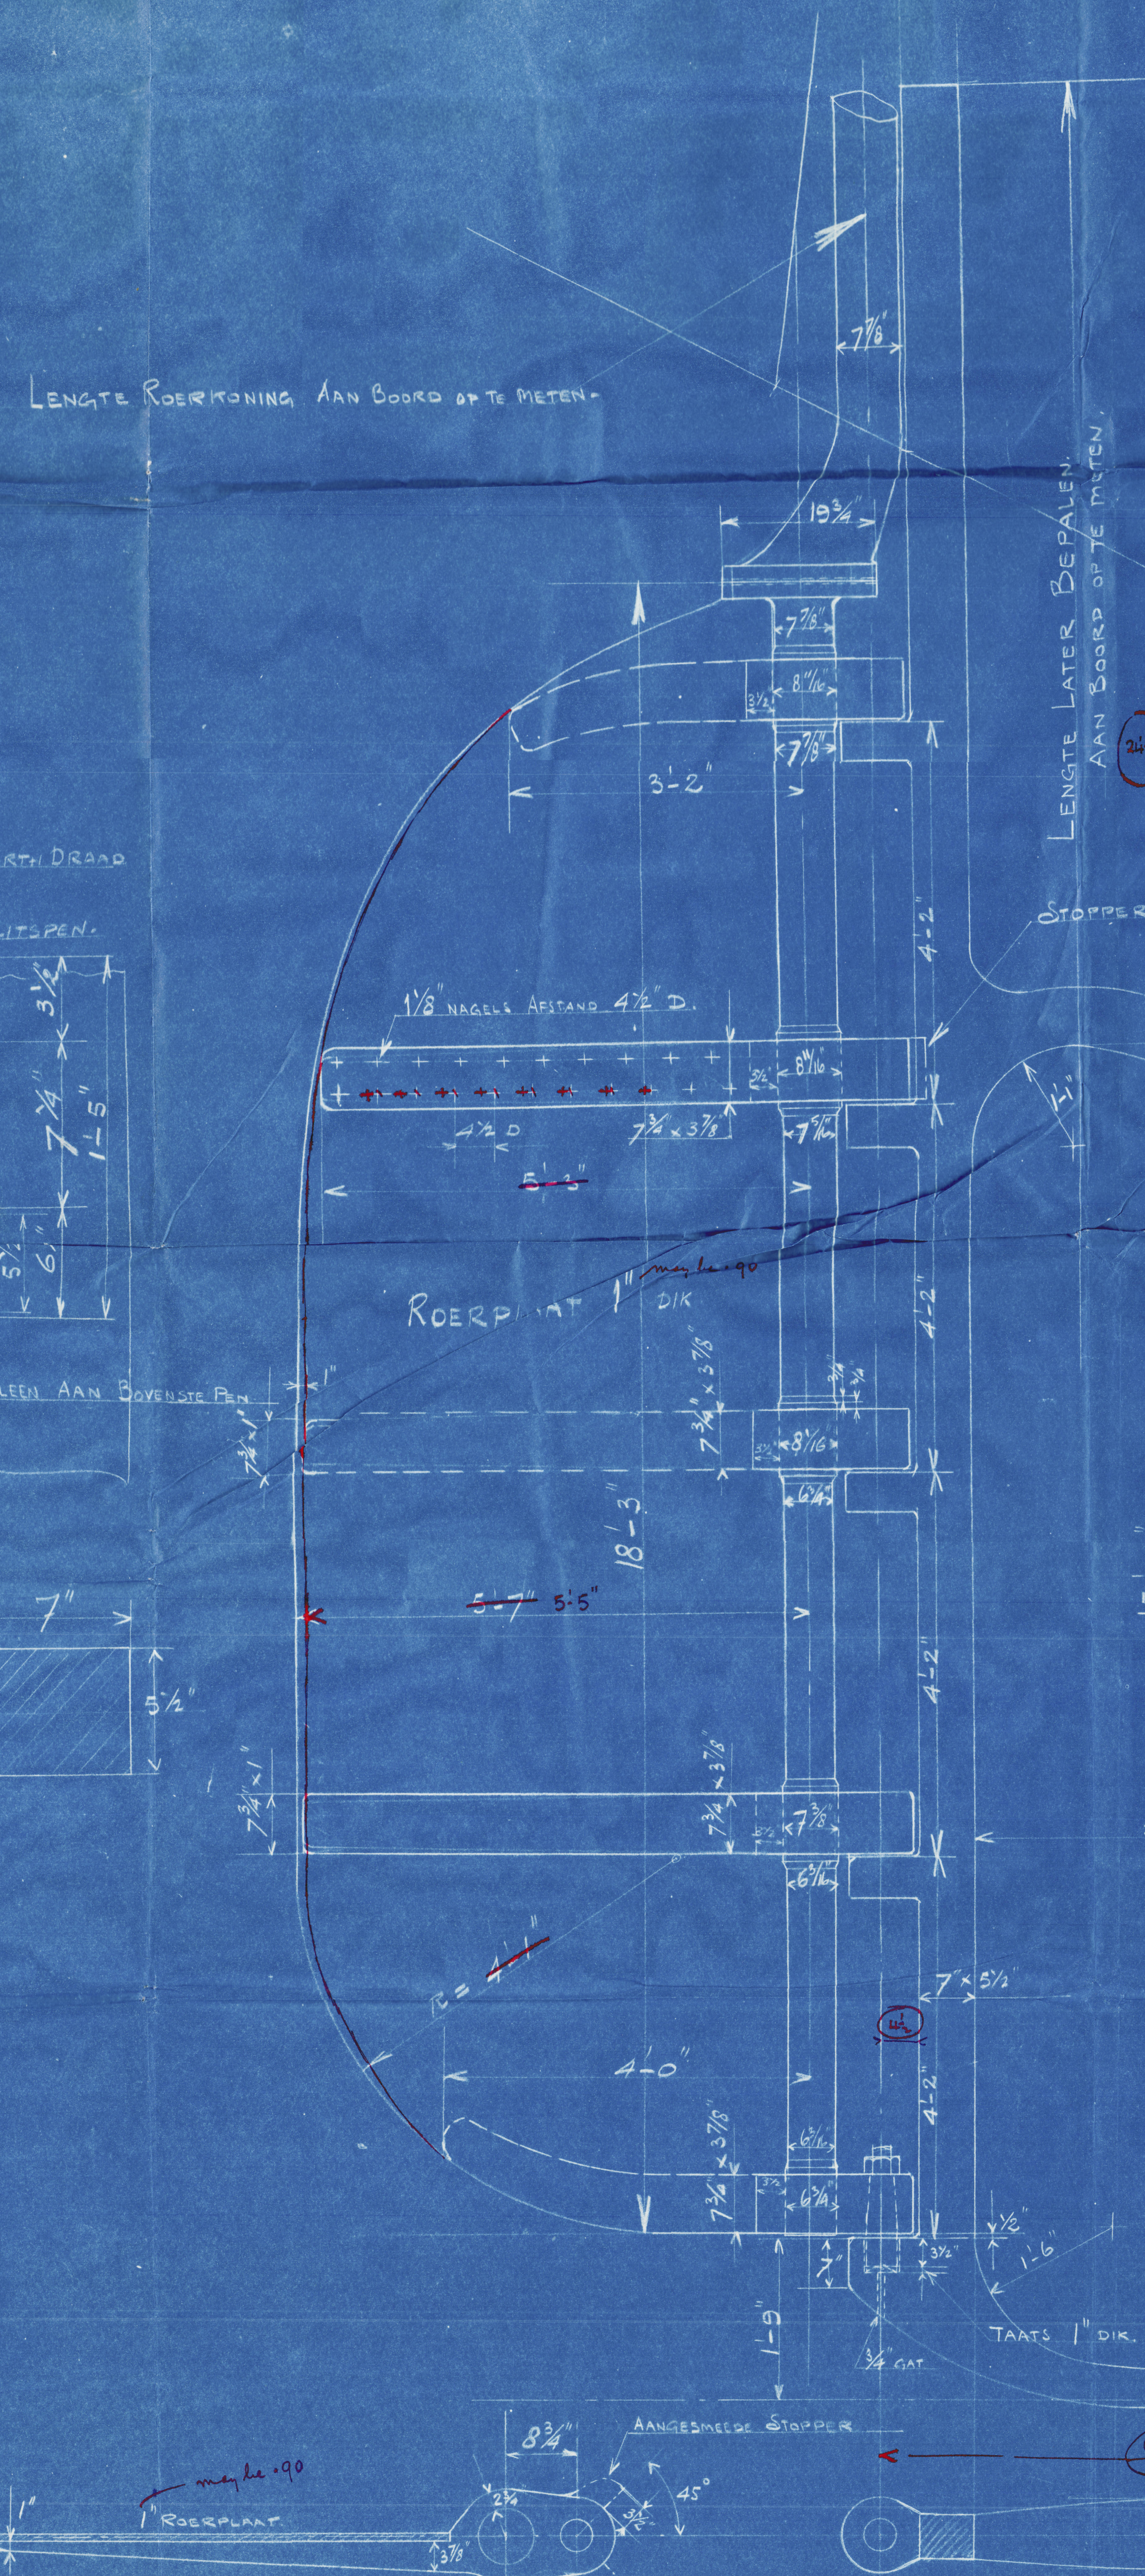


SS. VALKA SCHAAL 1" = 1'-0"

SCHAAL 1" = 4"

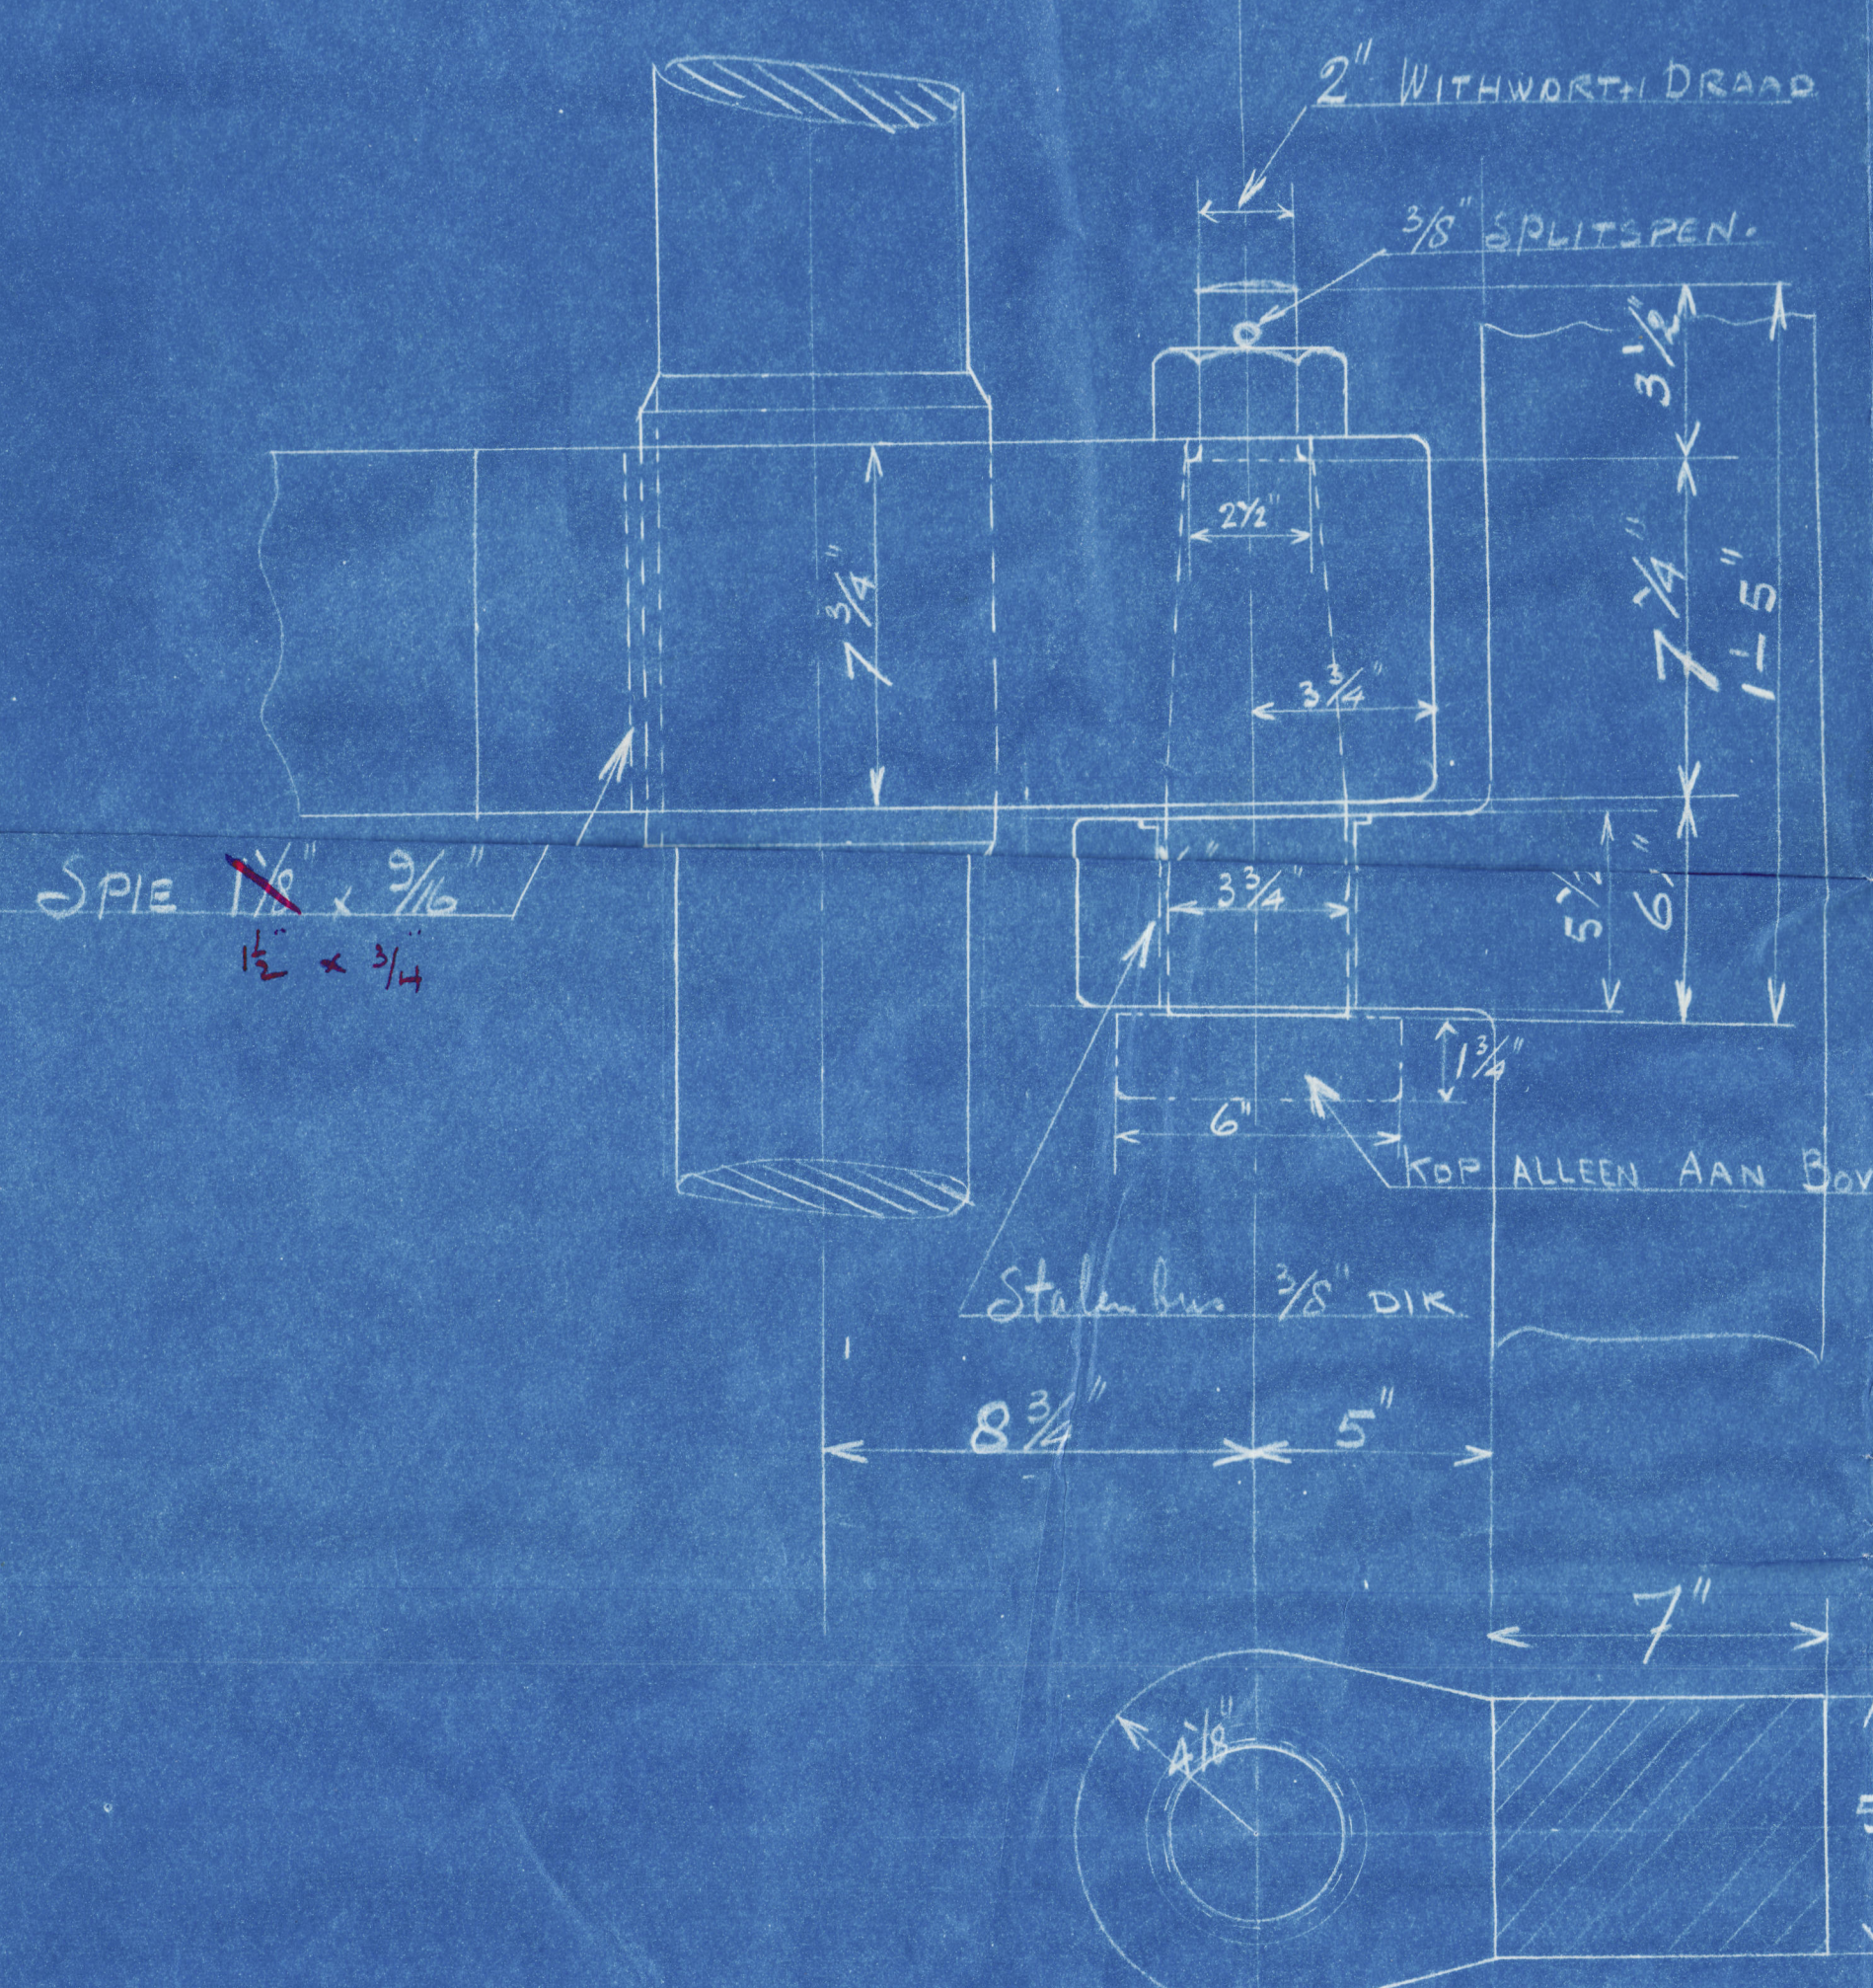

Notes so refer to original structure.

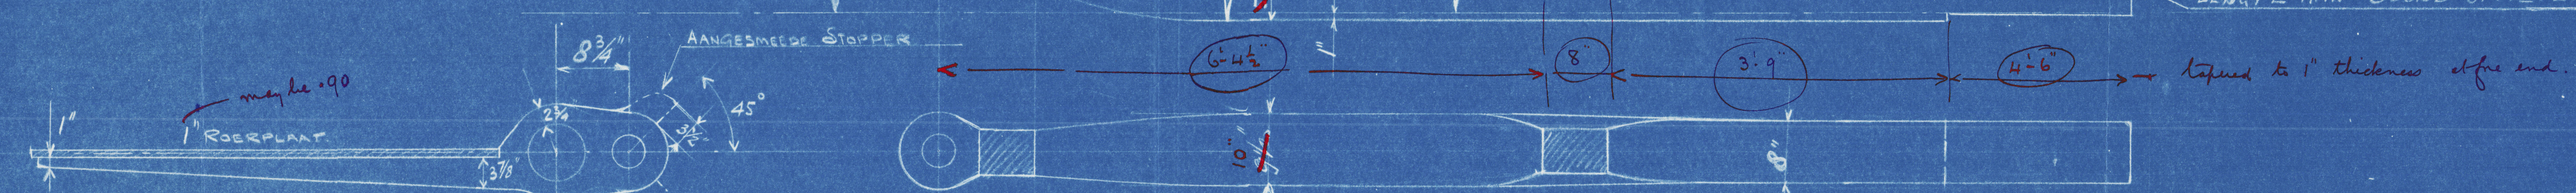

1.2.29

202-227296-027524

005470-005479-0162

Valka
en Kionas
New Sten fan
Kudder
Konden



© 2020

Lloyd's Register
Foundation