


Lloyd's Register of Shipping.
SURVEYS FOR FREEBOARD.
(CONDITIONS OF ASSIGNMENT.)

Index No. 25261
(For London Office only).

JAN - 3 1941

Ship's Name "ELIZABETE"
Official Number 125 167820
Nationality and Port of Registry BRITISH LONDON CARDIFF
Port of Survey CARDIFF
Surveyor's Signature A. Hunter
Date of Survey 30th + 31st DEC. 1940

Disposition and dimensions of superstructures, trunks, deckhouses and machinery casings to be inserted in the diagrams and tabular statement :-

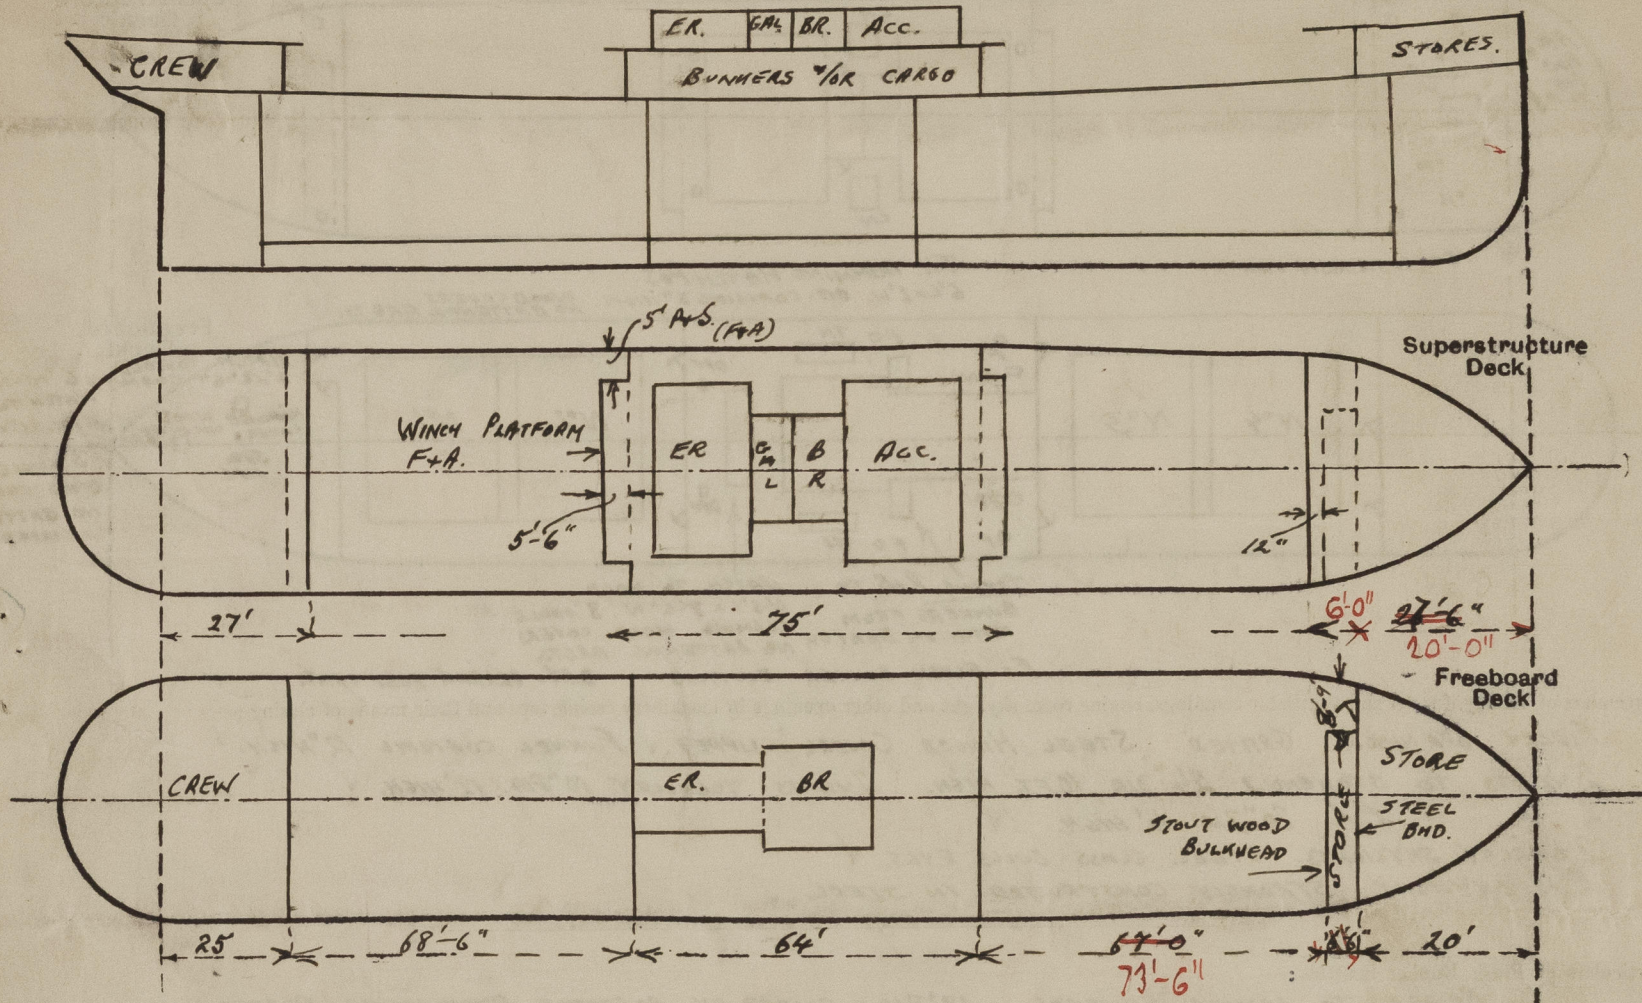


Particulars of Superstructures, Trunks, Casings, Deckhouses.								
	Coaming	Plating	Stiffeners	Spacing	End Attachments of Stiffeners	Size of Openings	Height of Sills	Height of Casings
Poop Bulkhead	VERT. PLTG.	3/8 ✓	L ² 5 1/2 x 3 x 3/8 ✓	29" ✓	FREE	14' 6" x 2' 0" / 14' 5" x 20"	18" ✓ / 6" ✓	7' 0" ✓
Raised Quarter Deck Bulkhead ...								
Bridge, After Bulkhead	VERT. PLTG.	3/8	L ² 4 x 3 x 5/16 ✓	30" ✓	FREE	24' 5" 0" x 3' 0"	18" ✓	7' 0" ✓
Bridge, Forward Bulkhead	" "	" ✓	[7 x 3 x 1/4 ✓	30" ✓	BATS AT TOP	20' 4' 9" x 3' 0"	18" ✓	7' 0" ✓
Forecastle Bulkhead	" "	"	L ² 5 x 3 x 3/8 ✓	27" ✓	FREE ✓	14' 4' 0" x 3' 0"	18" ✓	7' 0" ✓
Trunk, Aft								
Trunk, Forward								
Exposed Machinery Casings on Freeboard or Raised Quarter Decks ...								
Exposed Machinery Casings on Superstructure Decks	VERT. PLTG	3/8	L ² 3 x 3 x 5/16 ✓	28" ✓	BATS AT TOP, AFT. 4' 9" x 2' 0" / 14' 5" 4' 9" x 2' 0"		18" ✓	7' 0" ✓
Machinery Casings within Superstructures not fitted with Class I Closing Appliances								
Deckhouses on Flush Deck Ships ...								

Particulars of Closing Appliances (state if capable of being manipulated from both sides).					
Poop Bulkhead	S. STEEL HINGED DOOR. CLIPS. BOTH OUTSIDE ONLY ✓	C. " " " " BOTH SIDES ✓			
Raised Quarter Deck Bulkhead ...					
Bridge, After Bulkhead	STEEL HINGED DOORS. CLIPS. OUTSIDE ONLY ✓				
Bridge, Forward Bulkhead	" " " " " " ✓				
Forecastle Bulkhead	" " DOOR " BOTH SIDES. ✓				
Exposed Machinery Casings on Freeboard or Raised Quarter Decks ...					
Exposed Machinery Casings on Superstructure Decks	STEEL HINGED DOORS. HANDLES & LOCKS BOTH SIDES ✓				
Machinery Casings within Superstructures not fitted with Class I Closing Appliances					
Deckhouses on Flush Deck Ships ...					

PARTICULARS OF PROTECTION TO OPENINGS, ETC.

The following diagrams should be used to indicate the positions of cargo and coaling hatchways, gangway, cargo and coaling ports, ventilators, companionways, etc. which would affect the seaworthiness of the ship:—

BUNKER HATCH ON BOAT DECK 2' LONG 8' WIDE 2 1/2' HIGH.
CASUALTY HATCH

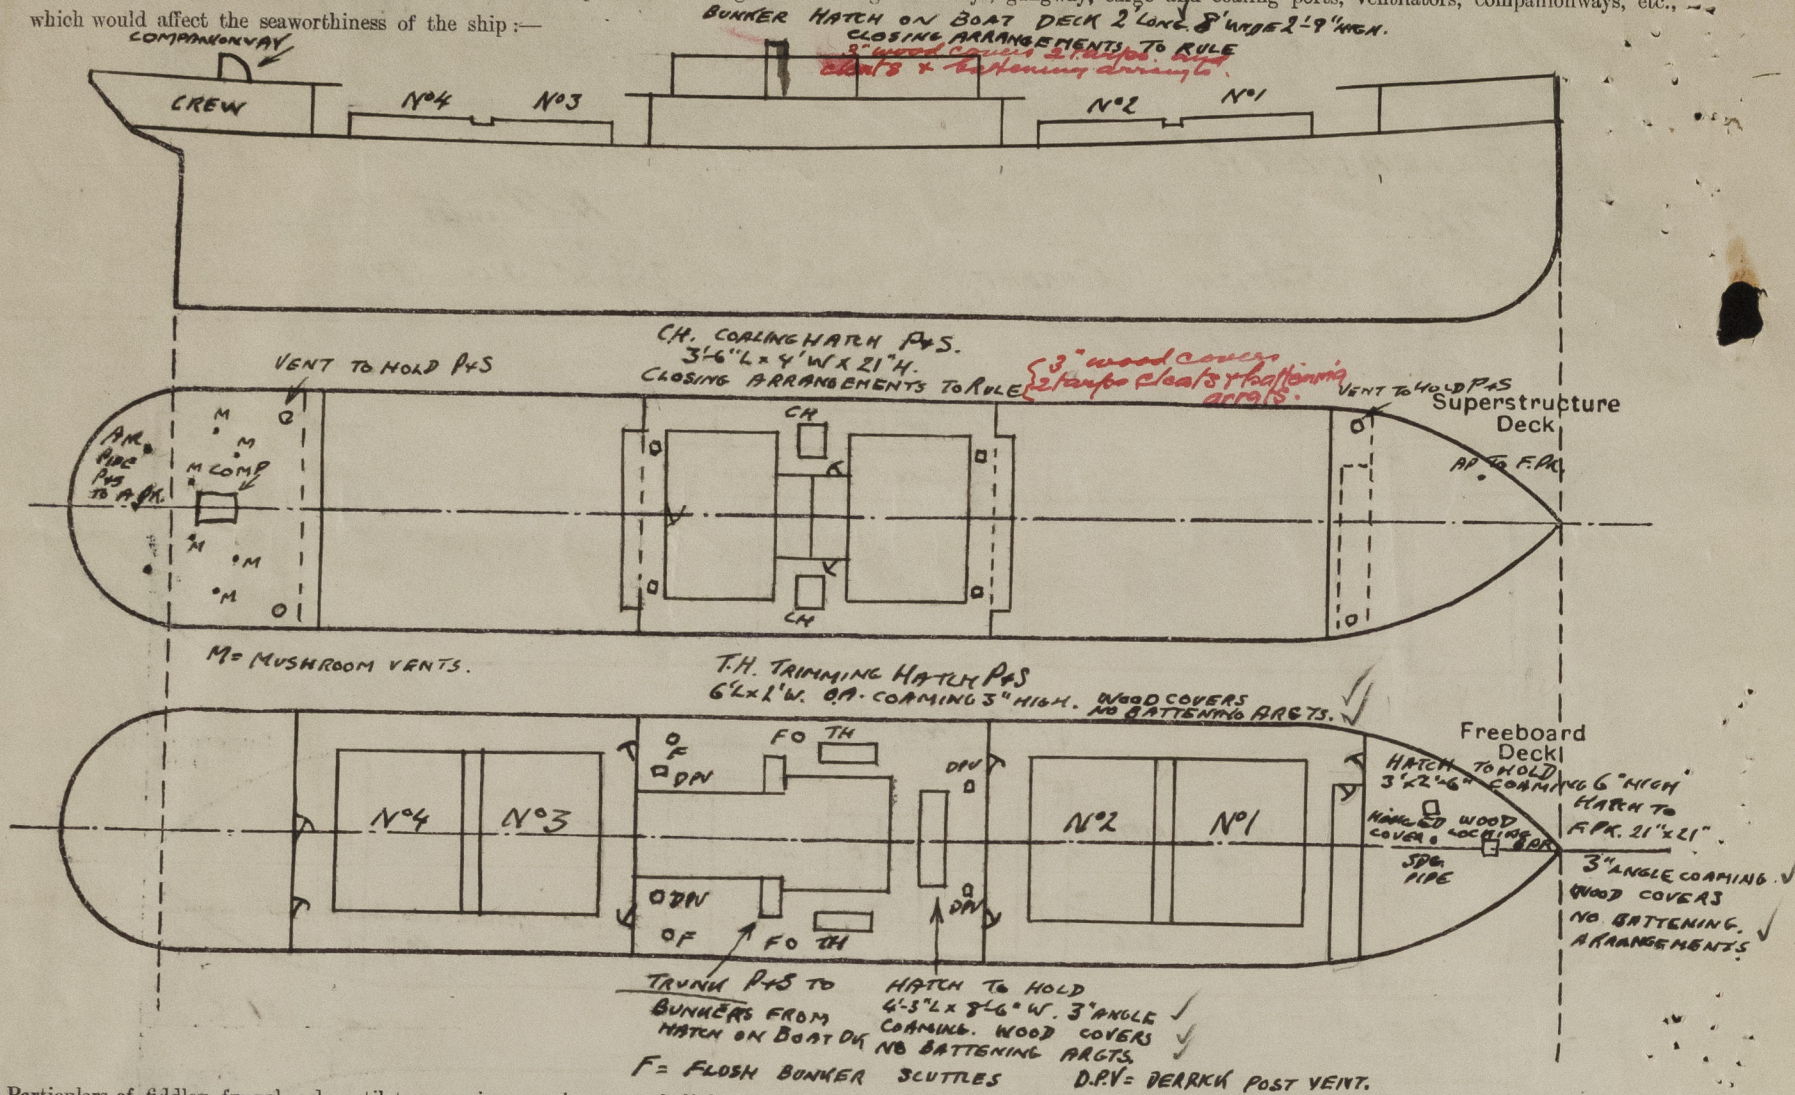

Particulars of fiddle, funnel and ventilator coamings, engine room skylight and other openings in machinery casing tops and their means of closing :-

FIDLEY OPENINGS. GRATED STEEL HINGED COVERS, CLIPPED. ✓ FUNNEL COAMM 12" HIGH.
2 VENTS TO STOCKHOLD 24" DIA 10 FT. HIGH. 2 VENTS TO GALLEY 10" DIA. 12" HIGH. ✓
2 " " E.R. 20" DIA. 4' HIGH. ✓
2 GALLEY SKYLIGHTS. STEEL GLASS BULLS EYES. ✓
E.R. SKYLIGHT. STRONGLY CONSTRUCTED IN STEEL. ✓

Particulars of Flush Bunker Scuttles :—

IN BRIDGE TO LOWER BUNKERS. 18" DIA CLOSED BY PORTABLE PERFORATED PLATES.
2 EACH SIDE.

Particulars of Companionways :—

ON POOP TO CREW SPACE 5' L X 3' W. X 5'-6" H. X 9/16" STEEL. 316 18" HIGH. STOUT WOOD DOOR 3'6" X 2'6" HINGED

Particulars of Ventilators in exposed positions on freeboard and superstructure decks :—

ON OVERHANG OF FORECASTLE DECK. 30" X 20" DIA. X 5/16" (1 P. 15) TO HOLD ~~4~~ ✓
ON BRIDGE DECK TO HOLD 4 DERRICK POST VENTS 18" X 18" EXTEND ABOUT 10' ABOVE ^{BRIDGE} ~~POOD~~ DECK ✓
ON POOD DECK TO HOLD 1 P. 15. 30" X 20" DIA. X 5/16". 6 MUSHROOM VENTS 9" DIA. X 9" H TO CREWMEN PER SKEW. ✓
ALL VENT COAMINGS FITTED WITH WOOD PLUGS & CANVAS COVERS. ✓

Particulars of Air Pipes in exposed positions on freeboard, raised quarter, or superstructure decks :—

ON FLE DECK 1-4" DIA OPENING 6" ABOVE DECK. IN FLE 1 SOUNDING PIPE 2 1/2" DIA 24" HIGH TO FPK. ✓
IN FORE WELL. 20, 23 TO DB TANKS. 3 DIA 30" HIGH ✓
IN AFTER WELL " " " " " " ✓
ON POOP. DECK. 1P 13 TO ADK TANK. 6" DIA. OPENING 6" ABOVE DECK. ✓
ALL AIR PIPES FITTED WITH WOOD PLUGS. ✓

Particulars of Gangway Cargo and Coaling Ports:—*NONE*

Elizabeth.

Particulars of Scuppers and Sanitary Discharge Pipes :—

IN POOR. 1P.15. 8" DIA DISCHARGE FROM CREWS W.C.'s NON RETURN VALVE AT SHIP'S SIDE. DISCHARGE 6" ABOVE VAPER DK.
" BRIDGE & SONLY 2-8" DIA DISCHARGES FROM ACCOMMODATION W.C.'s NON RETURN VALVES AT SHIP'S SIDE
12" ABOVE VAPER DK. 1P.15 SQUPPER FROM BRIDGE DECK 4' ~~ABOVE~~ BELOW BRIDGE DECK.

Particulars of Side Scuttles:—

POOR 4P. 4S. 9" DIA. DEADLIGHTS. ✓

* Vertical distance of Sill of lowest Side Scuttle above top of keel

Particulars of Guard Rails :—

POOP BRIDGE & FORECASTLE RAILS 3' HIGH. STANCHIONS SPACED 4'

* Particulars of Gangways, Lifelines, etc. :—

LIFELINE FROM POOP TO BRIDGE. and Bridge to Forecastle.

Particulars of Freeing Arrangements.						
	Length of Bulwark	Height of Bulwark	Size of Freeing Ports	Number each side	Area each side	Rule area each side
After Well	68'-6"	3'-6"	3'-0" x 1'-6"	3	13.5 Sq. Ft.	13.7 K ²
Forward Well	67'-0" 67'-5"	3'-6"	do	do	13.5 Sq. Ft.	13.5 K ²

State position of each freeing port	After Well:—	FROM BAIRFOND.	16', 36' 58'	15" ABOVE DECK
and A. position and height above deck edge)			Forward Well:—	" " "	9', 25' 41'	15" " "

State whether the freeing ports are fitted with shutters, bars, or rails, and give particulars of such:— *A WELL 3VENT, 2⁷ FLAT BARS*
F WELL 4 " BARS.

Additional area where sheer is less than standard.


PARTICULARS OF PROTECTION TO OPENINGS, ETC.

HATCHWAYS ON FREEBOARD AND SUPERSTRUCTURE DECKS. IN FOREWELL TO F.HOLD. IN A.WELL TO A.HOLD												
Description of Hatchway	...		N°1	N°2	N°3	N°4						
Dimensions of Hatchway	...		18'x18'W									
COAMINGS	{	Height above Deck	TRUNK 36" HATCH 42" ✓									
		Thickness	Sides ... 1/2 ✓									
			Ends ...									
		Stiffeners	2/SIDE.									
		Brackets, Stays	2x3x3/8									
HATCH BEAMS	{	Number	5									
		Spacing	4'-8" ✓									
		Scantling and Sketch	7" ✓ 4x3 15" C 12" ENDS 3/8 1 1/2 SEE SKETCH	AS PER N°1								
		Bearing Surface	SEE SKETCH									
FORE AND AFTERS	{	Number										
		Spacing										
		Unsupported Lengths										
		Scantling* and Sketch	NONE ✓									
		Bearing Surface										
HATCH COVERS	{	Material	WOOD									
		Thickness	3"									
		How fitted	F&A ✓									
		Bearing Surface	3"									
Spacing of Cleats	...		23" ✓									
Number of Tarpaulins	...		3 ✓									
<p>*Are wood fore and afters steel shod at all bearing surfaces? ✓</p> <p>Are battens and wedges efficient and in good condition? YES ✓</p> <p>Are tarpaulins in good condition and in accordance with rule requirements? YES ✓</p> <p>Are lashings provided in accordance with rule requirements? YES ✓</p>												

Particulars of any special features :—

Endorsement at first survey and at surveys for renewal of Certificate :—

The fittings and appliances are in accordance with the particulars shown on this form (or as now modified) and are in good condition.

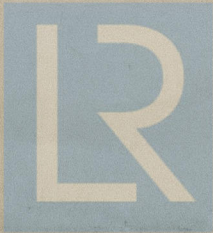

© 2020

Lloyd's Register
Foundation