


SEA 3860

# Lloyd's Register of Shipping,

Letricheux Buildings, Adelaide Street,


Swansea, 16th. July, 1932.

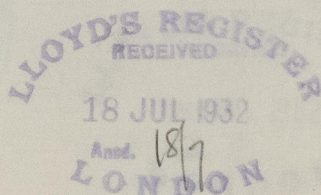

Dear Sir,

In regard to the Assignment Letter of the 15th. instant respecting the new Freeboard for the steamer "BADJESTAN", we have inform you the conditions have now been carried out with one exception.

The freeing port area in the after well has again been checked, and there are five ports each 4'0" long x 1'6" wide. The area of these has been calculated to be 27.25 sq. ins.

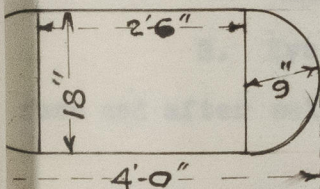

We should be pleased to hear if it is necessary for an additional port to be cut.

The vessel is expected to sail on Wednesday next.

We are, Dear Sir,

Yours faithfully,

Secretary,  
LONDON.



*R. H. Armstrong*

pro The Surveyors.

Lloyd's Register  
Foundation

005480-005488-0080

005480-005488-0081



Referred to the Chief Ship Surveyor:  
(Freeboard).

F.A.H.

18 JUL 1932

Wig cut

Particulars of alterations  
is submitted for issue.  
as the freeboard is  
found to be necessary.  
is

noted on report.  
he sent to the Surveyor  
then he informed that  
the area after well has  
no increase in area  
27 1/4 sq. ft.  
J.B.C.  
18/7/32

© 2020

Lloyd's Register  
Foundation