

10/12/18
17/2/19 (283/6)

SINGLE PLATE RUDDER.



S.S. 283-4-5-6. N° 268-290
(10-1-10)

SCALE 1" = ONE FOOT.

HOLES IN RUDDER ARMS BORED $1\frac{1}{16}$ FOR 1" RIVETS AND COUNTERSUNK.

SPACED $4\frac{1}{2}$ DIAS. GR. TO GR. PINTLES $2\frac{1}{4}$

SPEED UNDER 10 KNOTS.

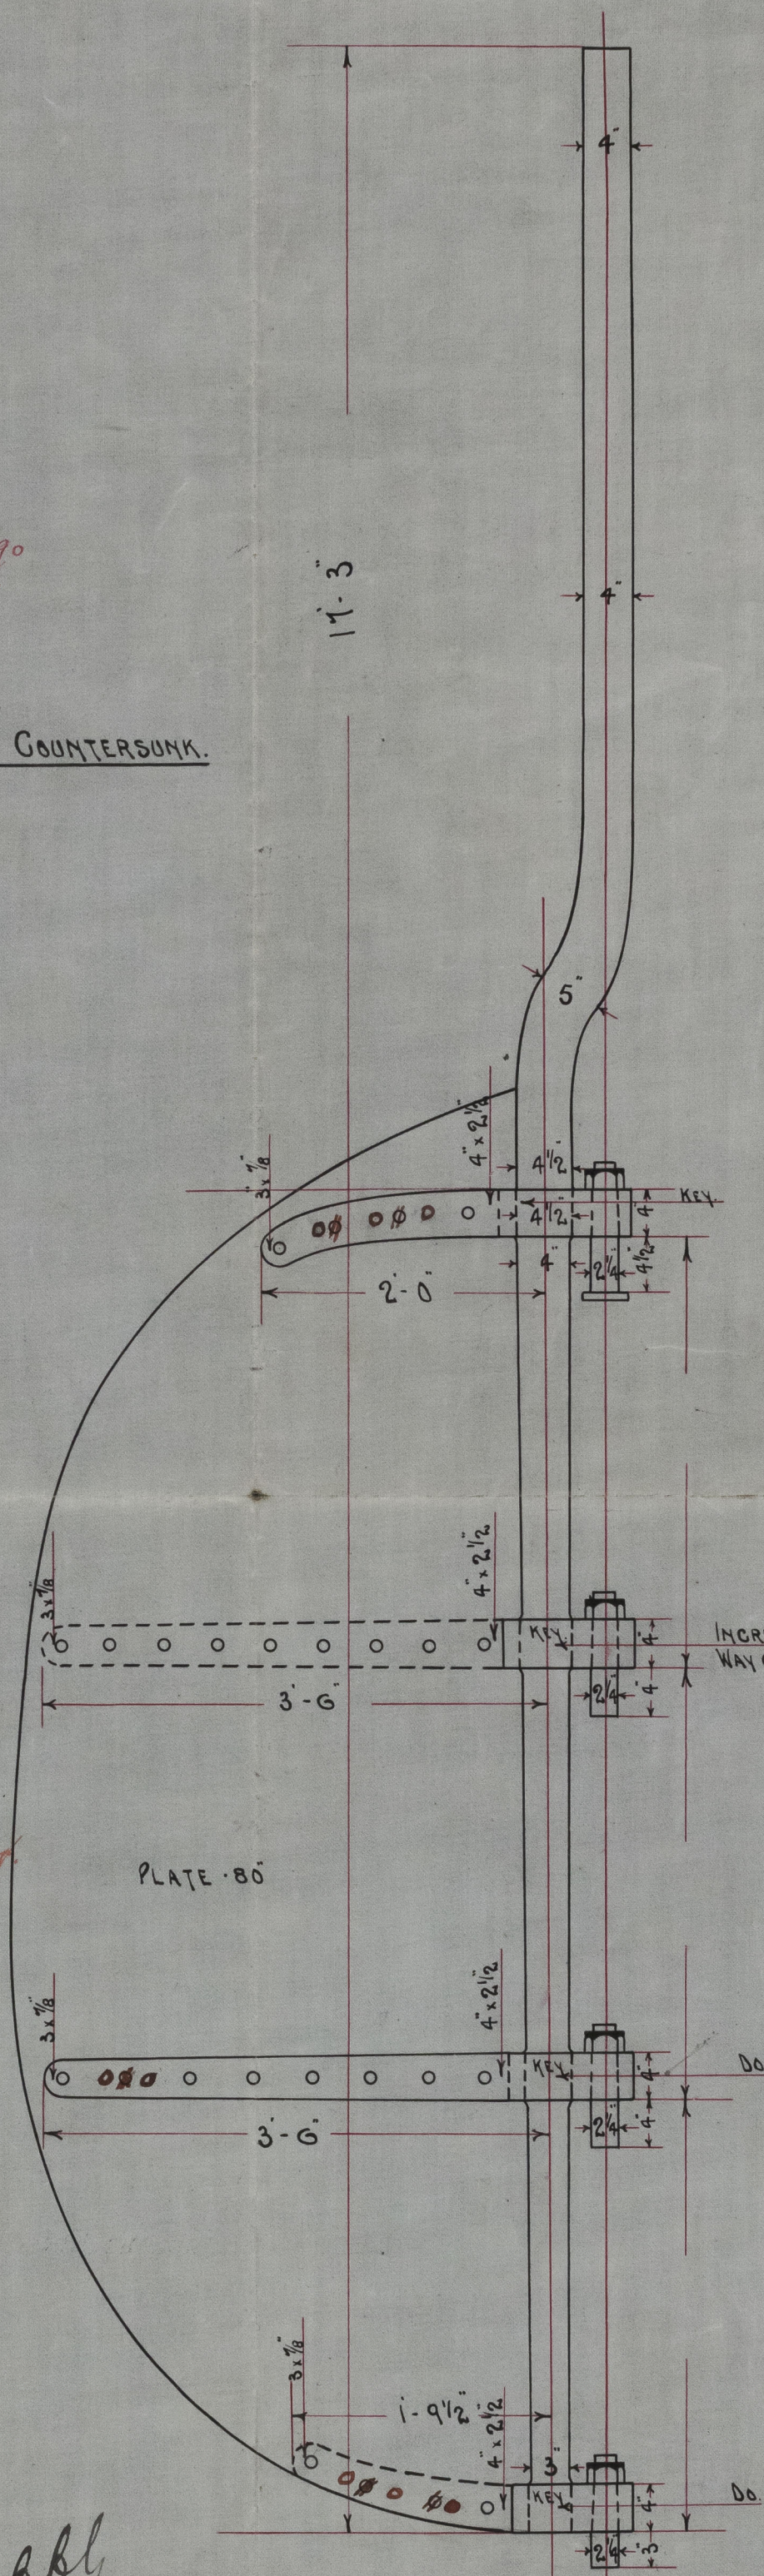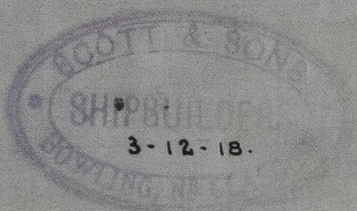

Rivets to be spaced 4 1/2 dia apart.

PLATE - 80


bbf
9. 12. 18

APPROVED for 268-290

LLOYD REGISTER OF SHIPPING

Montgomery

20. 2. 20

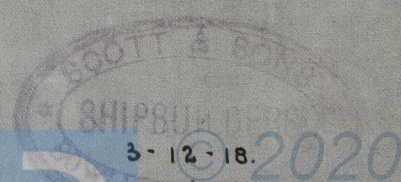

Lloyd's Register Foundation

005480-005488-0146

- SCOTT & SONS. -

- RUDDER PLAN. -

- Nos 283-4 - 5-6

Will.
4.12.18.

GLASGOW REPORT No 3931³~~5~~
Saint Barchan.

Glasgow Report No 39452
5/8 Balfour.

No 286

Glasgow Report No 40230.
1/8 "Saint Aidan"



© 2020

Lloyd's Register
Foundation

005480-005488-0146