



25/3/22

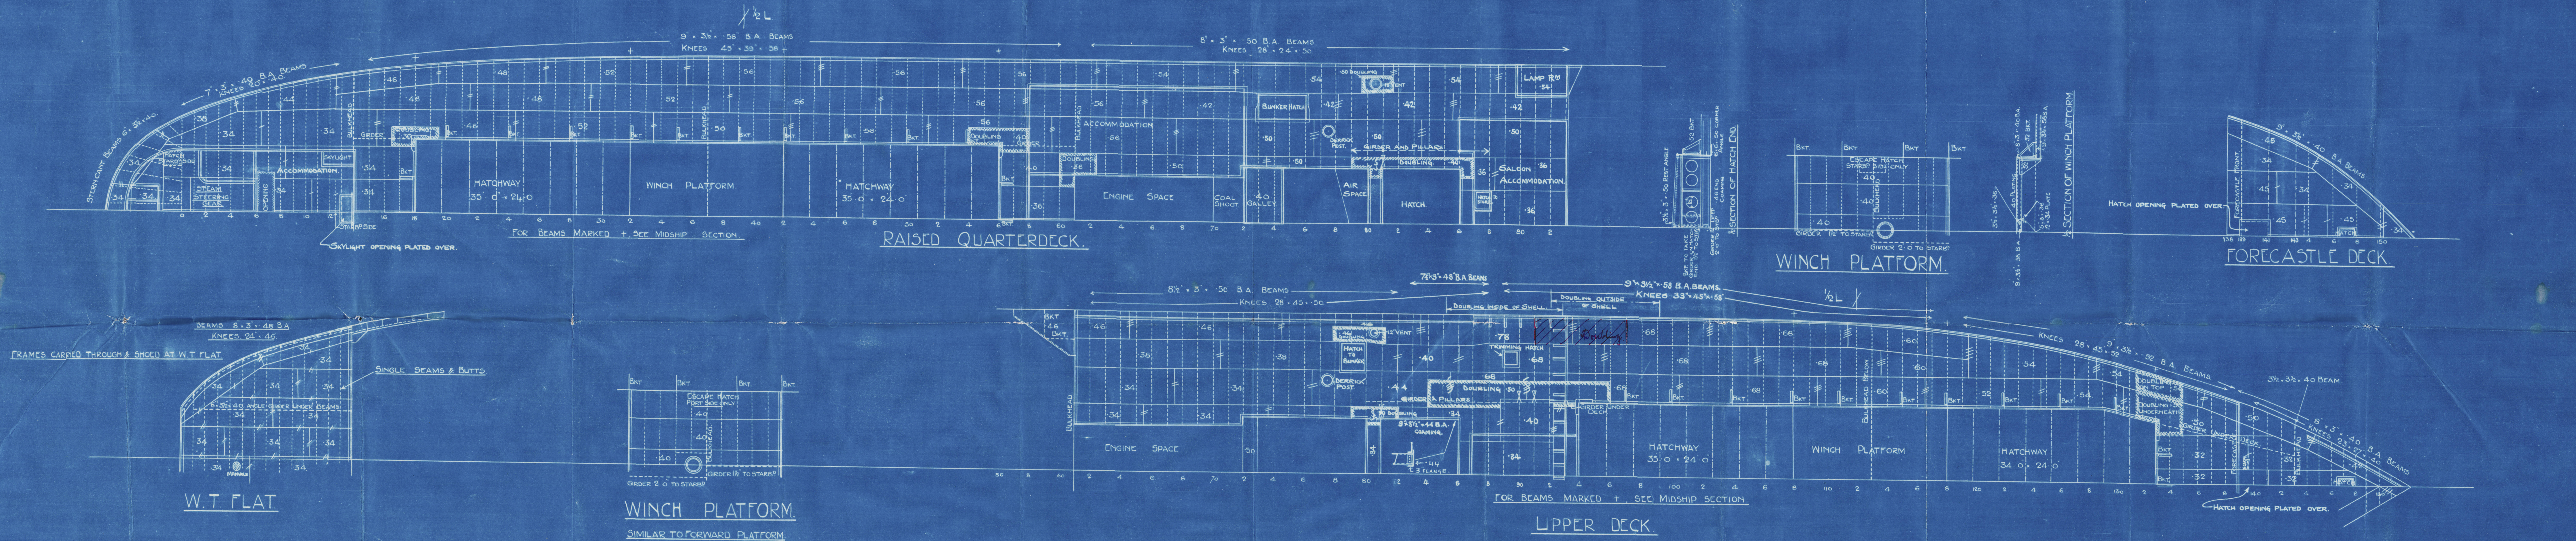

S.S. No 544.  
DECK PLAN.

SCALE = 1/8" = 1 FOOT

25/3/22

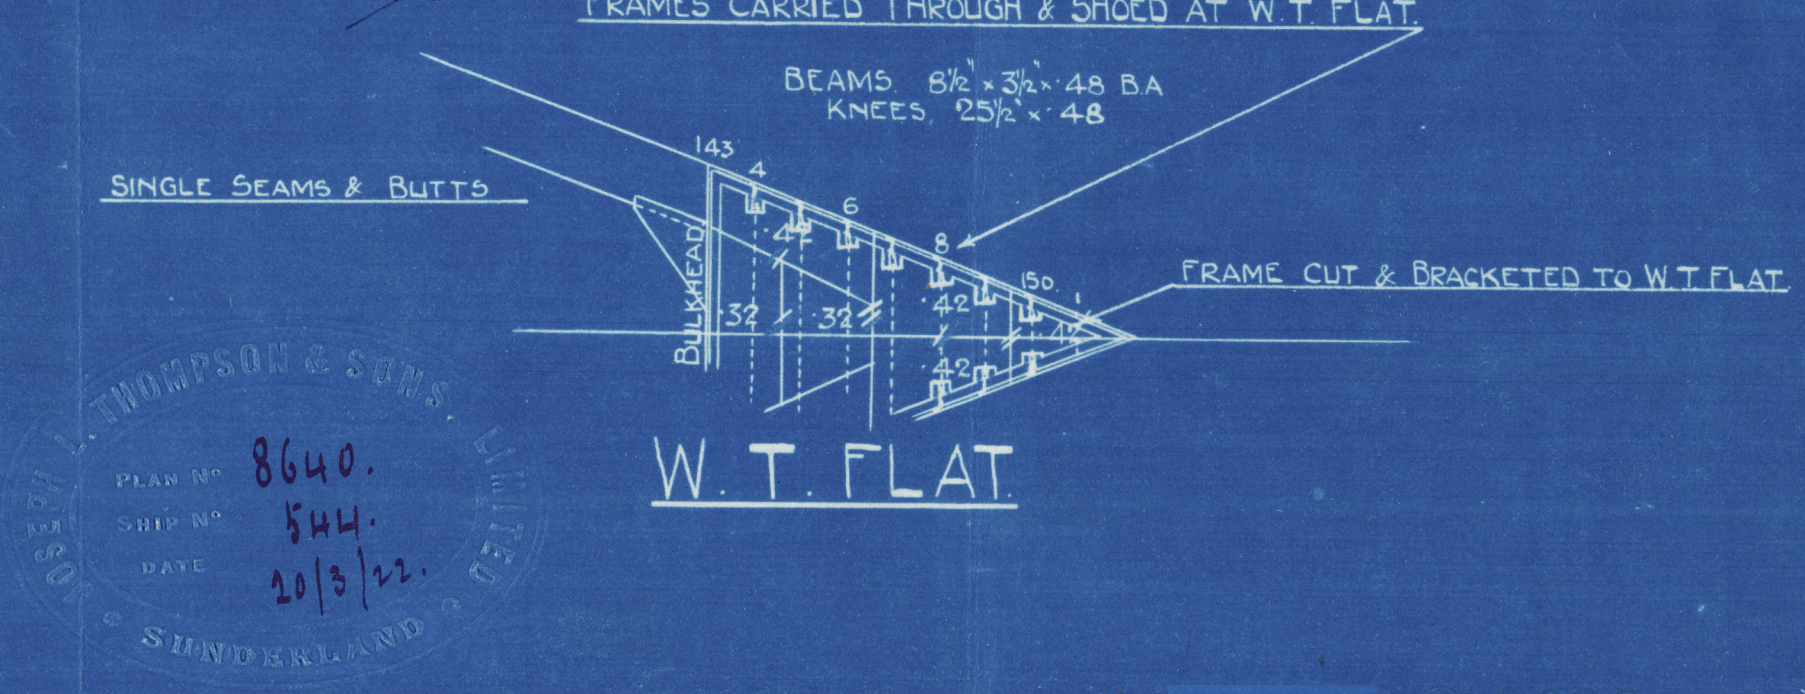



S. S. 544.

Amended Deck Plan.

SUNDERLAND

J. L. THOMPSON & SONS LTD

S. S. N<sup>o</sup> 544


AMENDED

DECK PLAN

n/n "Bushranger"

S. S. STAKESBY

SUNDERLAND RPT. N<sup>o</sup>. 28425.

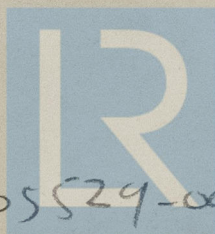

© 2020

Lloyd's Register  
Foundation

005529-005526-0154