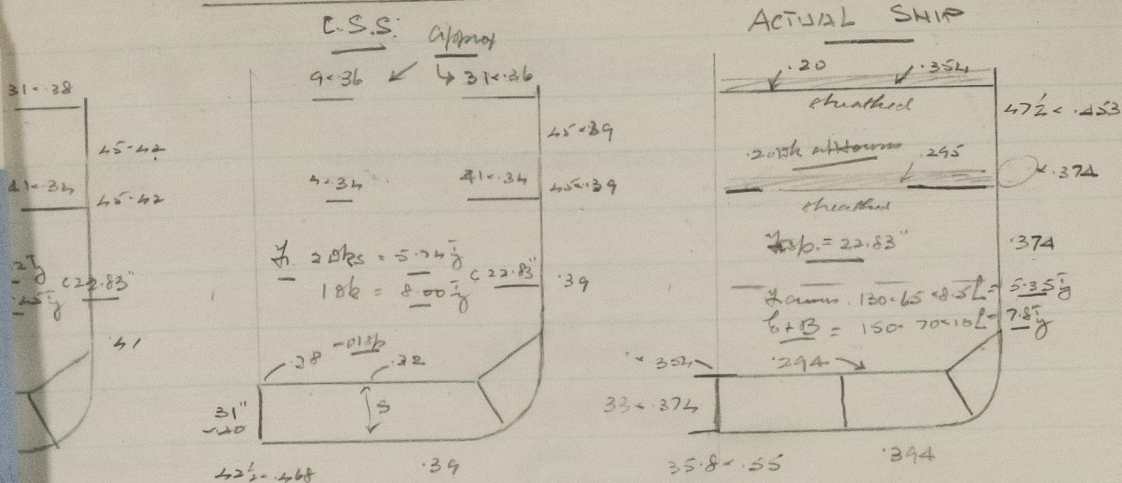


$$193 \times 31.1 \times 23.3$$


we 2 obs

= CSS

3 Shes

= CSS

- 02

contre

- 01

einander

— 01

F.S.

shell

= CSS

Shull

- 01 below CSS

+ 0.3 above FS | + 0.6 above CSS

Low

- 02 below ESS

be stringer

$$= \text{cs}$$

1 + 8k plating

above 155 in area

stringer

-04 below CSS

62

it is only entitled
CBS. draft on the
ting Scanlunigs.

9.7.
3.2.36

© 2021

Lloyd's Register
Foundation

005625-005643-0063

Caught - 15-6