



To class\* A 1 at Lloyds, for coasting service on the Bosphorus  
& Sea of Marmora  
Scales Profile =  $\frac{1}{4}$  inch = 1 Foot, & Section  $\frac{1}{2}$  inch = 1 Foot.



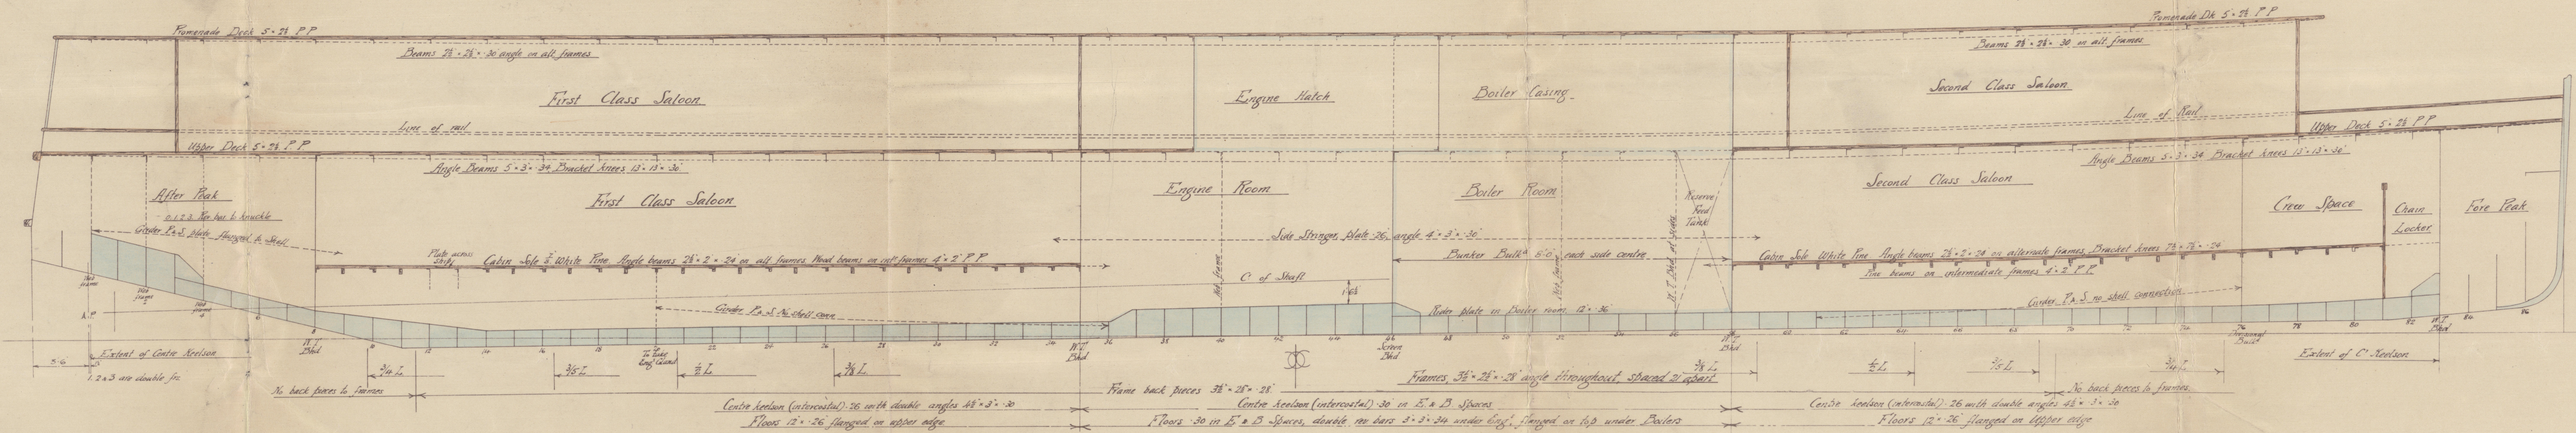

The Fairfield S B & Co  
No 475  
Midship Section &  
Profile as built

"Bosphorus 65"  
GLASGOW REPORT No: 29167

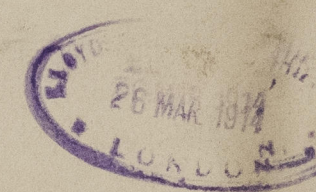

© 2021

Lloyd's Register  
Foundation

005671-005683-0174