

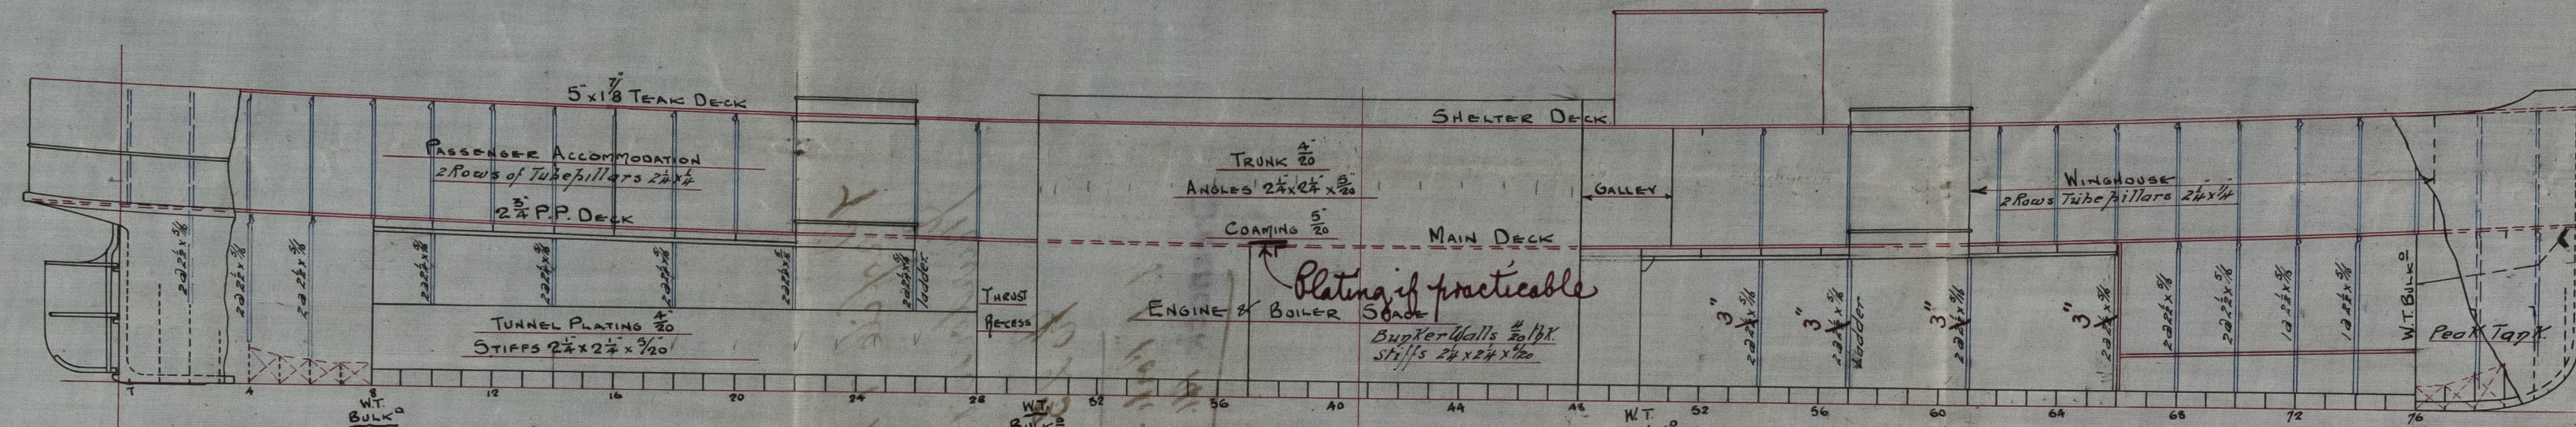


18-3-10.
7-4-10
9-4-10
27-4-10

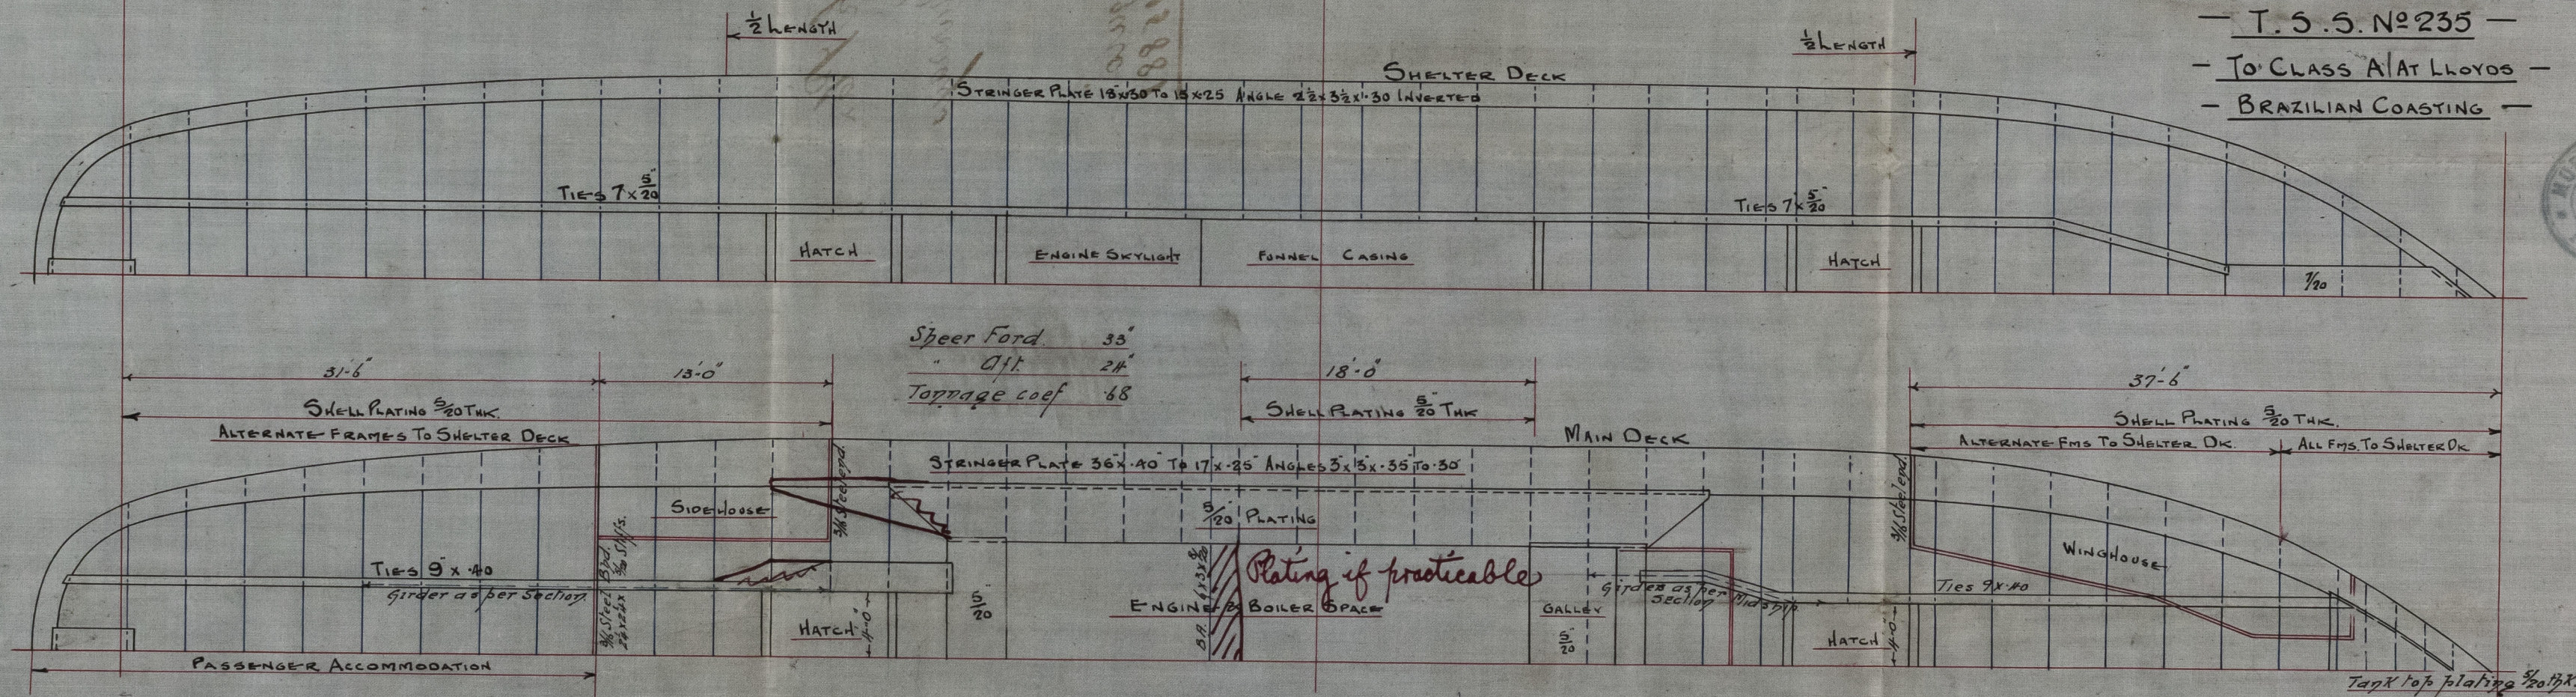

Beams in peak 3 1/2 x 2 1/2 x 26
of every frame
Paying beams 1 x 2 1/2 x 1/2
Pillars 3 x 3 x 1/2
Washplate 1/20

— PROFILE & DECK PLANS —
— T.S.S. No 235 —
— TO CLASS A AT LLOYDS —
— BRAZILIAN COASTING —

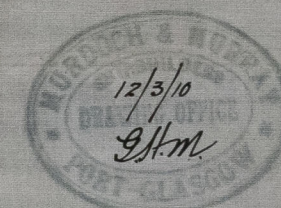



Scale 1/8 inch = 1 foot
Drawing No 7380

C.T.
18/3/10

Profile & Deck Plan Murdoch & Murrays

No 235

S. S. Porto-Seguro
Greenock M. No. 15881

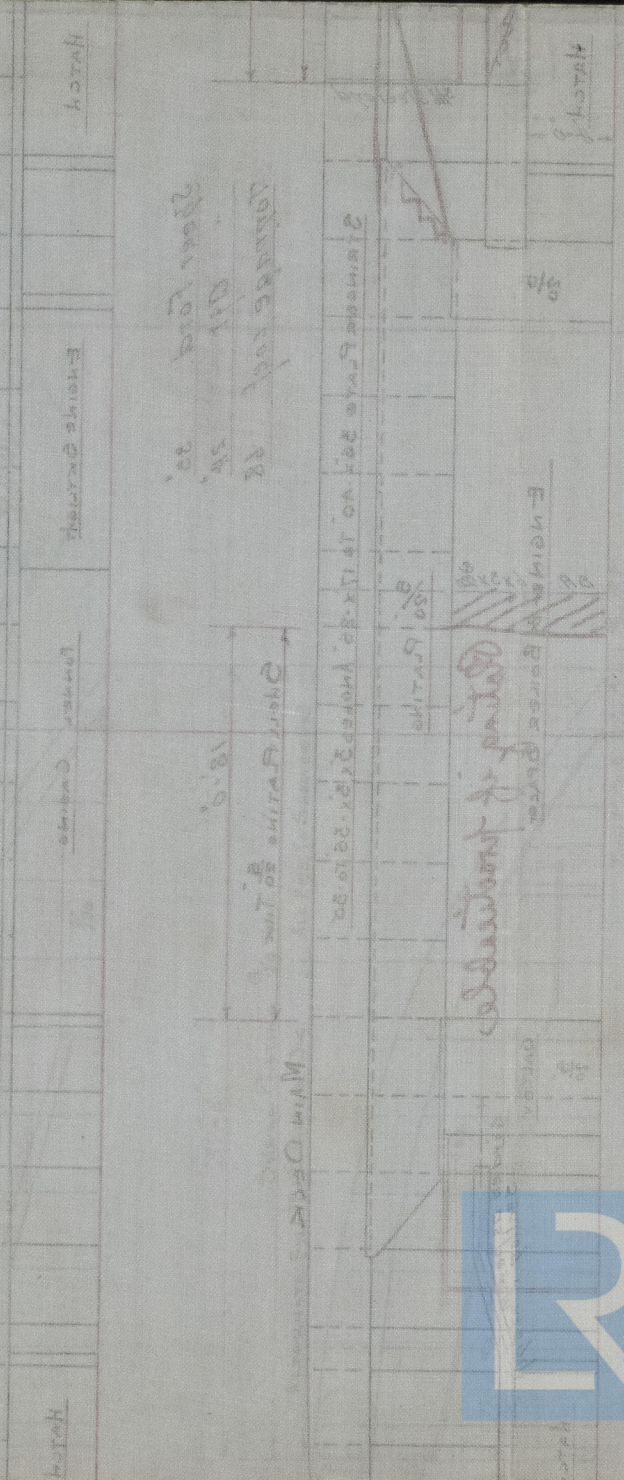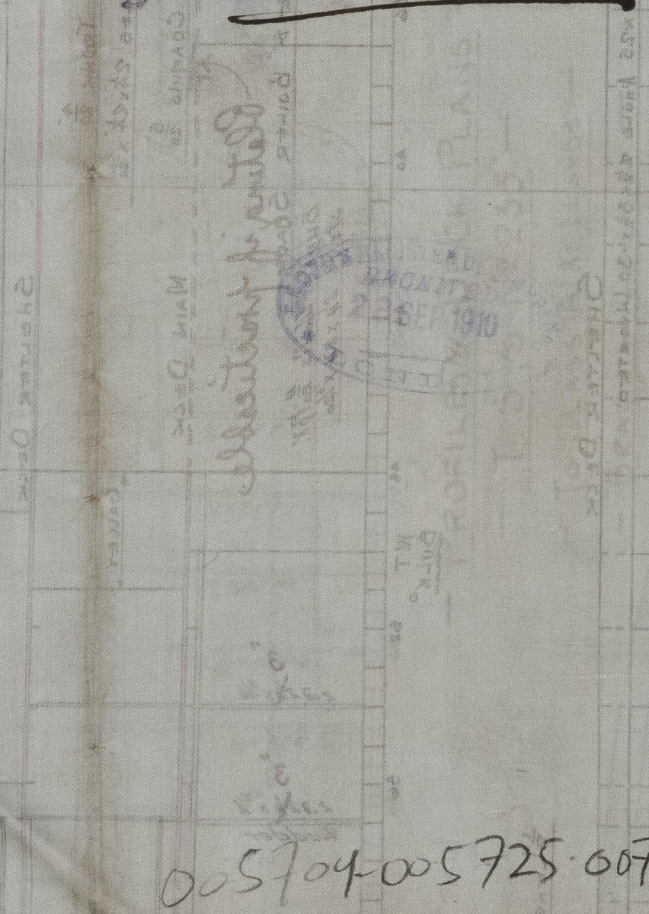

© 2020
Lloyd's Register
Foundation

005704-005725-0073