

15.3.12

No 269.

MIDSHIP SECTION OF A SEA GOING STEAMER

DIMENSIONS

LENGTH 99' 0" MLD


BREADTH 18' 5 1/2"

DEPTH 9' 0"

SHEER FORE & AFT 2 3/4"

SCALE 1/2" = 1 FOOT

DETAILED PLAN OF CARGO HATCH
TO BE SUBMITTED LATER

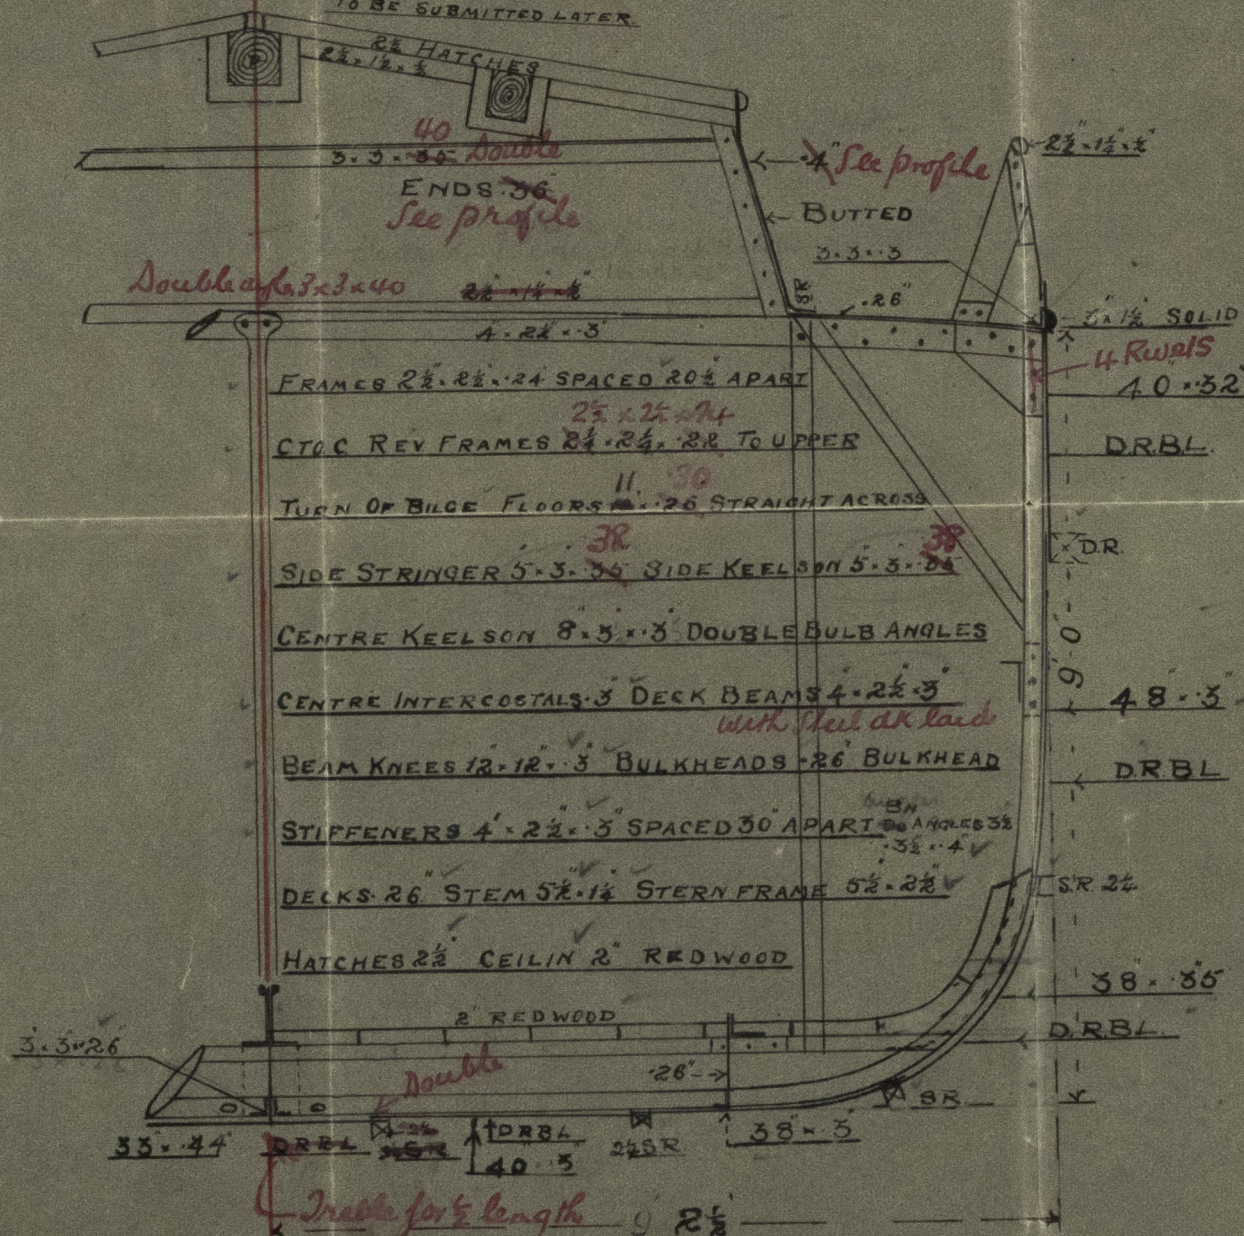

EQUIPMENT

TWO 5 1/2 CWT EX STOCK ANCHORS

ONE 3/4" STREAM

ONE 1/2" KEDGE

120 FATHOM 1/8" STUD CHAIN CABLE

45 5/16" STUD CHAIN

75 5/2" HEMP

90 3" HAWSER

PROPORTIONS

LENGTH TO BREADTH 5.36

LENGTH TO DEPTH 11.0

NUMERALS

BREADTH MLD 18.476

DEPTH 9.0

LENGTH BP 99.0

277 + 784

1ST No

2ND No

2734

C.D.
15.3.12



© 2020
Lloyd's Register
Foundation

J. Jean & Son
No. 269.
Midship Section

LLOYD'S REGISTER
OF SHIPBUILDING
12 MAR 1871
LONDON

No. 269

Eligible
Hull Report No. 26128

005156-05176-0256

