


## GENERAL ARRANGEMENT OF SEAGOING STEAMERS

DIMENSIONS

LENGTH 102 6 %  
LENGTH 99 0 BP  
BREADTH 18 7 1/2 M<sup>D</sup>  
DEPTH 9 0 M<sup>D</sup>  
SHEER FORE GAFT 2 3  
SCALE 3/8 - 1 FOOT

Most Supported to  
Surveyors Satisfaction

NOT JULY 1901  
13 MAR 1913  
OF SHIPPING  
FLOYD'S REGISTER

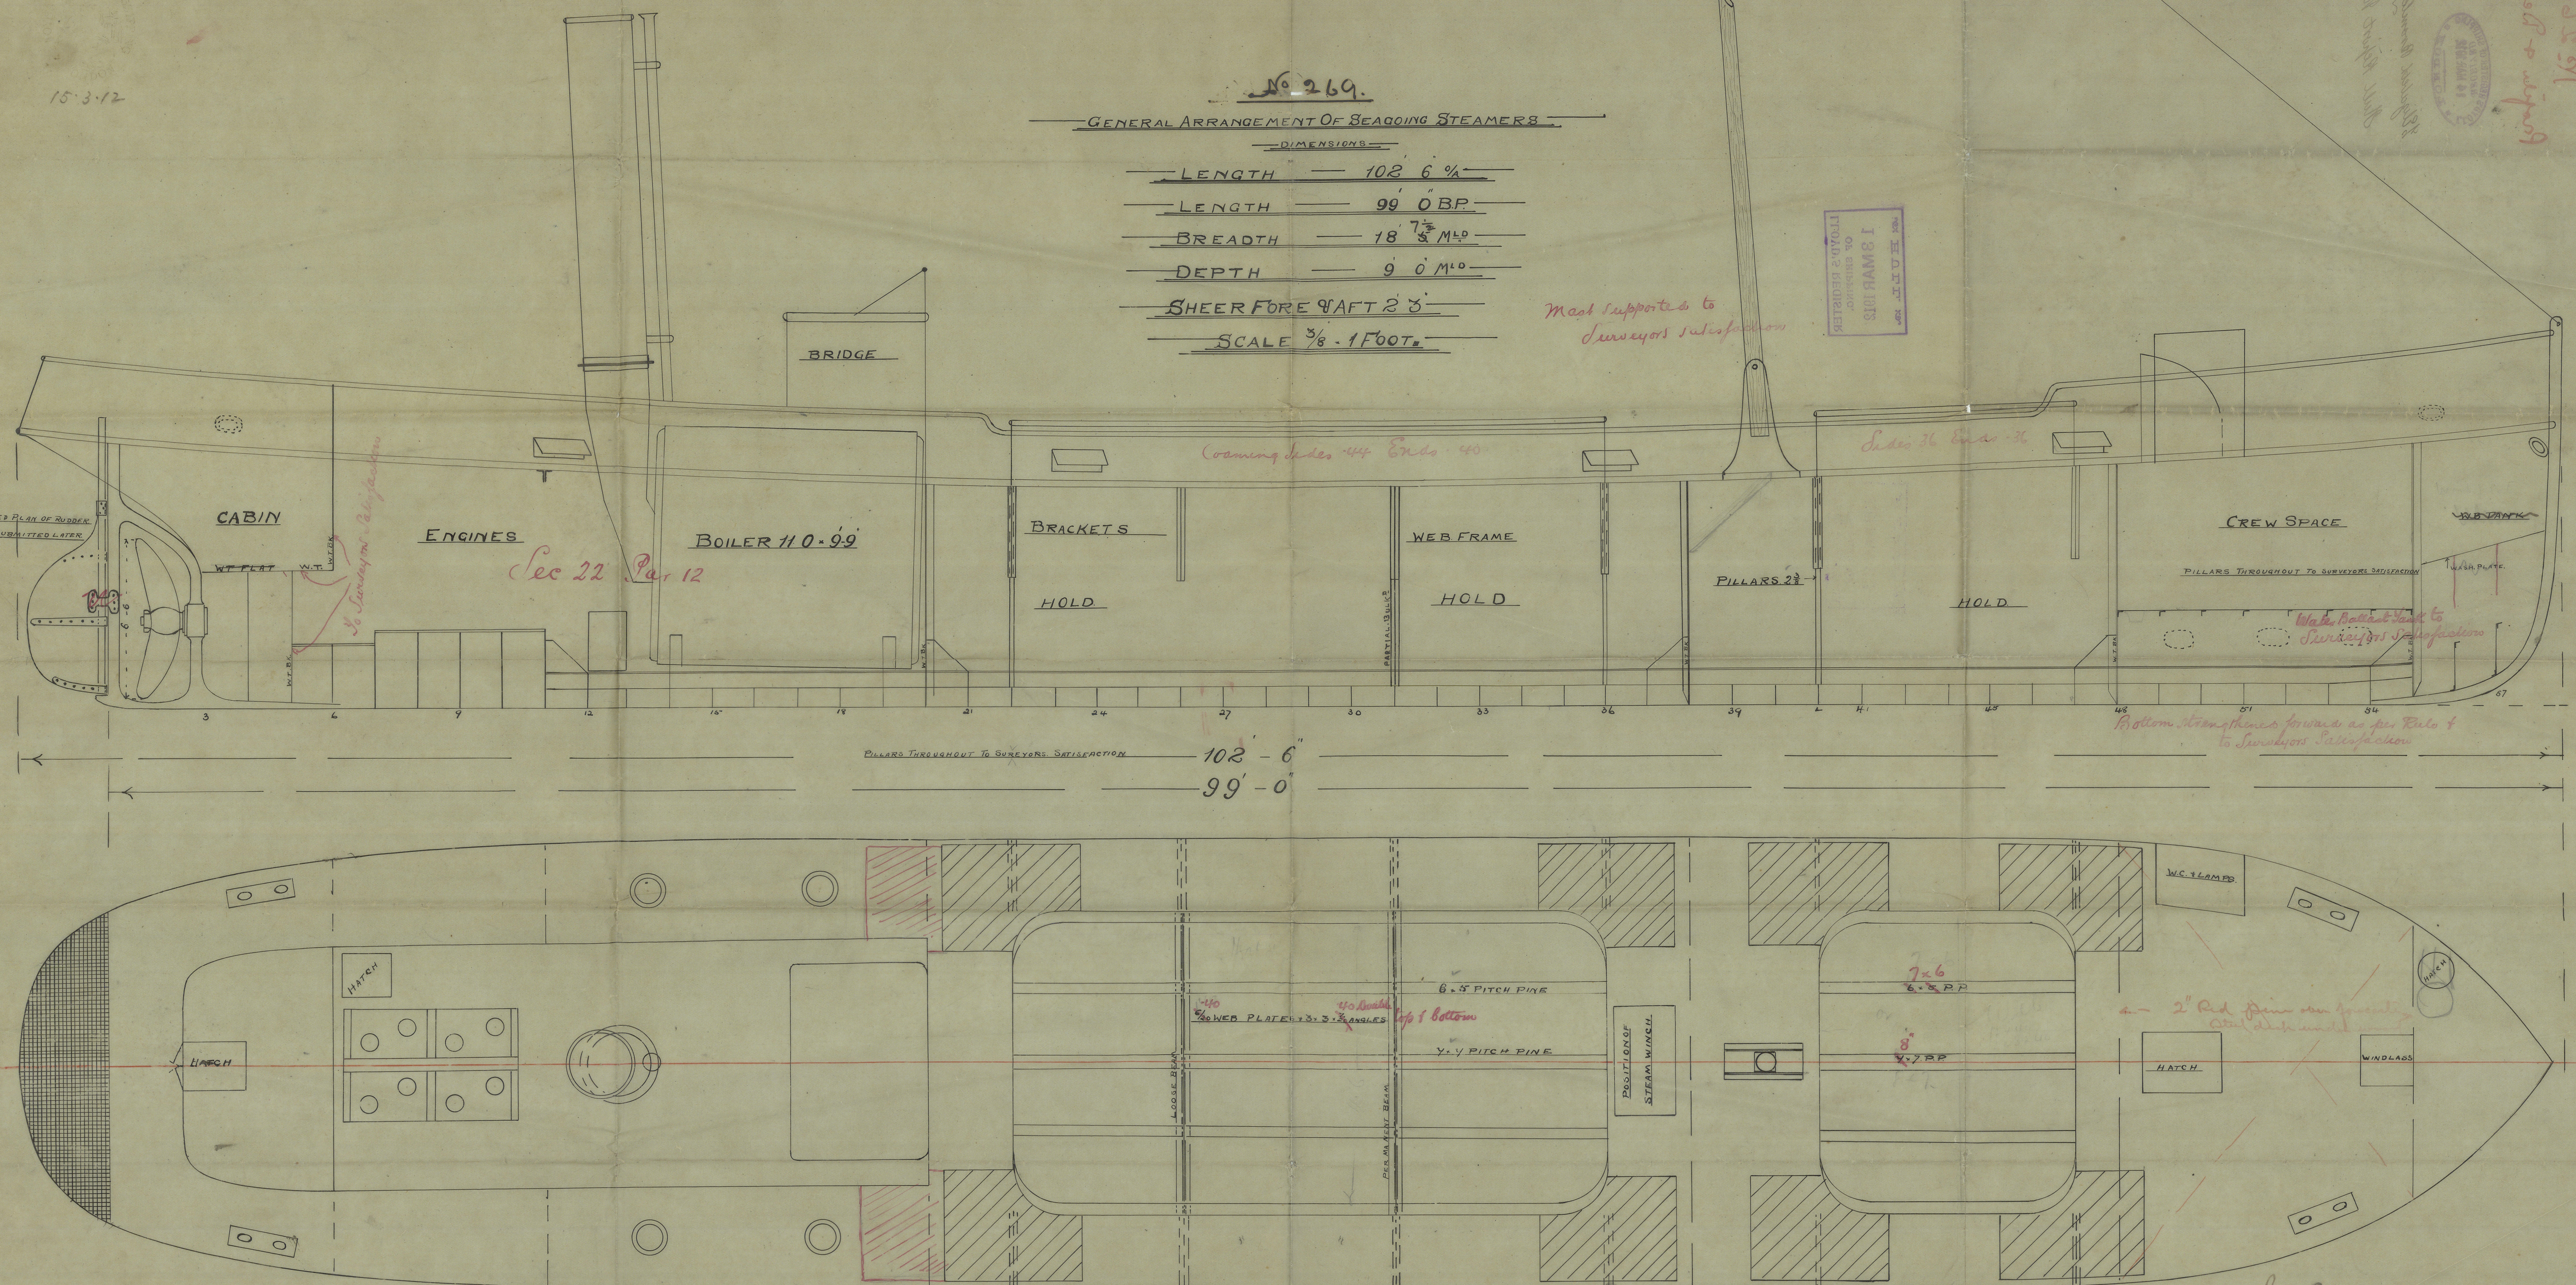

C.B.  
15.3.18.



LLOYD'S REGISTER  
OF SHIPPING.  
13 MAR 1912  
NEW HULL. KX

8-10071-8

STAIRS

0.077

85

— 980 Bb —

20% 2%


© 2020  
Lloyd's Register  
Foundation