

19 SEP 1916  
28.10.16  
5.1.17  
7.3.17


ARRANGEMENT OF SHELL PLATING IN WAY OF WELL

# PROFILE & DECK PLANS

LENGTH B.P. 356'3" BREADTH EXT 48'9" DEPTH MLD 25'11"


SCALE 1/8" = 1 FOOT

55 240

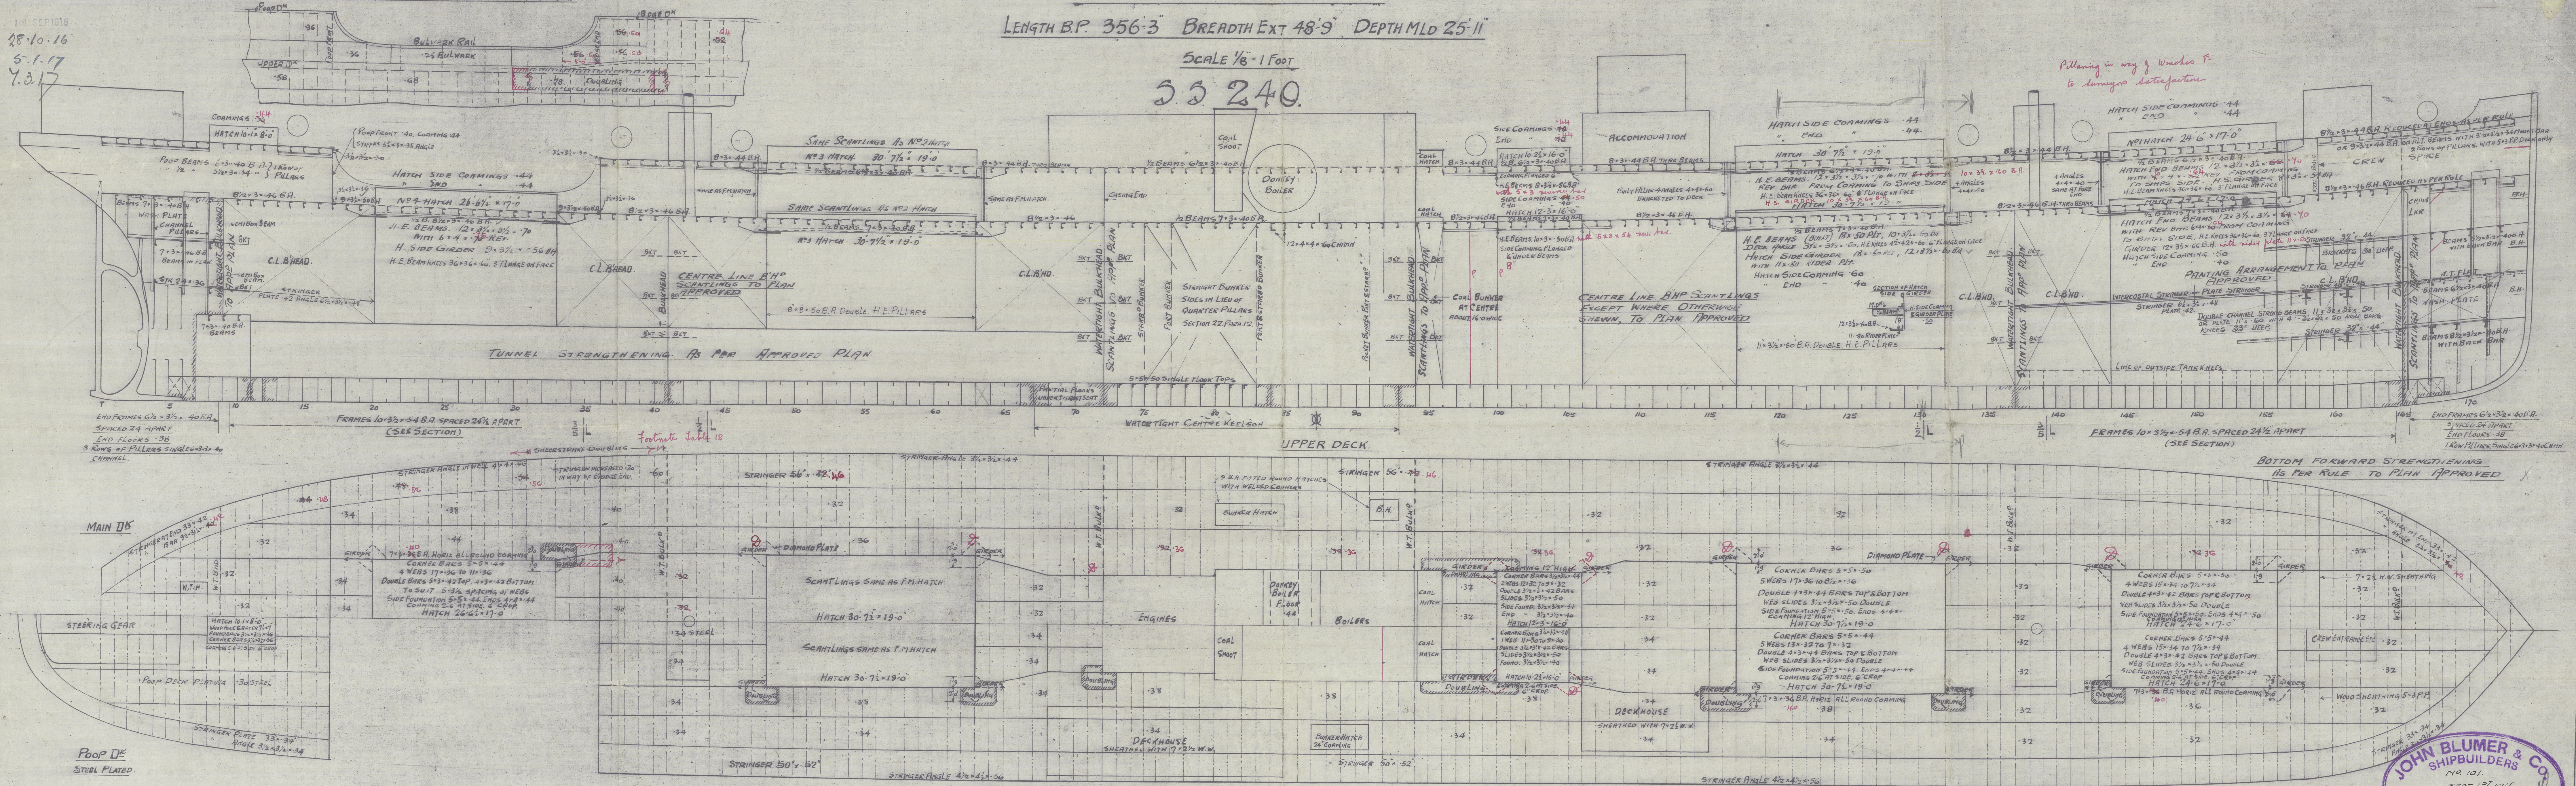

COMBINED BRIDGE & FORECASTLE DECKS

19.4.16

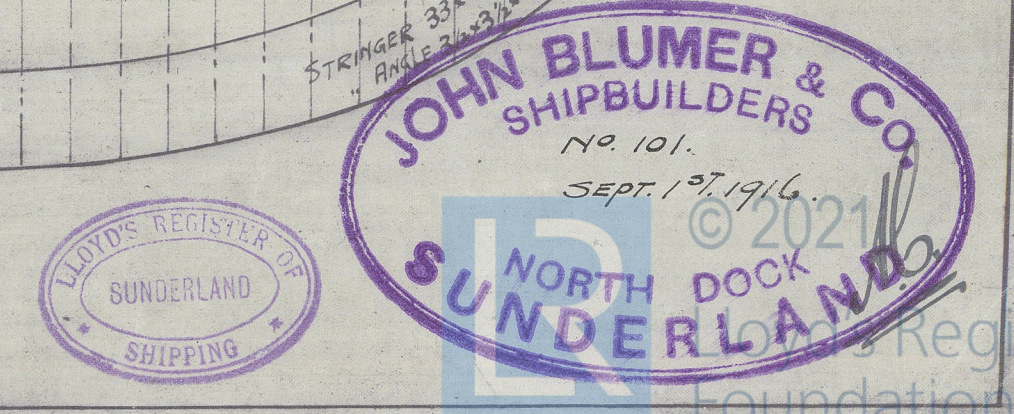



AMENDED PROFILE  
+ DECK PLANS

J BLUMER + CO



WULSTY CASTLE

Nº 240

SUNDERLAND RPT. No. 27274

n/n

"Bonificao"

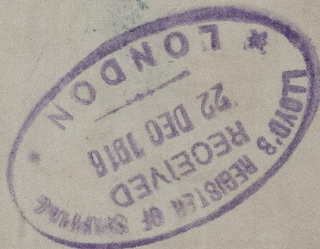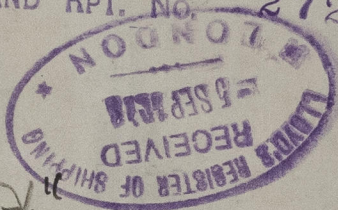

© 2021

Lloyd's Register  
Foundation

005826-005839-0267