YARD No 75-76 — MIDSHIP SECTION — SCALE 1:25.

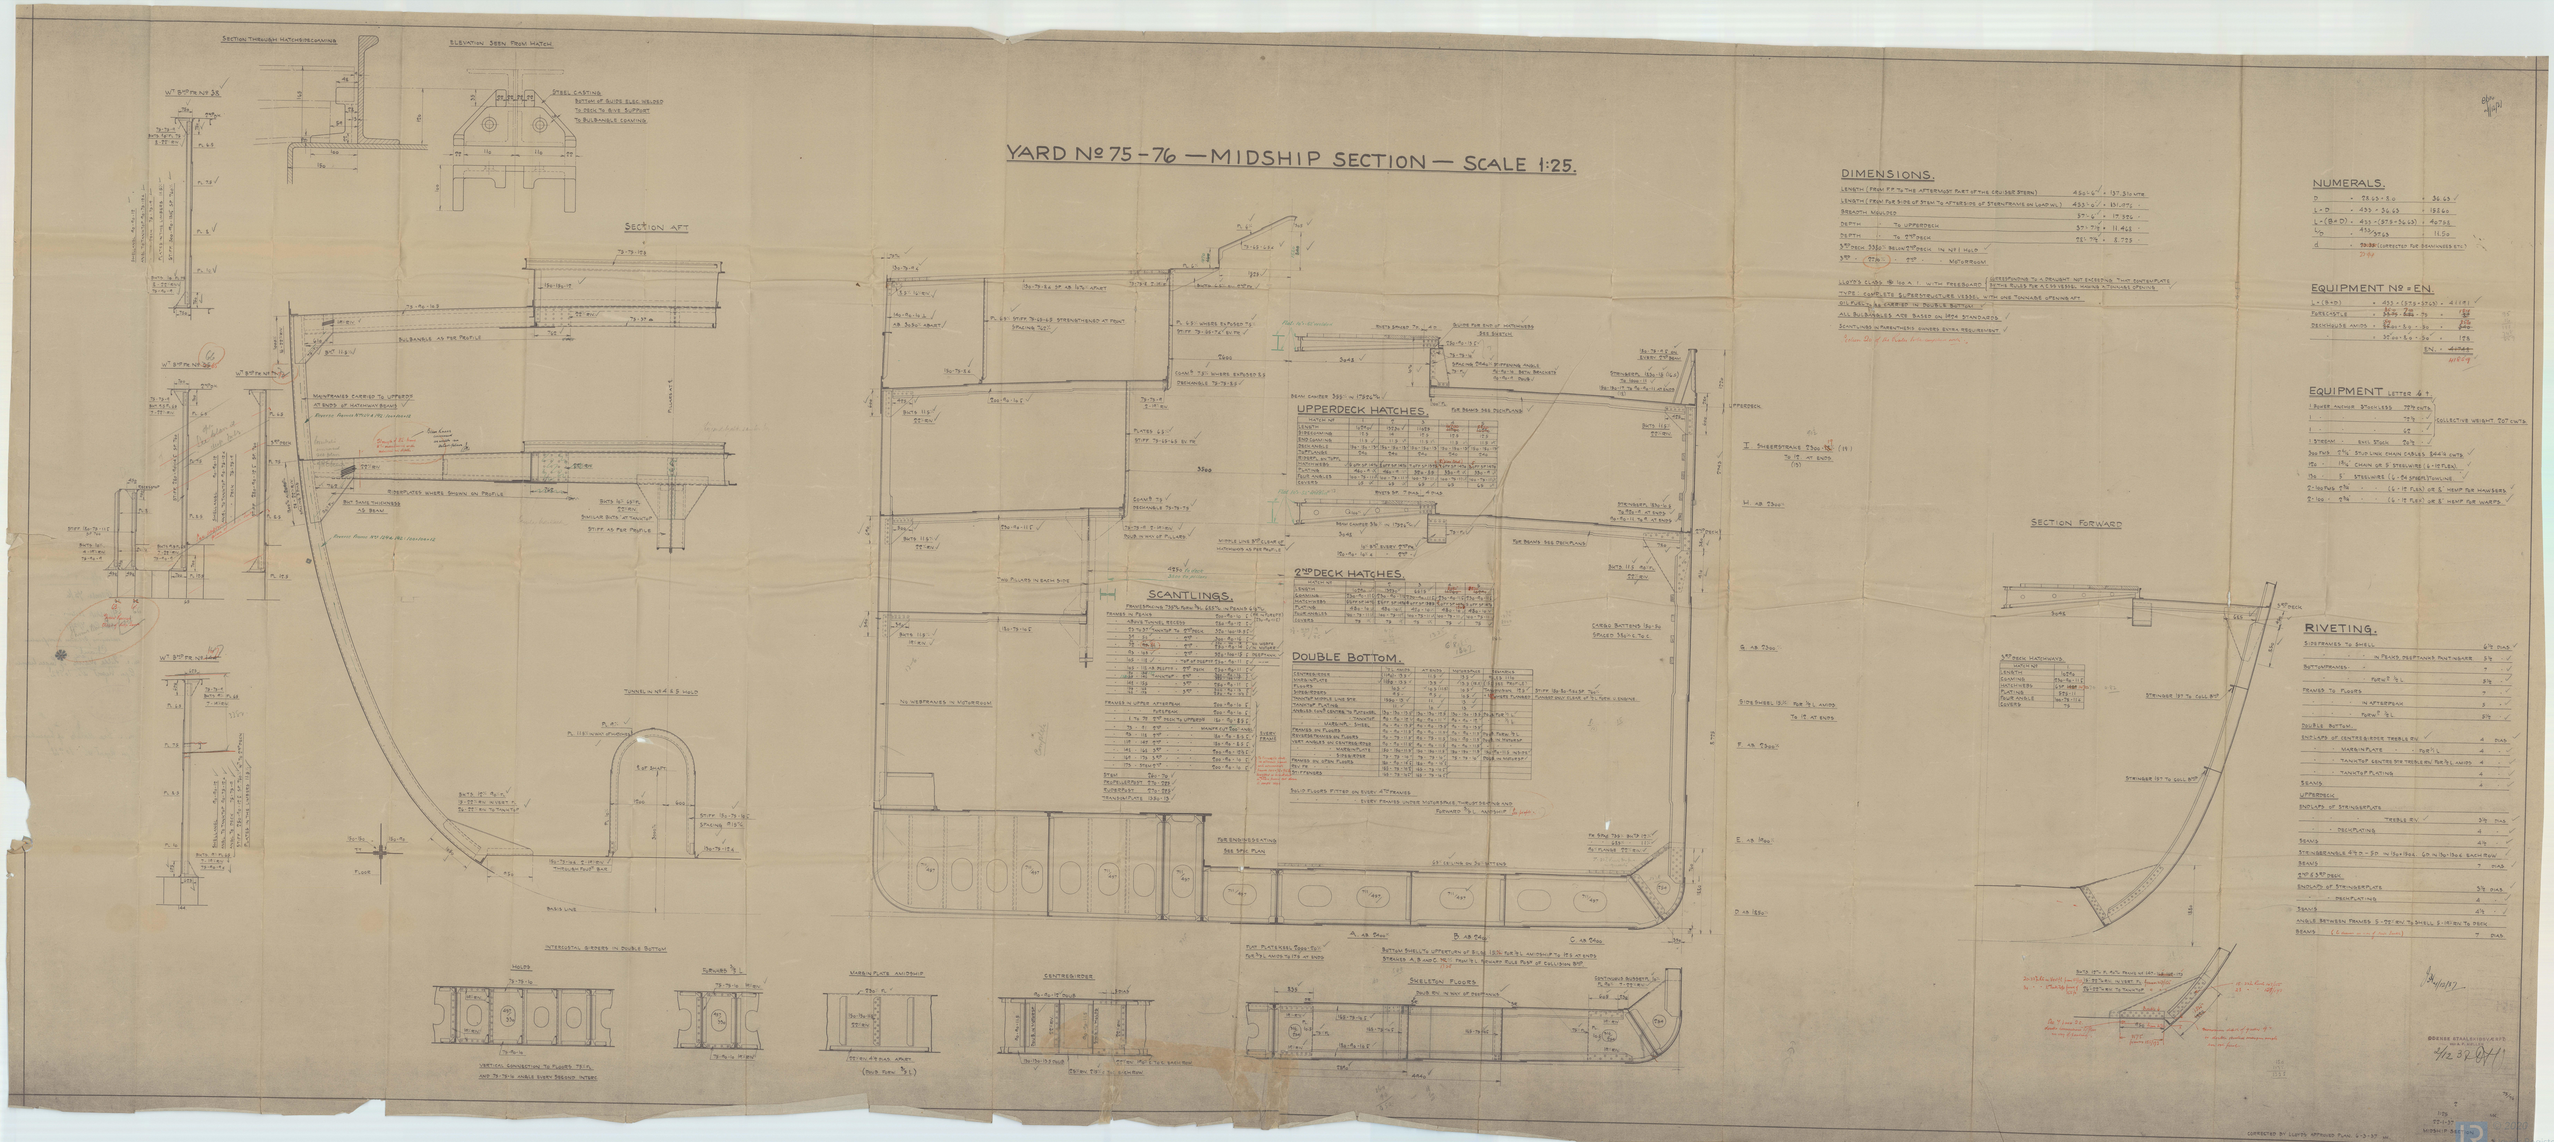

Office of Surveyors

Odense. 4/5/6.

Midship Section

appd. Cpn. 4/12/37

embodying previous modification

Chart

ex

m.s. "Hilda Maersk" of Copenhagen

Cpn. Report No. 10742.

SURVEYORS OFFICE
SKT. GRAVE PLADS 28
COPENHAGEN

m.s. "Lexa Maersk" of Copenhagen

Cpn. Report No. 10918.

© 2020
Lloyd's Register
Foundation

006160-006174-0032