

30638
Rpt. 11b.

Hkg 21/9/32

31131

Index No. 5623
(For London Office only)

Lloyd's Register of Shipping.

SURVEYS FOR FREEBOARD.—STEAM SHIPS.

MON. 11 FEB. 1924

PARTICULARS RELATING TO ALL STEAM SHIPS EITHER FLUSH DECKED, OR WITH TOP GALLANT FORECASTLES, SHORT POOPS AND BRIDGE HOUSES DISCONNECTED, OR WITH TOP GALLANT FORECASTLES HAVING LONG POOPS, OR RAISED QUARTER DECKS CONNECTED WITH BRIDGE HOUSES, OR OTHERWISE.
Hong Kong & Whampoa Dock Co. Ltd. No. 594.

Port of Survey Hong Kong
Date of Survey While building
Name of Surveyor Walter Lang

B.T. CORRECTED

Ship's Name. "YUEN SANG"	Port of Registry and Nationality. London British	Official Number. 152444	Gross Tonnage. 3229.29	Date of Build. 1923	Particulars of Classification. + 100A1 Contemplated
Number in Register Book					

Registered dimensions from Ship's Register.	LENGTH.	BREADTH.	DEPTH.	UNDER DECK TONNAGE.
			To Tank	
		46.09	22.01	2351.15
Length on LOADLINE.	309.5	Frame Depth Rule	81 Ceiling + 20 + 5 1/2 Sheer + .70	2351.15 Includ. Tanks
		2.5 x 2	Drop in Tank + .12	
		- .41		
CORRECTED DIMENSIONS.	309.5	45.68	23.73	2351.15

Moulded Depth as measured..... **25'0"**

Addition for Keel below base line for draught record... **1 1/2** inches.

NOTE.— If the depth is measured when vessel is afloat, the details of measurement should be reported.

Co-efficient of fineness..... **.70**

Any modification necessary [Para. 4 (a) to (e)]* } **C.D.B. .02**

Co-efficient as corrected **.68**

CORRECTION FOR LENGTH.

Length of Ship on Loadline..... **309.50**

Length in Table **300.00**

Difference **9.50**

Correction for 10ft., Table A. **1.3** Table C. **.7**

× Difference divided by 10 **1.235** (if required.) **not required**

If 10ths length covered divide by 2 = **617 = 1/2**

Sheer { Stem..... **84.** } **133.50** ÷ 2 = **66.75** Mean **12 | 25.41**
 at { Sternpost **.49.5** } **3 | 2.117**
 Sheer at 1/2 of the length from { Stem **49.50** } **73** ÷ 2 = **36.5** Mean
 { Sternpost **23.50** } **55%** **66.36**

Gradual mean Sheer **66.36**

Standard mean Sheer [Table, Para. 18] **40.95** Correction

Difference..... **25.41** ÷ 4 = **6.35**

§ If limited as Para. 18 (f) **-6 1/4**

CORRECTION FOR IRON DECK.

Proportion covered, if less than 1/10ths length covered **.777**

Thickness of usual wood deck, less stringer **3 1/2** inches

2 1/2" wood sheathing fitted -1"

Rise in Sheer from amidships { At front of bridge house.....
 [Para. 18 (e)] { At after end of forecastle

CORRECTION FOR ROUND OF BEAM.

Breadth at Gunwale amidships..... **46'0"**

Round of Beam **12"**

Normal round..... **11 1/2"**

Difference **1/2"** ÷ 2 = **1/4"**

Proportion of Deck uncovered (Para. 19)

appd. plan shows tumble home, but built without this.

¶ Fall in Sheer { Para. 18 (d) } ÷ 2 =

Length uncovered **Lowest point of sheer** Correction

Freeboard, Table A **5' - 3 1/2"**

Correction for Sheer **- 6 1/2"**

Correction for Length **+ 1 1/2"**

Allowance for Deck Erections **- 1' - 6 1/2"**

Correction for Round of Beam..... **3' - 3"**

Correction for fall in Sheer (if any).....

Correction for Iron Deck (if required) **- 1"**

Additions for non-compliance with provisions of Para. 11 (d) and (e) † }

Other Corrections (if any)

ALLOWANCE FOR DECK ERECTIONS:—

Freeboard, Table C..... **2' - 5"**

Correction for Length, if required (Para. 12, 13, and 14)

Freeboard by Table A. corrected for sheer, and for length, if required (Para. 12, 13, and 14) } **4' - 9 1/4"**

Difference **2' - 4 1/4"**

Percentage as below..... **66.55%** **2' - 6 1/4"**

18.8"

Winter Freeboard **3' - 5" 2"**

Summer Freeboard **2' - 10 1/4" 9/4"**

Indian Summer Freeboard **2' - 8 1/4" 4 1/2"**

N. A. Winter Freeboard **2"** **3' - 5" 4"**

Correction necessary because clearside amidships, measured in accordance with the Statute is not taken at the intersection of the wood and iron deck with side. **4 1/2" 1/4"**

1 1/2" above 2 1/2" wood deck at side

Winter Freeboard from deck line **3' - 4 1/2" 3 3/4"**

Summer " " " " **5' - 0" 2' - 11"**

Indian Summer " " " " **2' - 7 1/2" 6 1/4"**

N. A. Winter " " " " **3' - 6 1/2" 5 3/4"**

Correction for R. Q. Dk. if engine and boiler openings not covered by bridge house (Para. 11) }

Allowance for Deck Erections **- 1' - 6 3/4"** Table A **3 1/2"** C **5"**

	Length.	Length allowed.	Height.
Forecastle.....	40' - 1"	40' 08"	7' - 6"
Bridge House			
† Raised Qr. Dk.....			
Poop.....	200' 6"	200.50	7' - 9"
Total		240.58	
Length of Ship		309.50	
Corresponding percentage (Para. 11, 12, 13, or 14) }			.777
		66.55%	

FREEBOARD recommended amidships from centre of Disc to top of Statutory Deck Line, Wood (Iron) Deck:—

Fresh Water Line	above centre of Disc
Indian Summer Line	" " "
Winter Line	below " "
Winter North Atlantic Line	" " "

¶ If the frames, skin planking, or ceiling are of unusual thickness the breadth of vessel to inside of ceiling should be reported if possible.

† In vessels obtaining an allowance for deck erections under Para. 11 where the sheer drops abaft amidships the height of the R.Q.D. is to be taken from the level of the top of the amidship beam.

§ In flush-decked vessels the total standard mean sheer means the sheer measured at the stem and stern-post. In vessels having poops and forecastles, it means the sheer measured at points distant one eighth of the vessel's length from stem and stern-post.

12 FEB 1924

Walter Lang

RECEIVED 14 JUL 1924

Do all the Frames extend to the top height in the Poop? **Yes** / Raised Quarter Deck? **Combined Poop & Bridge.** / Bridge House? **Yes** / Forecastle? **Yes**
 To what height do the Reverse Frames extend? **Bulb angle frames**
 Has the Poop or Raised Quarter Deck an efficient Iron Bulkhead at the fore end? **Joined to bridge**
 Give particulars of the means for closing the openings in Bulkhead **-**
 Is the Poop or Raised Quarter Deck connected with the Bridge House? **Yes** / Has the Bridge House an efficient Bulkhead at the fore end? **Yes**
 Give particulars of the means for closing the openings in Bulkhead **2 steel hinged W.T. Doors 5'0" x 3'3" 18" Coaming**
 What is the thickness of the Bridge Front plating? **.36"** and Coaming plate? **.40"**
 Give scantlings and spacing of the Stiffeners **7 1/2" x 3 1/2" x .56"**
 Are bracket plates fitted at each end of the Stiffeners? **Yes** / Are hor'l. brackets fitted connecting Bridge Bulk'd. with Bulwarks? **Yes**
 Has the Bridge House an efficient Iron Bulkhead at the after end? **-**
 How are the openings closed? **-**
 Is the Forecastle at least as high as the main or top-gallant rail? **-** / Has the Forecastle an efficient Iron or Wood Bulk'd. at after end? **Yes**
 Are the Engine and Boiler openings covered by a Bridge, Poop, Raised Quarter Deck, or enclosed by a Strong Iron or Steel Deckhouse? **Yes**
 If the openings are not so protected are the exposed parts of the Casings efficiently constructed? **-**
 Give thickness of plating; scantlings and spacing of Stiffeners **-**
 What is the height of the exposed Casings? **-** / Are suitable means provided for closing all openings in them in bad weather? **-**
 Are the Weather Deck Hatchways efficiently constructed and at least equal to the requirements of Section 28 of the Rules for 1904-5? Give particulars below: **Yes**

Position and Size.		No.1 18'5"x 18'0"		No.2 24'6"x 18'0"		No.3 30'7"x 18'0"						
Item.		Ship.	Rule.	Ship.	Rule.	Ship.	Rule.	Ship.	Rule.	Ship.	Rule.	
COAMING	Height above top of DECK	2'-9"	2'-9"	2'-9"	2'-9"	2'-9"	2'-9"					
	Thickness	Sides.....	.44"	.44"	.44"	.44"	.44"	.44"				
		Ends.....	.44"	.44"	.44"	.44"	.44"	.44"				
SHIFTING BEAMS OR WEB PLATES	Number.....	3.		5.		6.						
	Section and Scantlings.....	Plate 16"x .36 angles 4"x3"x.44		plate 14"x .36" 4 angles as 4"x3"x.44		Plate 15"x .36" 4 angles as 4"x3"x.44						
	Material.....	Steel		Fitted Steel		Fitted Steel						
* FORE AND AFTERS.	Number.....											
	Section and Scantlings.....											
	Material.....											
HATCHES	Thickness.....	2 1/2"	2 1/2"	2 1/2"	2 1/2"	2 1/2"	2 1/2"					
	Remarks.....	Good		Good		Good						

* The depth of Fore and Afters should be stated from the underside of the hatches in all cases.

(If the sill of the lowest side scuttle will be less than 6 inches above the Indian Summer Load Line if assigned under the tables, state vertical distance from top of deck at side amidships to lower edge of lowest side scuttle.)

The following information is to be given in all Cases of vessels dealt with under Paras. 11, 12 (under 15 feet Moulded depth) and under Shelter Deck Rules.

What is the thickness of the Bridge Sheerstrake? **.56"** / Strake between Main and Bridge Sheerstrakes? **.56"**

Delete the words **{** The Crew ~~are~~, are not, berthed in the bridge house. **in forecandle.**
 that do not apply **{** The arrangements to enable them to get backwards and forwards from their quarters ~~are~~, ~~are~~ satisfactory.

Length of Bulwarks in well **71.5' 68.92'**

Area of Freeing Ports required by Para. 11 (e) each side of vessel = **14.3 13.78** Sq. ft.

12.3 x .5 = 6.15



12.0 x .5 = 6.00

11.25 x .5 = 5.625

17.775

Ft. Tenths. Ft. Tenths. No. } Freeing Ports (each side of vessel) = **17.77** Sq. ft.

Total deficiency or excess = **3.4 3.99** Sq. ft.

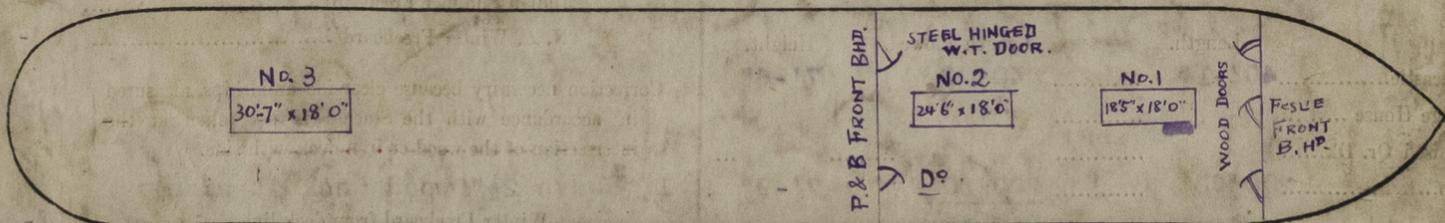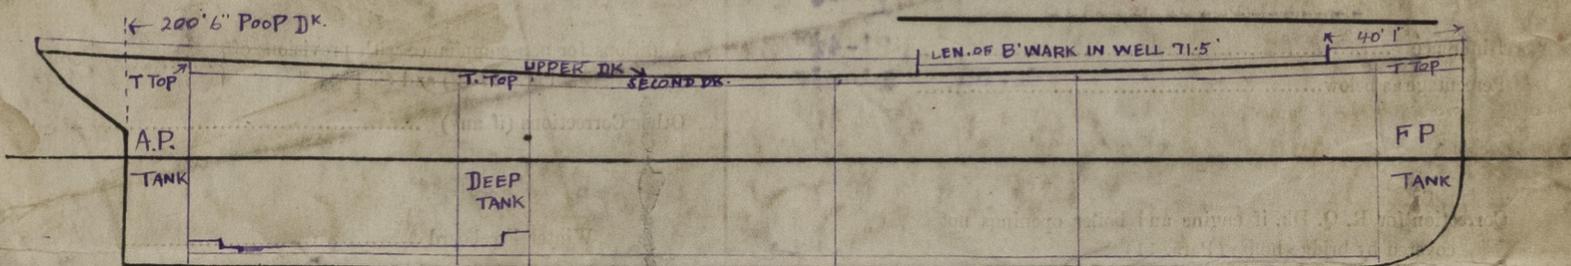

Show hereon line of Floors or Tank Top with position of any Breaks in same; also height of Peak Tank tops, &c., &c.

Sister Vessel S.S. "Sun Sang" HK. R.W. B. Co. No. 593.

State any special features in the construction of the Vessel **Well deck vessel. Poop & Bridge joined.**

Preliminary Freeboard from London, dated 29/9/22. Plans in London Office.

Builders & Yard No. **The Hongkong & Whampoa Dock Co. Ltd. No. 594.**

Owners **Messrs The Indo-China Steam Navigation Co. Ltd.**

Address

Fee £ 16. : 0 : 0.

Received by me *See SB. Rpt.*



© 2021 Lloyd's Register Foundation