

12/7/20



CARGO STEAMER N°591.

PROFILE & DECK PLANS.


DIMENSIONS 299'-6" B.P. x 39'-0" x 15'-0" MOULDED.

SCALE 1/8 INCH = ONE FOOT.


CLASS A1 CHANNEL SERVICE WITH FREEBOARD
IRISH CHANNEL.

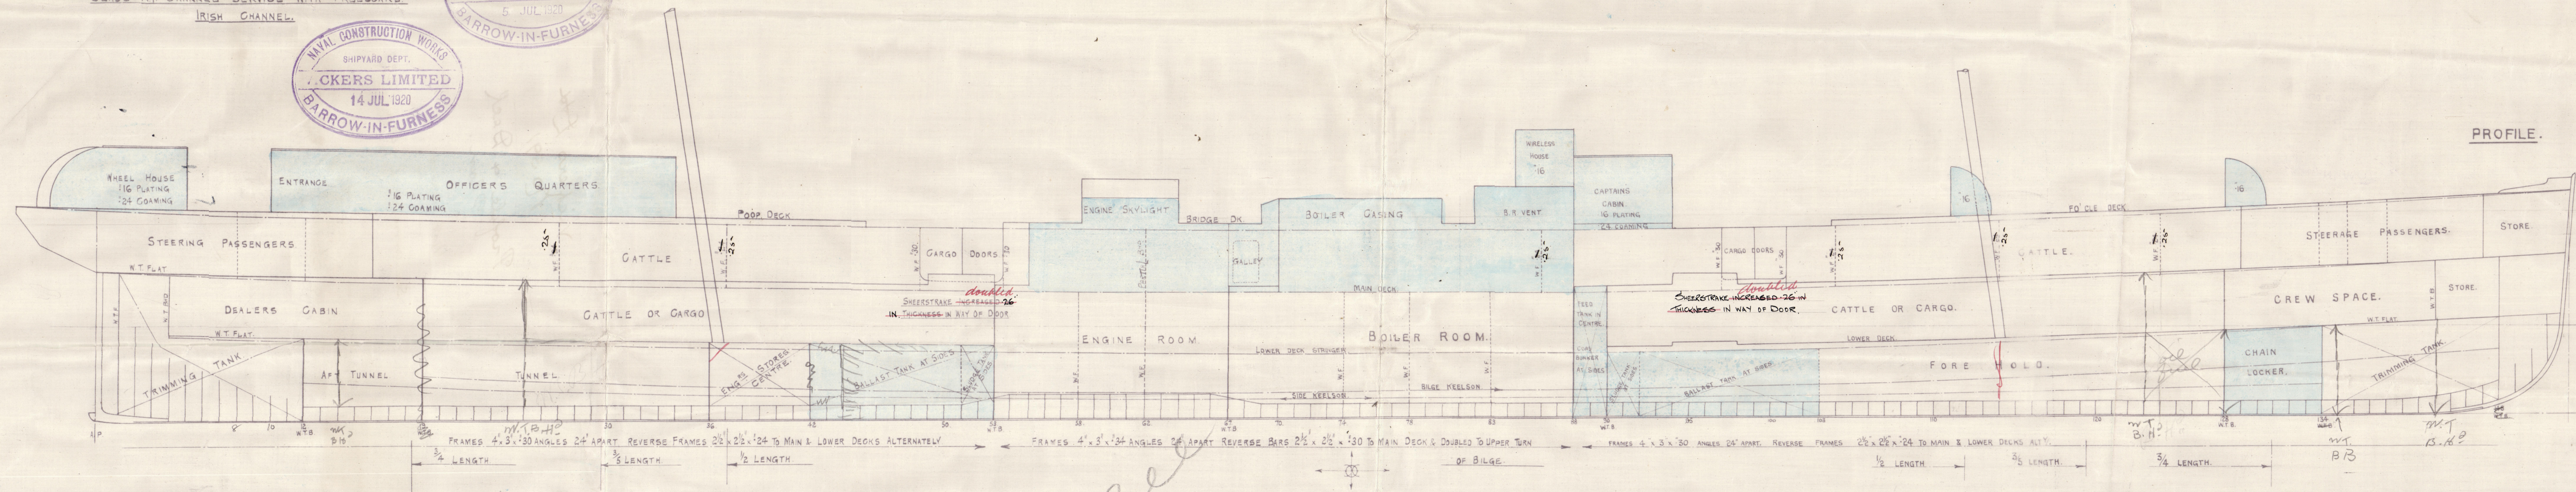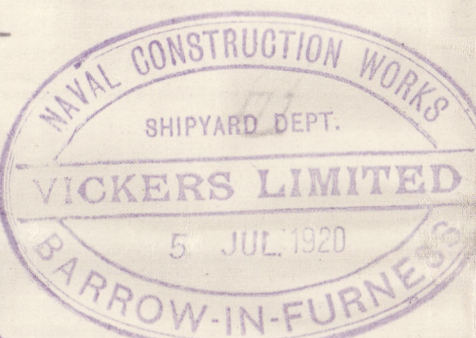


PROFILE.

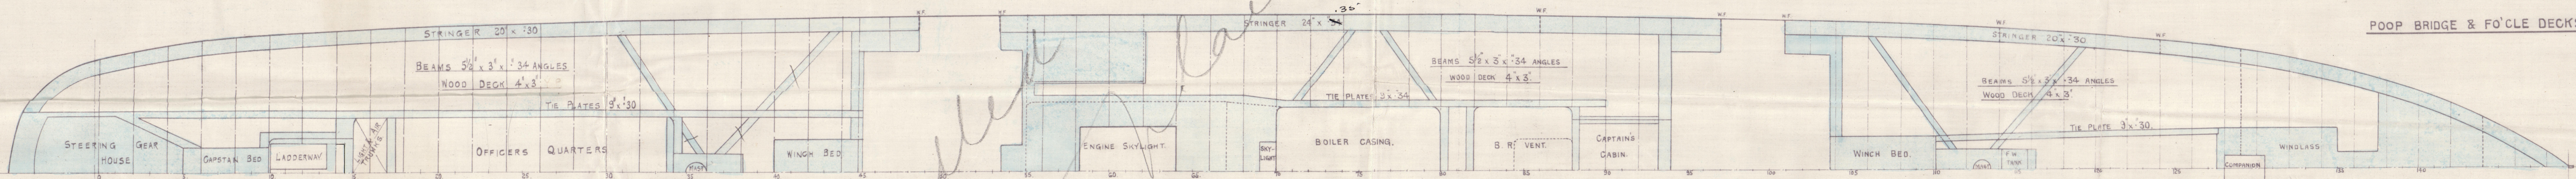

POOP BRIDGE & FO'CLE DECKS.

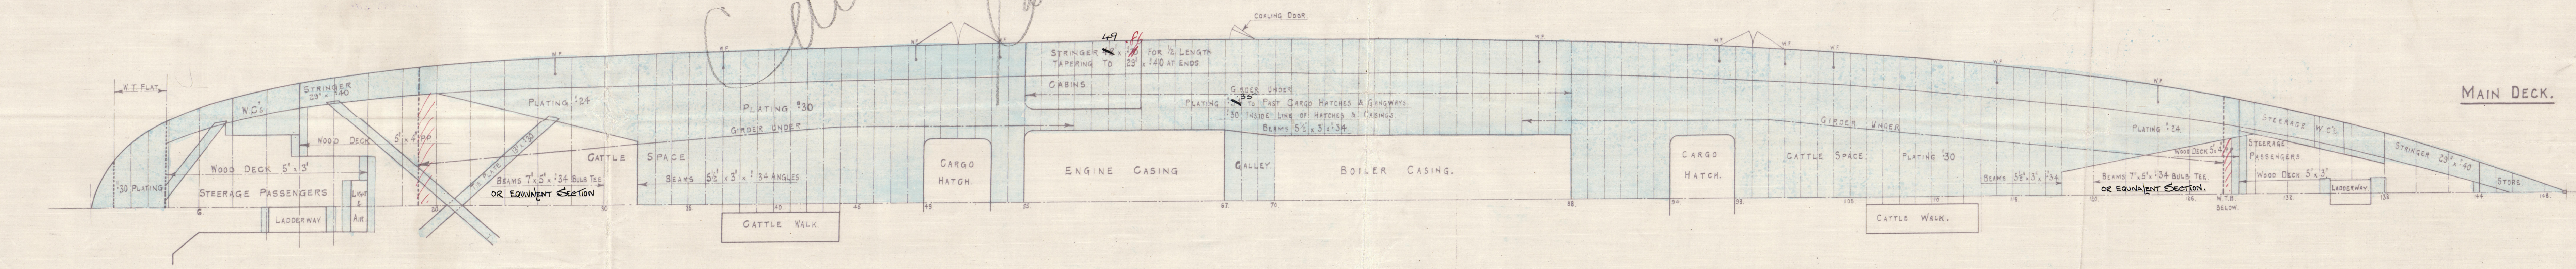

MAIN DECK.

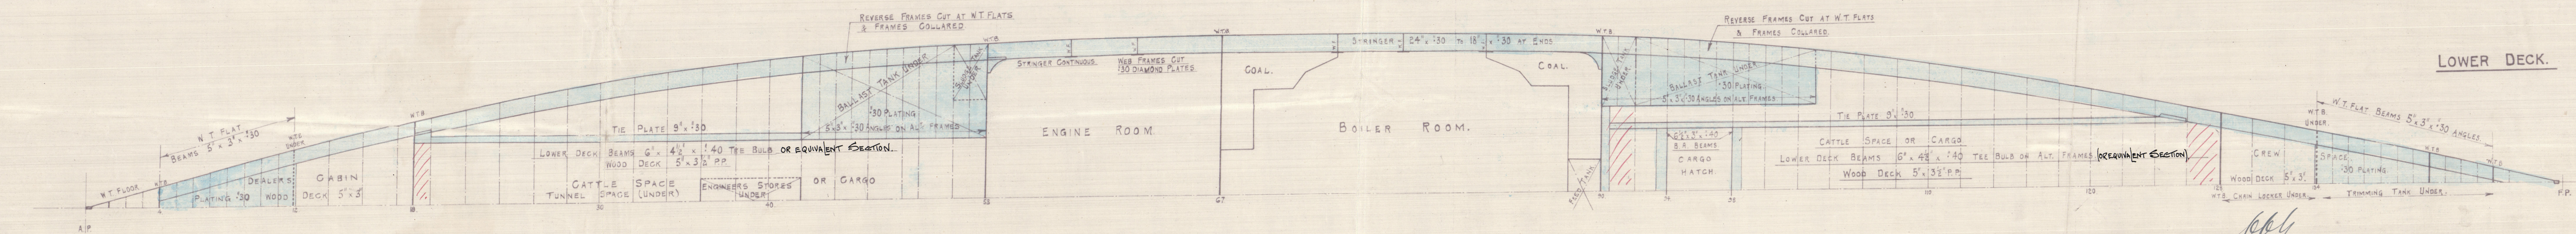

LOWER DECK.

10.7.20.

(2)
Vickers Ltd
No 591


Profile & Deck
Plan.

Not correct.

See amended Plan - No 9

Bru 1st Entry Rpt 1934

Stevie Donard

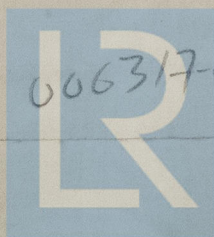

© 2020

006317-006331-0012

Lloyd's Register
Foundation