

11 MAY 1939

YARD NO 51

PROPOSED TWIN SCREW STEEL PASSENGER FERRYBOAT FOR THE TYNE IMPROVEMENT COMMISSION

DIMENSIONS


LENGTH OVERALL	=	80'-0"
LENGTH B.P	=	77'-0"
BREADTH MLD	=	18'-0"
DEPTH MLD	=	9'-8"

SCALE $\frac{3}{4}$ " = 1 FOOT

To CLASS LLOYDS 100A WITH FREEBOARD FOR RIVER SERVICES AND TO REQUIREMENTS OF
BOARD OF TRADE FOR A PASSENGER FERRYBOAT OPERATING ON RIVER TYNE. (STEAM 5. CERTIFICATE FOR 270 PASSENGERS.)

LLOYDS NUMERALS

D = 9.66
L x D = 77 x 9.66 = 743.82
L x (B + D) = 77 x (18 + 9.66) = 2129.82
L = 77 = 7.97
D = 9.66
d = 8.66

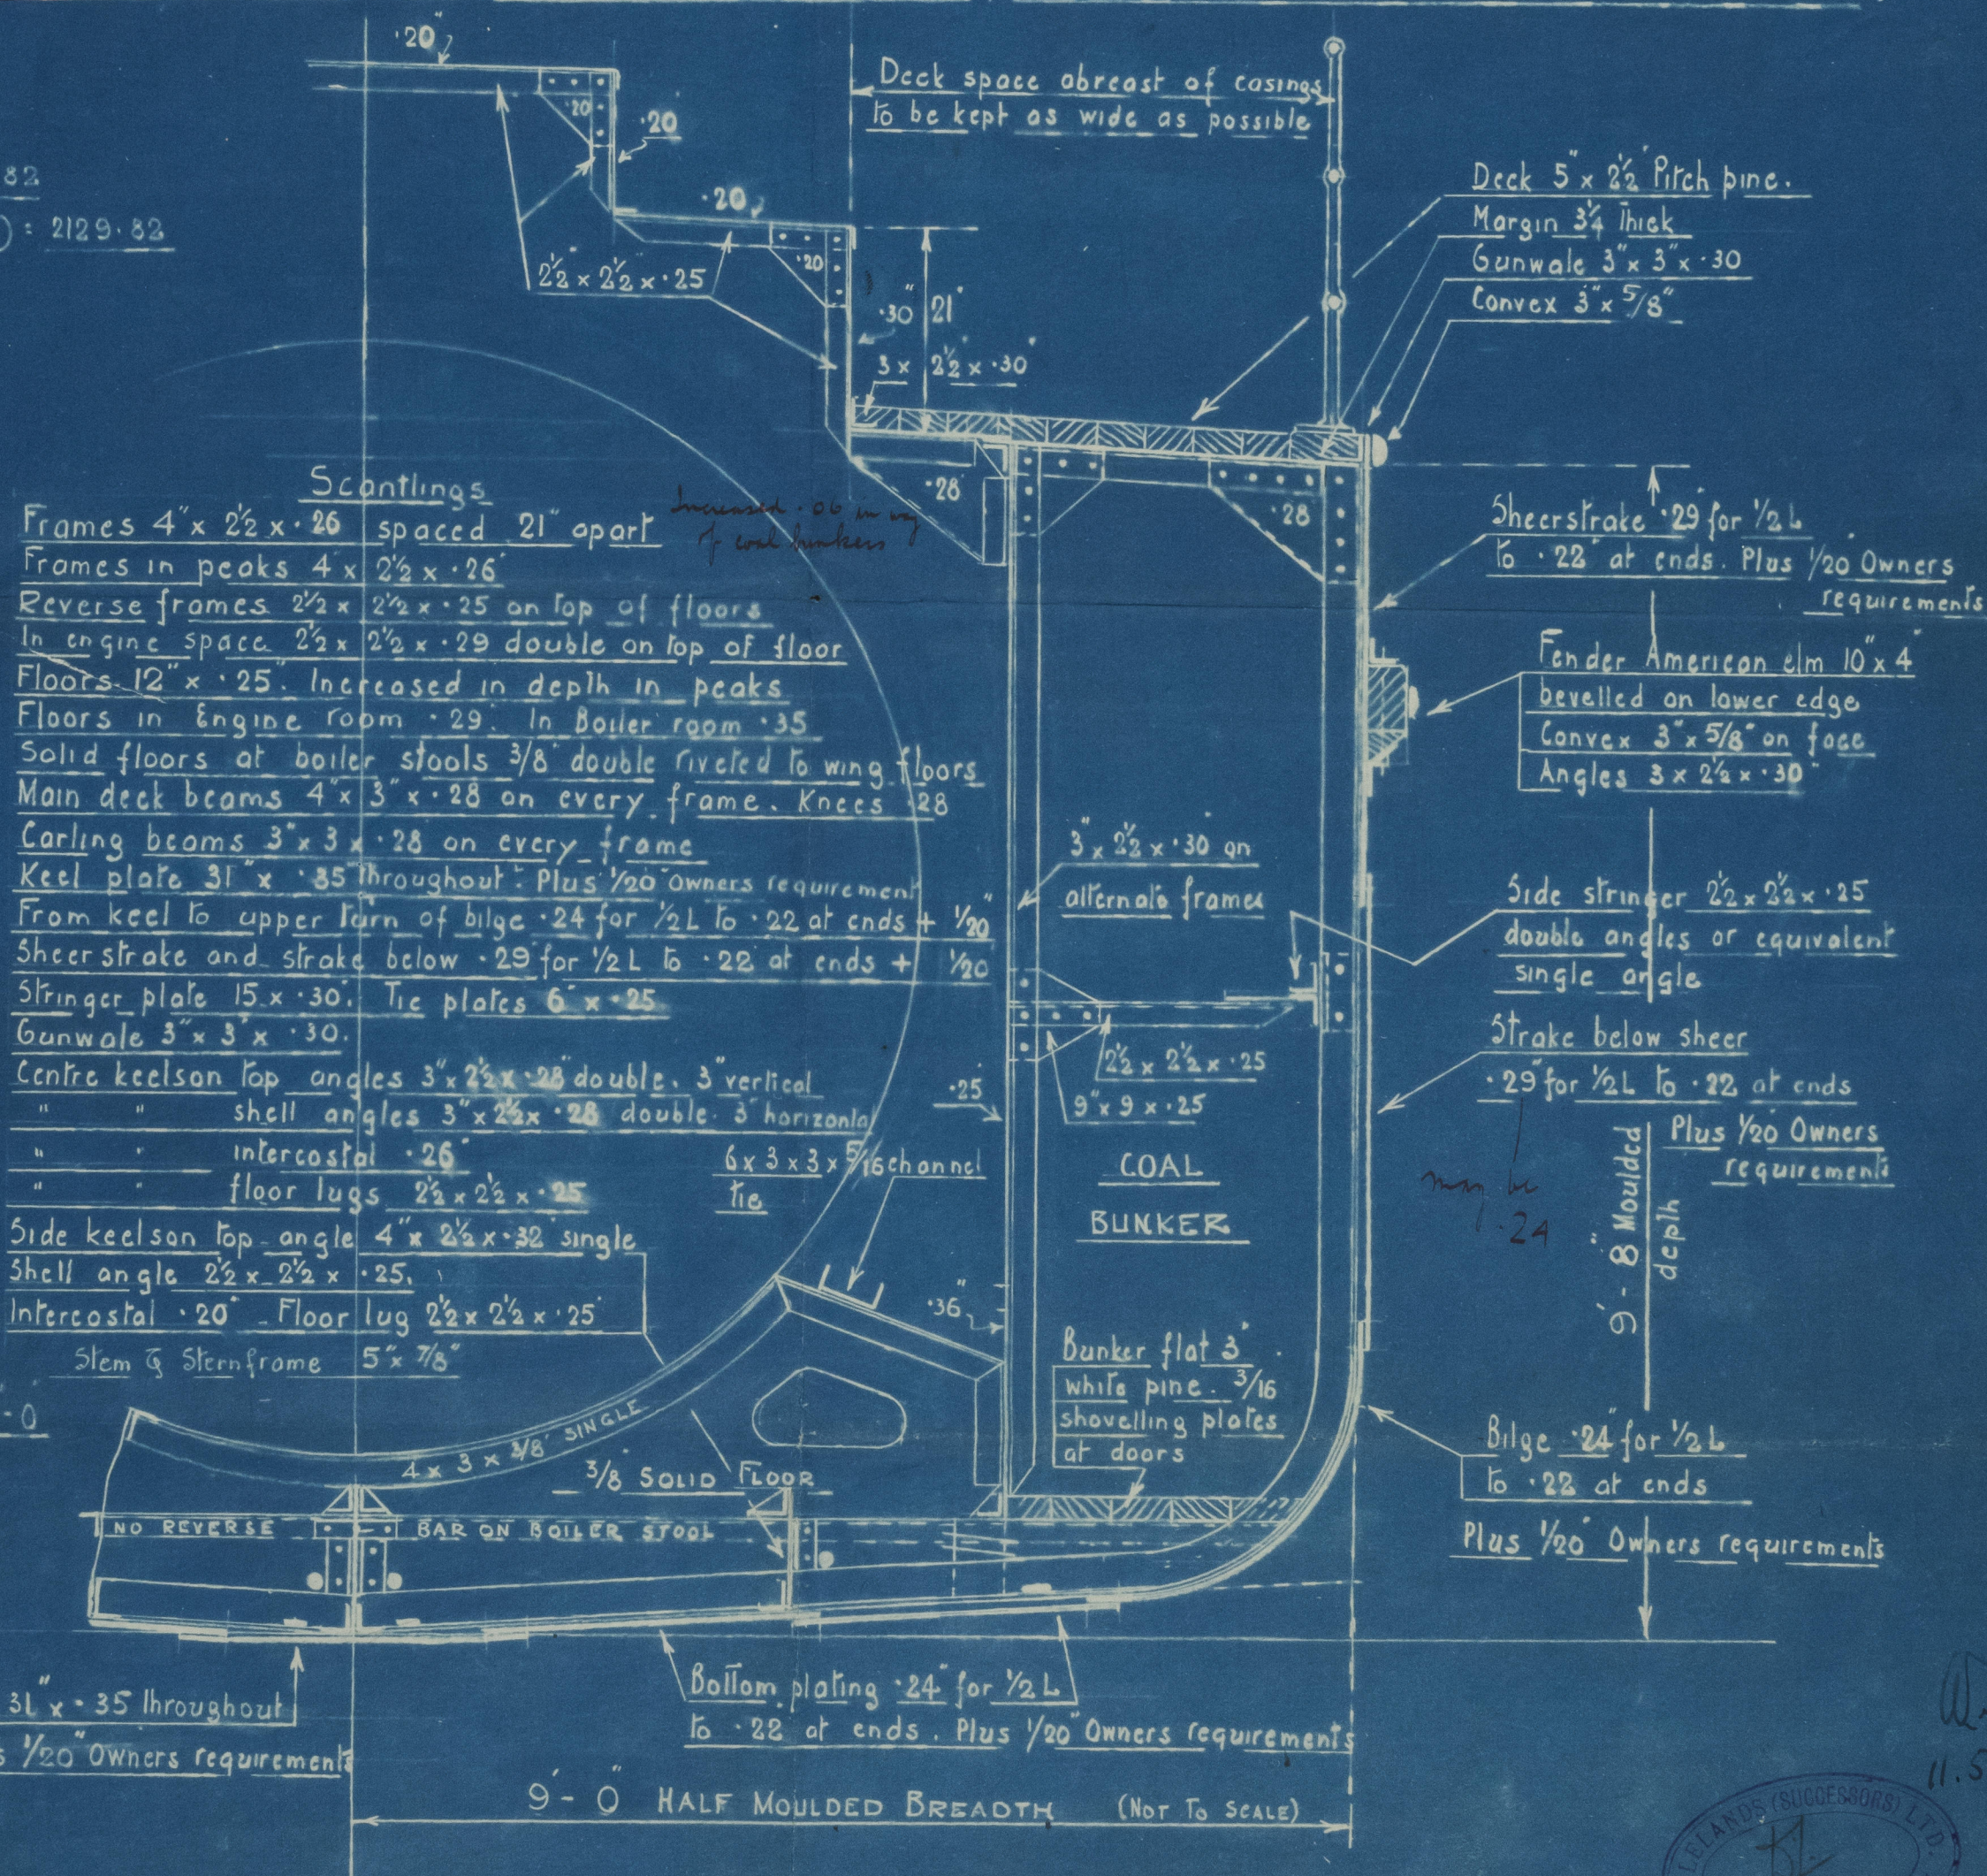

NOTE. BOILER 10'-0" x 10'-0"
NOT TO SCALE

PLAN NO. 3626

PRINT NO. 12638

CLELANDS (SUCCESSORS) LTD.

WILLINGTON-QUAY-ON-TYNE



4/5/39



Lloyd's Register
000407-006411-0031

Nº 51

MIDSHIP SECTION

CLELAND'S

A. S. S. Hollingwood

NEWCASTLE ON TYNE.

Report No. 98510.



© 2020

Lloyd's Register
Foundation

006407-006411-0031

CLELANDS 51

MIDSHIP SECTION.

LOYDS • APPROVED.



© 2020

Lloyd's Register
Foundation