


24/12/18

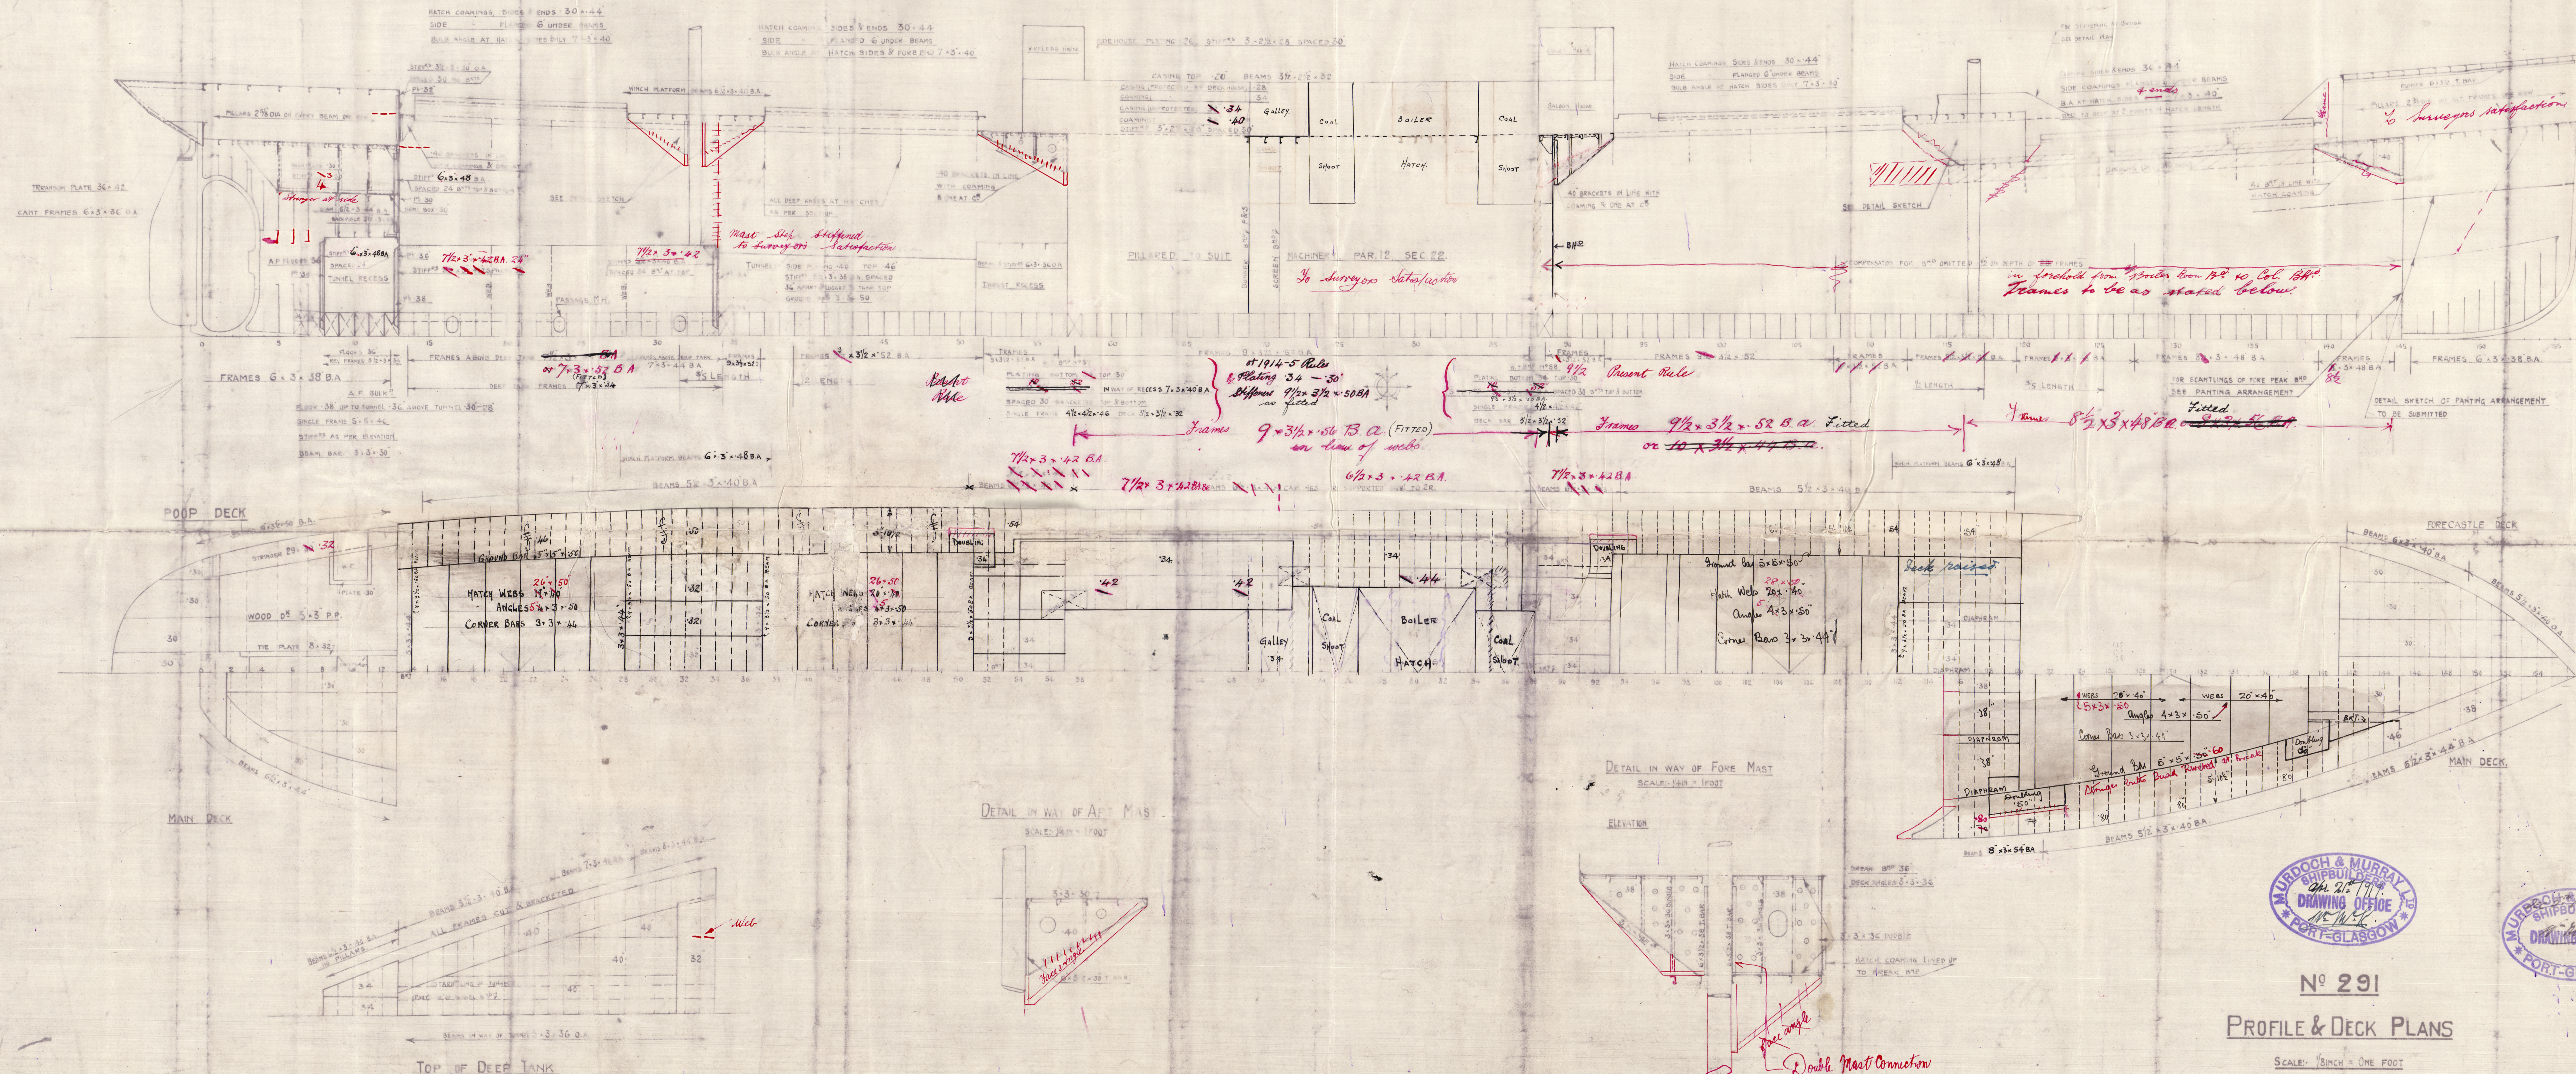



No 291  
PROFILE & DECK PLANS

SCALE: 1/8" = 1 FOOT  
TO CLASS LLOYDS + 100 A.I.  
SCANTLING TO BE THE MINIMUM TO OBTAIN THE CLASS  
DIMENSIONS: 314' 0" B.P. x 44' 0" M.D. x 20' 0" M.W. 25' 0" M.D. TO QUARTER DECK

Murdock & Murray Ltd  
No 291.

Profile & Decks  
(as fitted).

S. S. "Moto"  
Grk Rep No 17635.

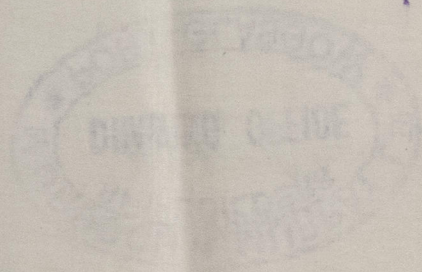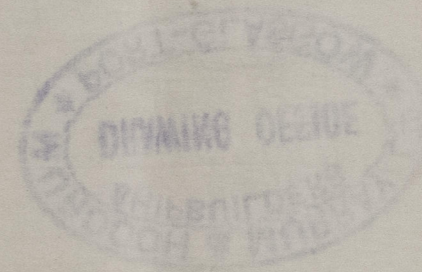

006601-006613-0225



© 2021

Lloyd's Register  
Foundation