

Set 43 to be
compared with

14.7.19



On account of reduced radius of quadrant
the diameter of chains & rods should be
increased accordingly (Table 25 footnote)

NEW CARGO-STEAMER No 141

STEM, STERNPOST AND RUDDER.

SCALE 1:10 n. 1:20

Under 12 knots

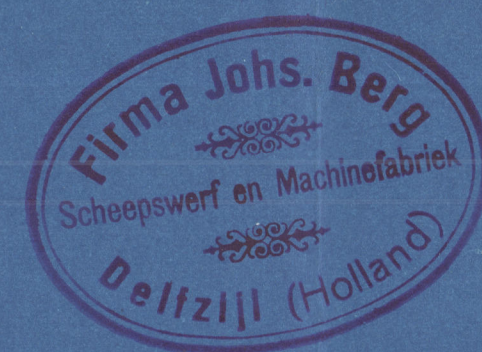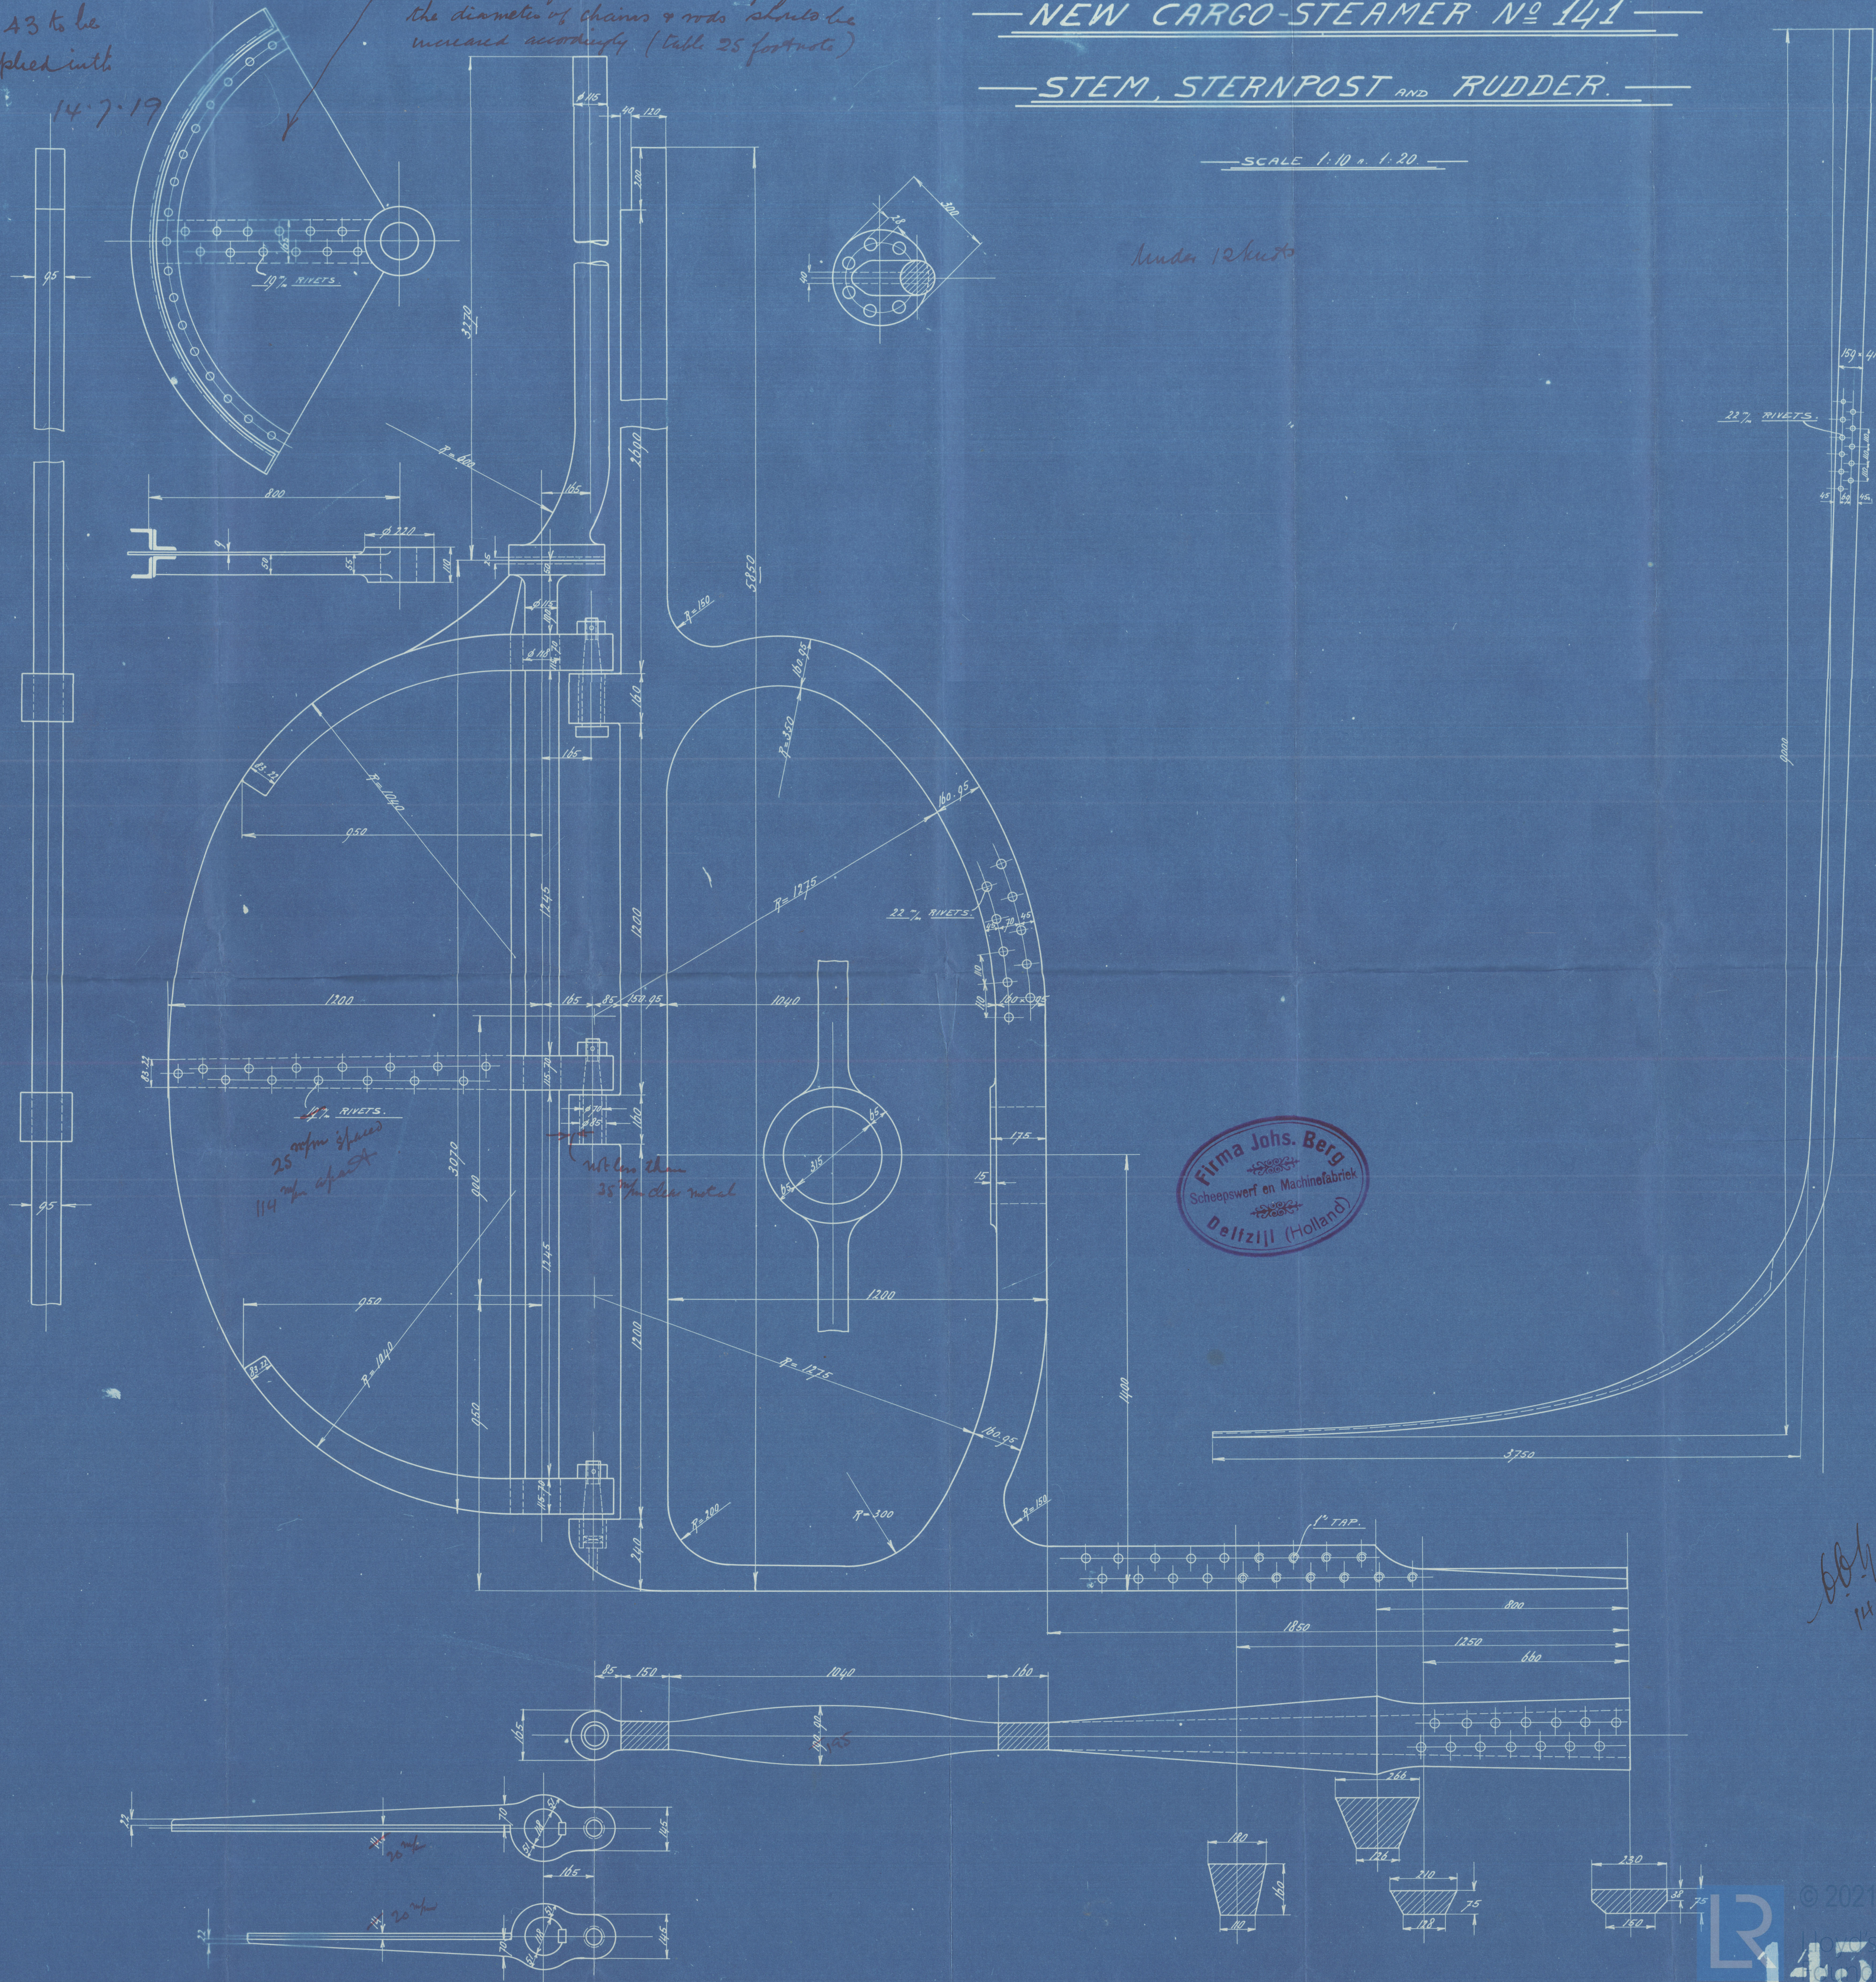

14.7.19

plan n^o 6

Johs Berg
Delfzijl

S.S. n^o 141.

Sternframe, radeler and stem



S.S. "Aepacio"

Ams Rpt no. 8067.



© 2021

Lloyd's Register
Foundation

006705-006722-0112