



STEEL BULK UP

Surgeon Col.

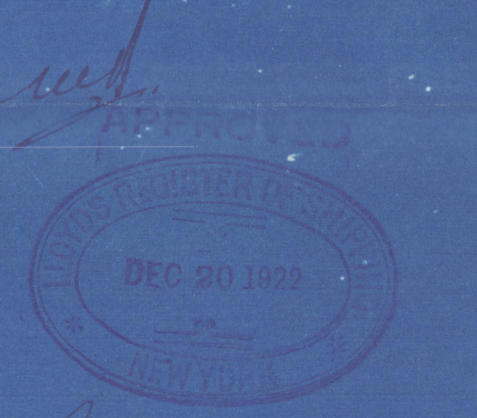

French

PROFILE ARRANGEMENT
PROPOSED C.P.R. MOTOR FERRY
SCALE 1" = ONE FOOT
YARROWS LIMITED ESQUIMALT, B.C.

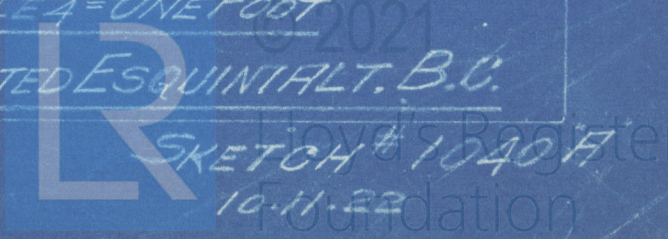

GORE'S
ELECTRIC BLUE PRINT CO.
DRAWING MATERIALS, MEASURING TAPES,
SURVEYING INSTRUMENTS, ETC.,
214 CENTRAL BLDG. 620 VIEW STREET
VICTORIA, B. C.

*Pacific Management
Favour No 555*

006905-006922-0291

10.11.22



© 2021

Lloyd's Register
Foundation