


23. 4. 14
14. 5. 14

CLASSE: A₁-4-G.L.I.I DEL VERITAS AUSTRO-UNGARICO
RISPETT: +100 A₁ DEL LLOYD REGISTER
SERVIZIO NELL'ADRIATICO

SCALA 1:80

SEZIONE LONGITUDINALE

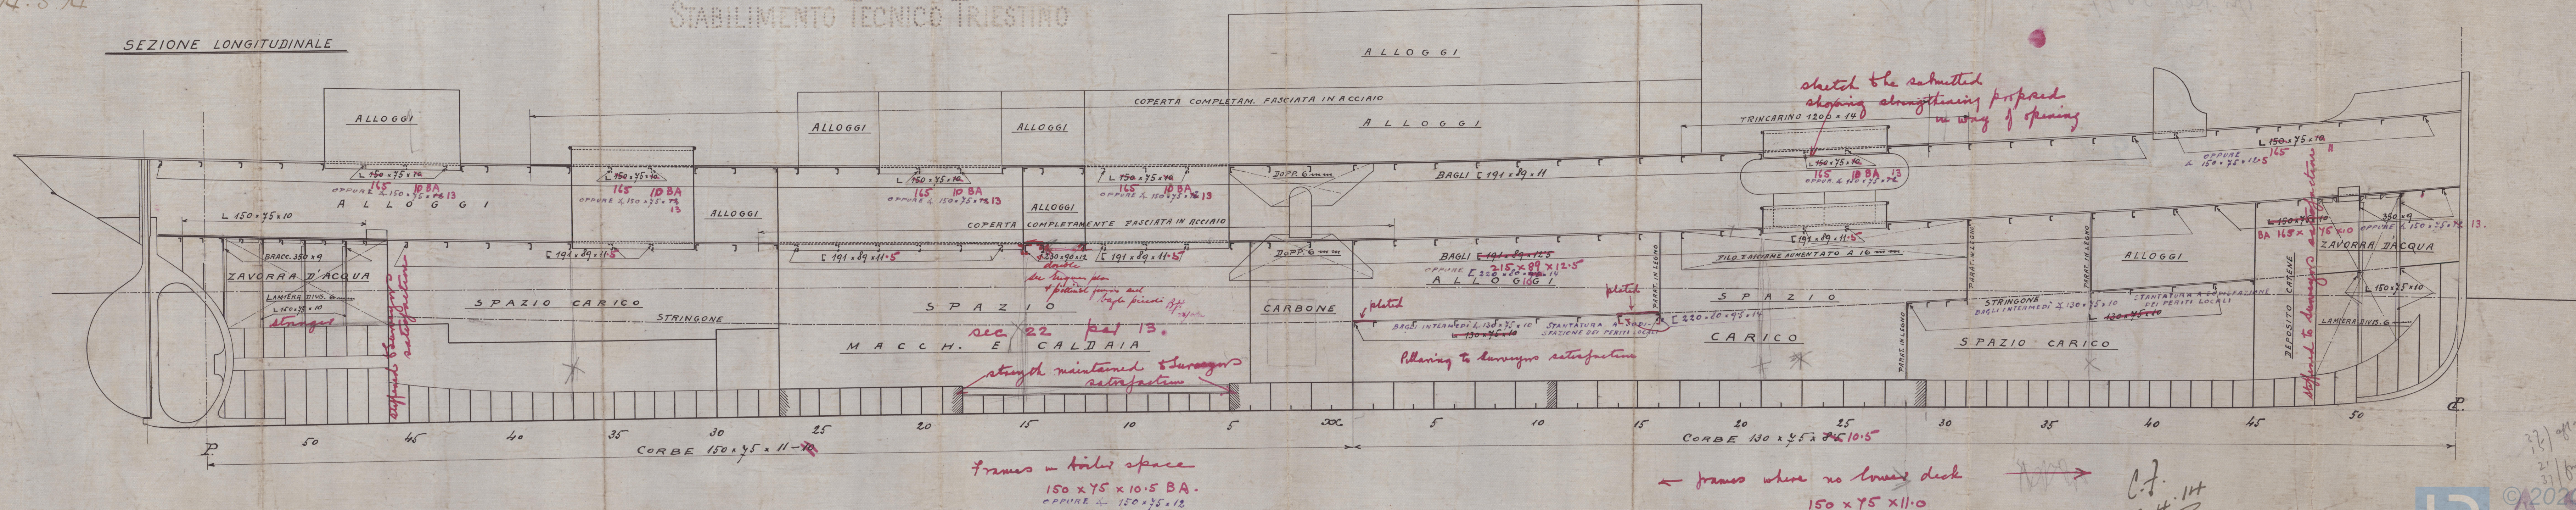

Deck plans to be submitted

sketch the submitted
shaping along the way proposed
RING 1200 x 14 in way of opening

| DEPOSITO | CATENE |
|----------|--------|
| 150 x 75 | 169 x |

5


Stopped to Sunmays on Jackson

S. MARCO 10 APRILE 1914



© 2020
A2
Lloyd's Register
Foundation

006723-006730-0071

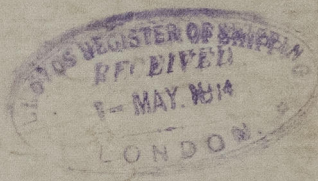

L.T.T. 520

Sh^r Duino—

Tr. Rep. 5897

59. B.

4



© 2020

Lloyd's Register
Foundation

006723-006730-0071