

Nº 273

STERNPOST & RUDDER

Scale 1" = 3" = 1 FOOT.

DIMENSIONS 186'0" x 35'0" x 14 1/2" MLD

SPEED 10 KNOTS.

BEST FORGED STEEL TO LLOYDS REQUIREMENTS & TESTS

AREA OF RUDDER 34.6 sq. ft.

C.G. OF RUDDER ABAFT 2' OFF PINTLES

AxD. 34.6 x 2.4 = 83.



HR/ 273 7

APPROVED
LLOYD'S REGISTER OF SHIPBUILDING

14/3/38
Foundation

Harry Rogers 2^d
N^o 273

Stern post & Ruddeer


Train M.V. "PURIRI"

Luth Rpt N^o 19729



© 2020

Lloyd's Register
Foundation

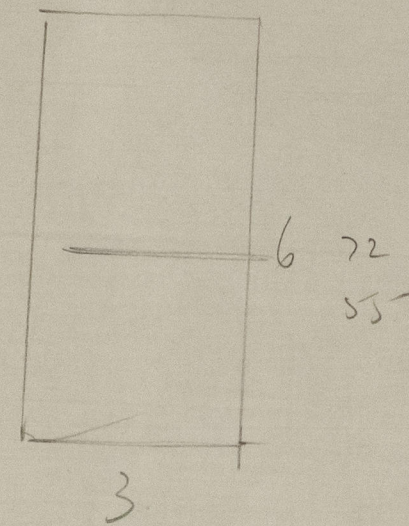

© 2020

Lloyd's Register
Foundation