


# NUMERALS

L x D = 1771. L(B+D) = 6083  
 D = 13.30 D = 11.5  
 d = 10.33

EQUIPMENT NO 6514  
 5335

- 2 STOCKLESS BOWER ANCHORS 10 1/4 CWTs EACH.
- 75 " 2 1/2" STEEL WIRE TOWLINE.
- 90 " 5 1/2" HEMP HAWSER.

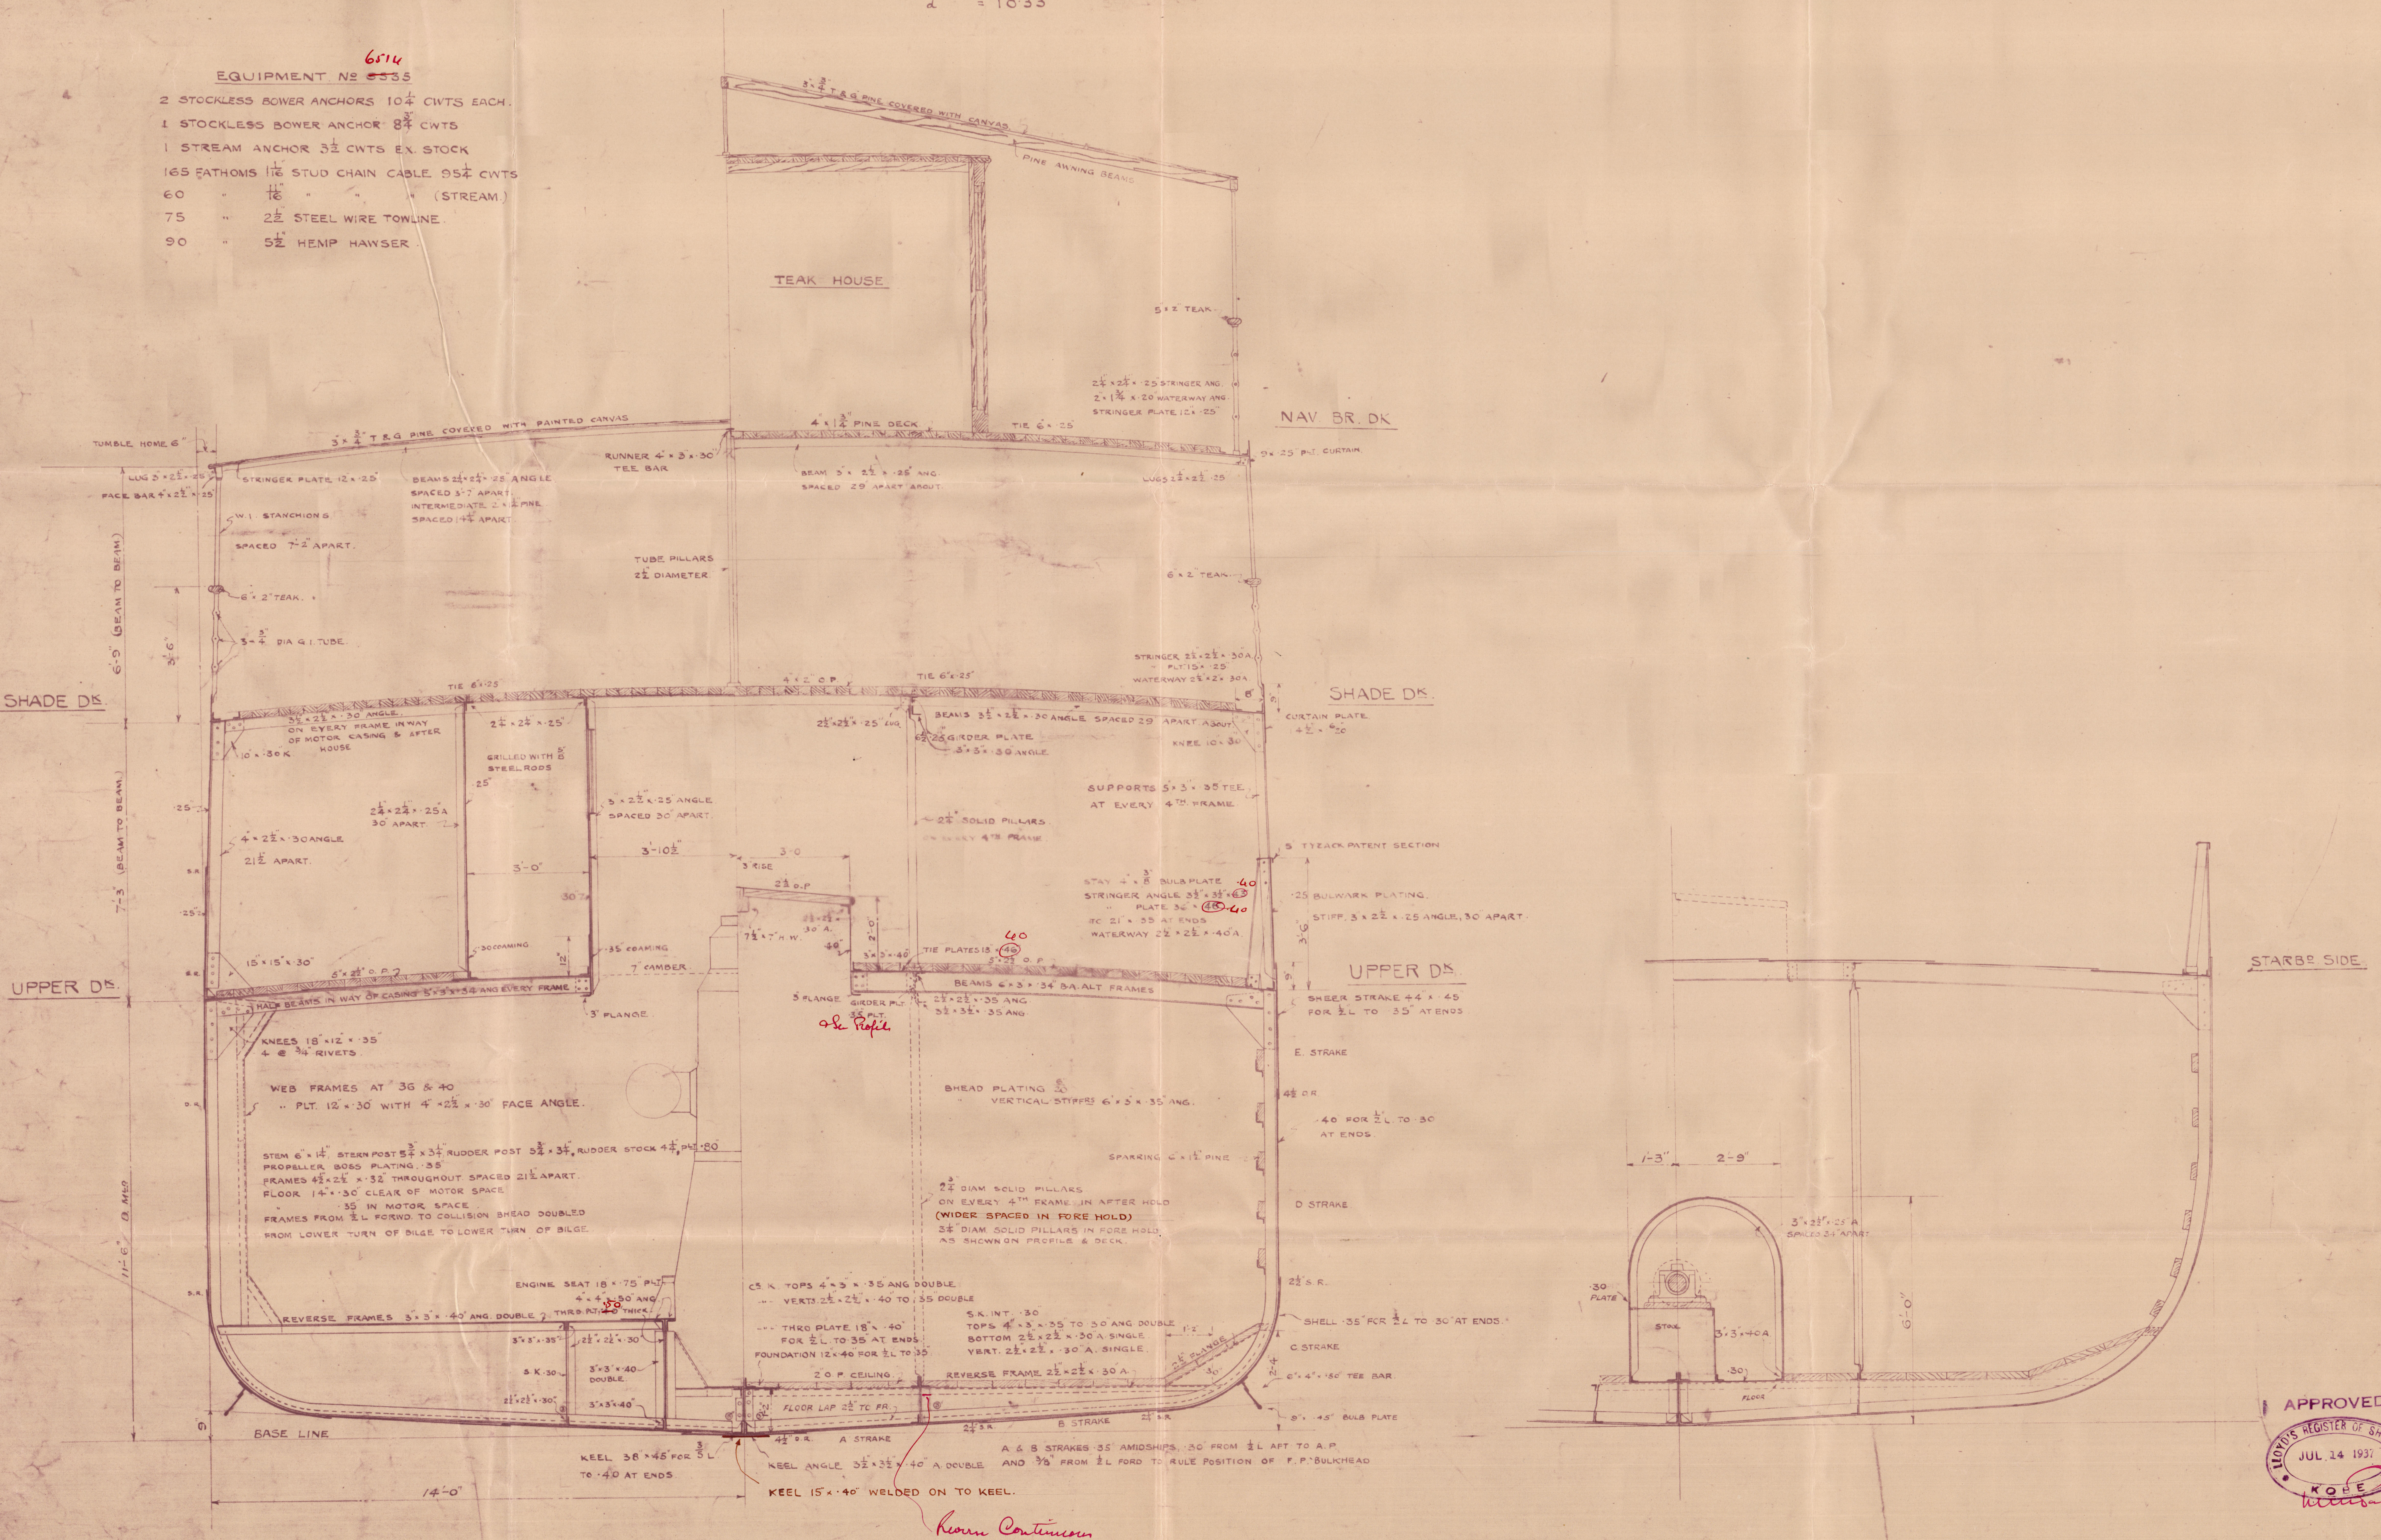


**NO 292 SHIP.**  
**MIDSHIP SECTION.**

**DIMENSIONS:- 154'-0" B.P. x 28'-0" x 11'-6" MLD**

**SCALE 1/2" = ONE FOOT.**

**SECTION THRO TUNNEL**

**LOOKING FORWARD**

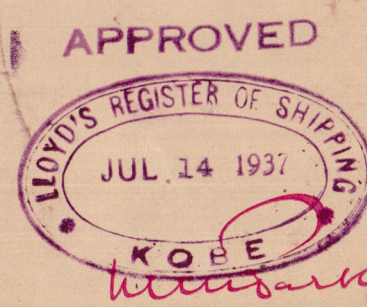

DRAWN BY *W. S. Bailey*  
 TRACED BY  
 CHECKED BY **AAD.**  
 DATE **29-6-37.**



0067471-0067474-0001



//

"antonia"

292  
Mud Sec.

W.S. Bailey's Yard no 292  
Plan of midship Section

GEN BOX NO 357



© 2021

Lloyd's Register  
Foundation

006749-006759-0001