

MIDSHIP SECTION OF STANDARD STEAMER.

PRINCIPAL DIMENSIONS 331'-0" B.P. x 46'-6" MLD x 25'-6" MLD.

SCALE $\frac{1}{2}$ " = 1 FOOT.
CLASS 100.A.I. LLOYDS.

	POOP.	FOLE.
SIDE PLATING	36"	38"
STRINGER P.T.	32" x 32"	32" x 32"
" ANGLE	3" x 3" x 32"	3" x 3" x 32"
DECK PLATING	25"	25" x 30"
BEAMS	8" x 3" x 38 B.A.	9" x 3" x 42 B.A.
BEAM KNEES	20" x 40"	20" x 40"
PILLARS	2 1/4"	2 1/4"

LIST OF SECTIONS TO BE USED IN BUILDING VESSEL.

3" x 3 1/2" BULB ANGLE	✓
8" x 3"	✓
6" x 3 1/2" ANGLE	✓
6" x 6"	✓
3 1/2" x 3 1/2"	✓
3" x 3"	✓

LLOYDS NUMERALS.

MOULDED BREADTH (B)	= 46.5
" DEPTH (D)	= 25.5
B + D	= 72.0 = 1 ST NO.
LENGTH (L)	= 331
L x (B + D)	= 23832 = 2 ND NO.

LENGTHS TO DEPTH U.D.	= 12.98
WITH INCREASED BRACKETS	= 20.70

SHEER FORW. 8'-6"	1/8 LEN FORW. = 4'-8"
SHEER AFT 4'-3"	1/8 LEN AFT = 2'-4"


EQUIPMENT NUMERAL.

L x (B + D)	= 331 x (46.5 + 25.5) = 23832.00
ERECTOR'S	
BRIDGE	= 38.00
FORW.	= 32.66
POOP	= 26.49
157 4.5 x 4.5 x 3/4	= 885.66

CASINGS & HOUSES	= 243.12
EQUIPMENT NO.	= 24961.08

EQUIPMENT.

2 BOWER ANCHORS STOCKLESS 45 CWT.	✓
1	38
1 STREAM ANCHOR EX STOCK 12	✓
1 KEDGE	3 1/2
210 FMS 1 1/4" STUD CHAIN CABLE	✓
90 FMS 1/2" STUD CHAIN CABLE	✓
100 FMS 1/2" STUD CHAIN CABLE	✓
4 STEEL WIRE STREAM	✓
1-90 FMS 7" HAWSER 4-180 FMS 2 1/2" STEEL WIRE	✓
1-90 FMS 6" HAWSER 4-180 FMS 2 1/2" STEEL WIRE	✓
2 1/2" x 1/2" x 1/2" x 1/2"	✓

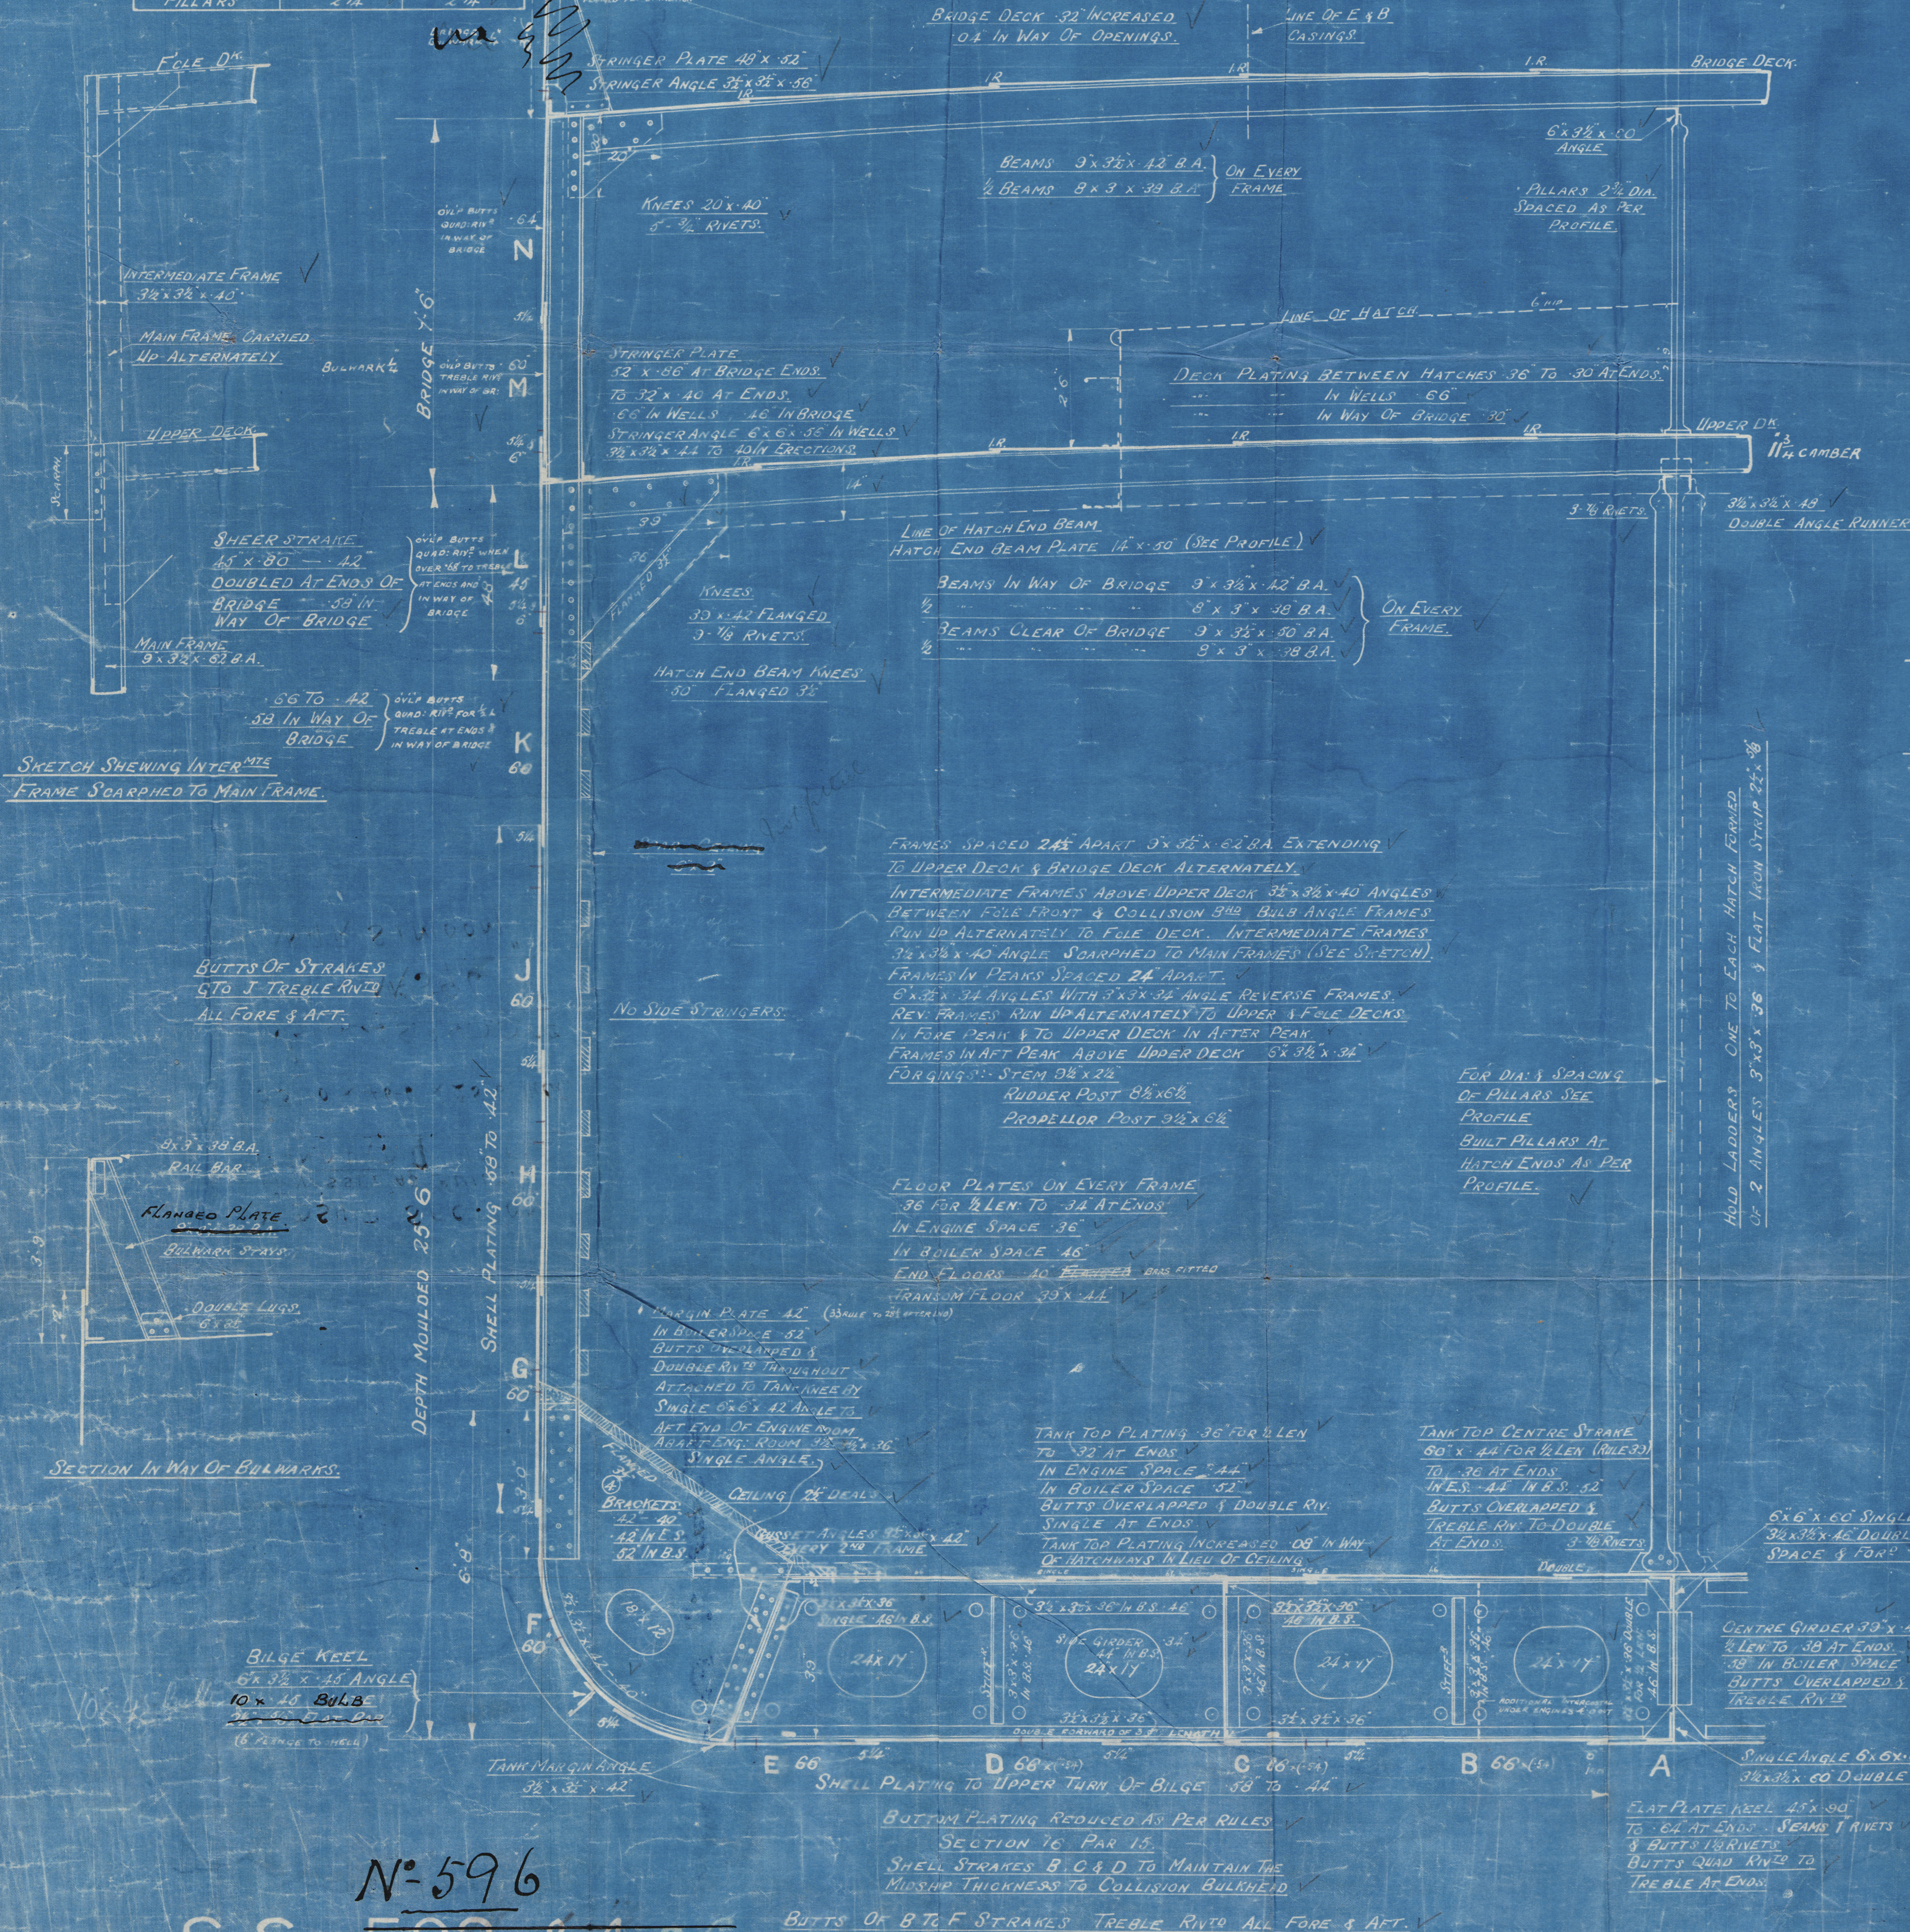

N°-596

S.S. 592.84.26

IRVINE'S
SHIP BUILDING
AND
DRY DOCKS CO LTD
WEST HARTLEPOOL

596

R

Lloyd's Register

06744-006759-00123

MIDSHIP SECTION.
OF VESSEL AS BUILT.
STANDARD C TYPE.


331'-0" x 46'-6" x 25'-6" Incl.

Irvine's S.B. & D.D. CO.

S.S. N° 596

"WAR SIMOOM"

Report N° 15558

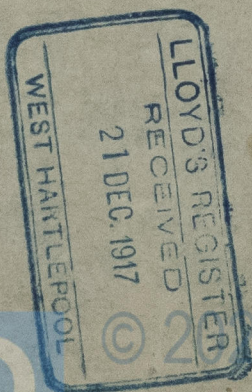

Lloyd's Register
Foundation

006749-006759-0128