


DIMENSIONS:
LENGTH O.A. 297'-3"
LENGTH B.P. 284'-3"
BEAM 42'-0"
DEPTH 21'-2½"
LOAD DRAFT 20'-3½"
DISPLACEMENT 5000 TONS.

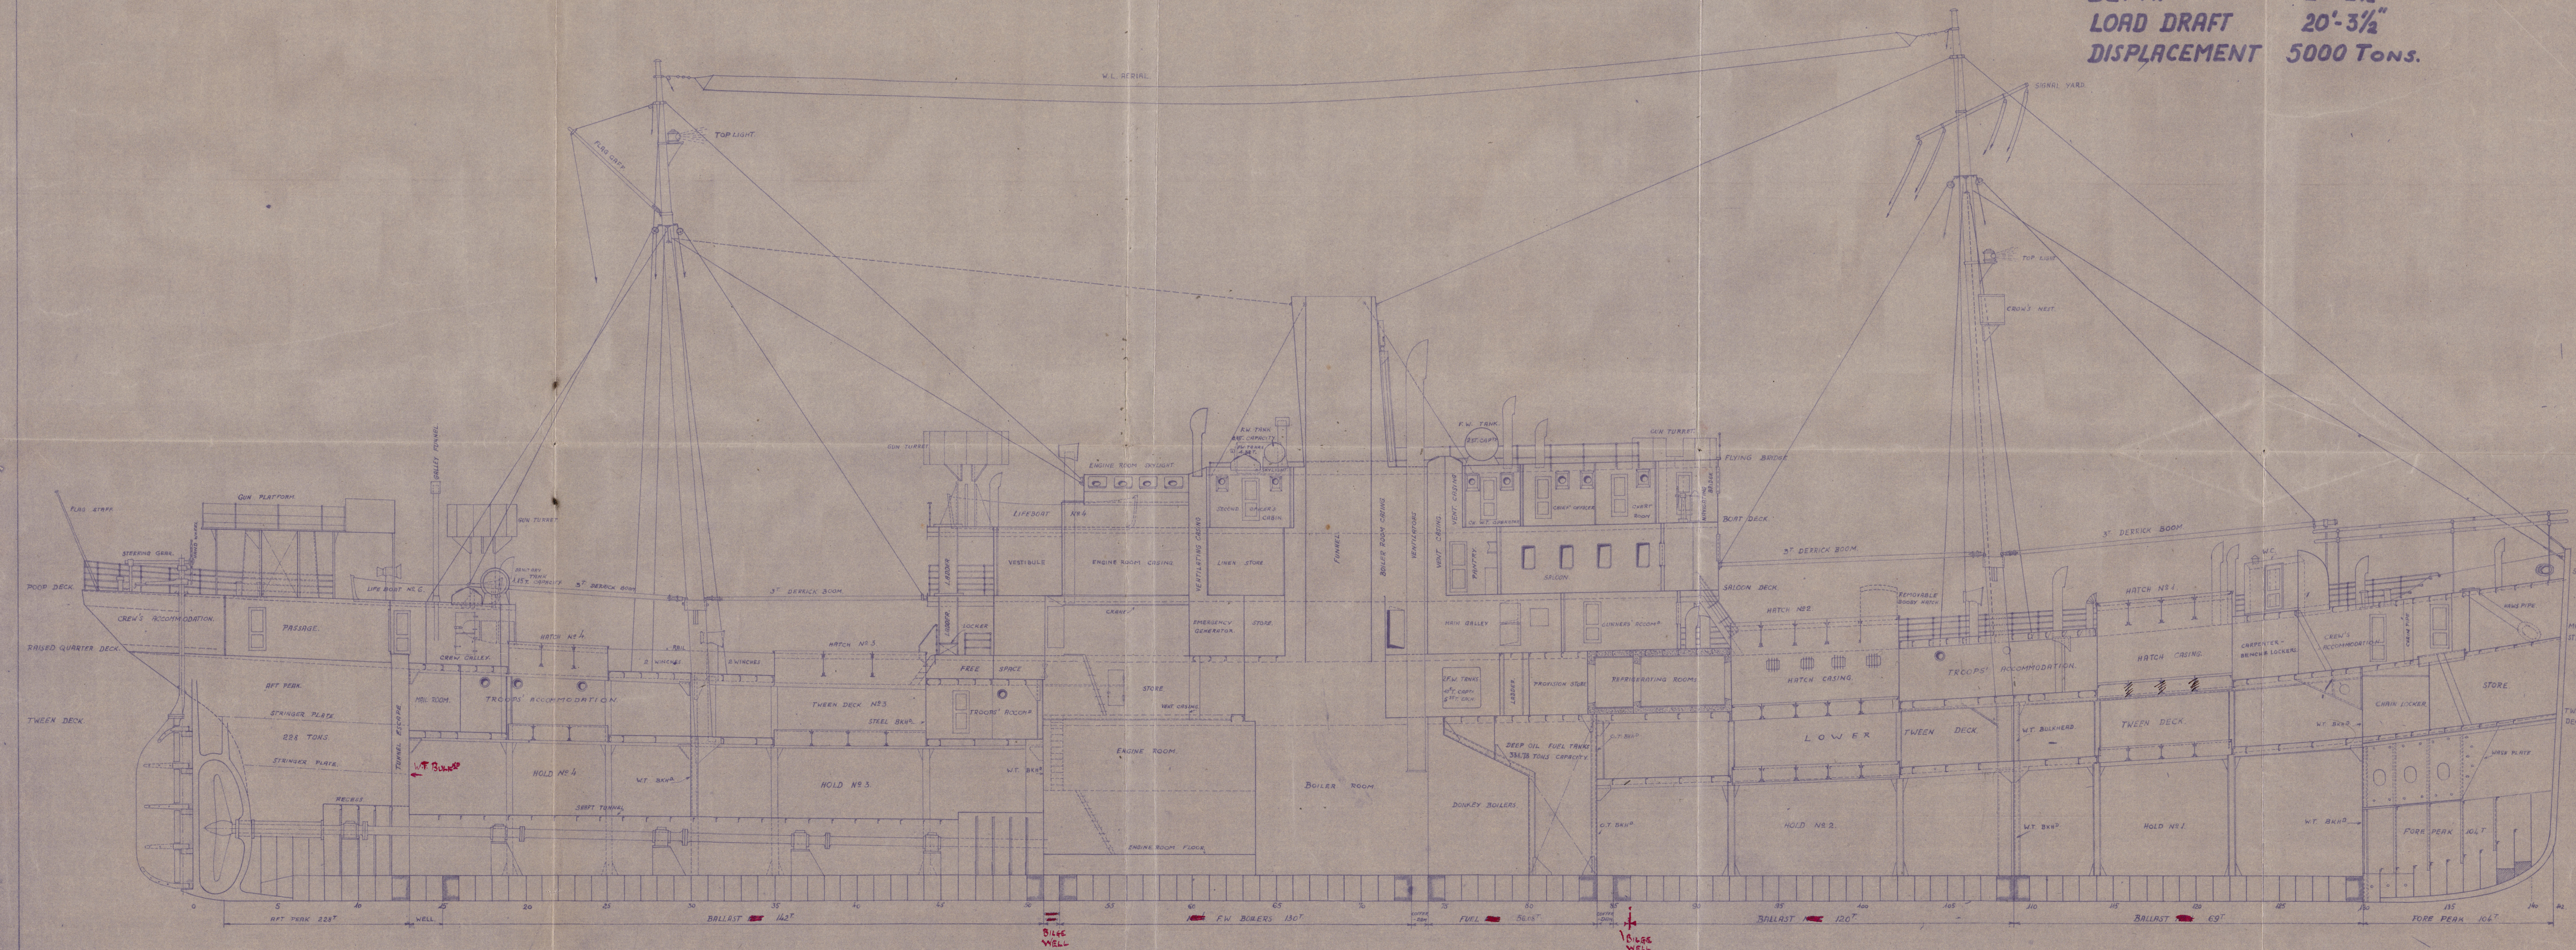

Longitudinal Section.

Dimensions & Capacities Approx. Only.

L. Y. Melvin



SHIPWRIGHTS & ENGINEERS
Job No. 23-ss. TRIPOLITANIA
Longitudinal Section.
Date 4-8-44 Scale 1/8" = 1'-0"
Surveyed, drawn & traced by *L. Y. Melvin*
A-26

"Tripolitania."

Longitudinal Section
Prod rept No. 3156.

006749-006759-0214



© 2021

Lloyd's Register
Foundation