

4/12/17

# THE DOCK

NORTHWICH

DETAIL OF RUDDER FOR S.S. PERONNE.

SKETCH N<sup>o</sup> 680

SEPTEMBER 5<sup>TH</sup> 1917.

Don Nov 21<sup>st</sup> 1917

Steering arrangements to Surveyors  
satisfaction. Requirements of Sec. 115  
of the Rules to be complied with  
DECH.

14.3 TOTAL LENGTH OF FINGER STOCK.

66/

---

3-12-17

Sam.  
11/17

W. J. Yarwood & Sons

No 244

5/5 "Perome"

Rudder



Liv Rpt No 77502



© 2021

Lloyd's Register  
Foundation

006749-006759-0269

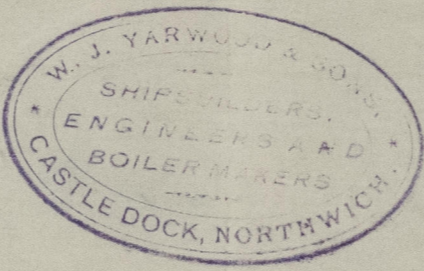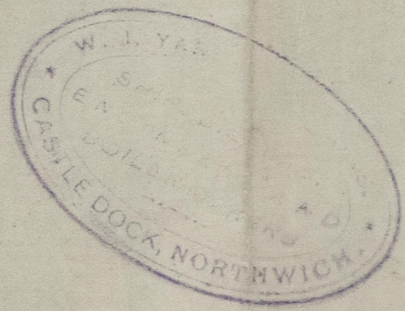

006749-006759-0269



© 2021

Lloyd's Register  
Foundation